
ABERNATHY and ASSOCIATES

Kenneth B. Abernathy Jr.
Wisconsin Registered Land Surveyor S-1594

W4056 Bray Road Elkhorn, Wisconsin 53121 Phone: (414) 723-4260 (office) (414) 723-4813 (residence)

PLAT OF SURVEY

Lot 9 of Block 3 of Edgewood 2nd Addition Subdivision, located in the West 1/2 of the Northeast 1/4 of Section 36, Town 3 North, Range 16 East, City of Elkhorn, County of Walworth, State of Wisconsin.

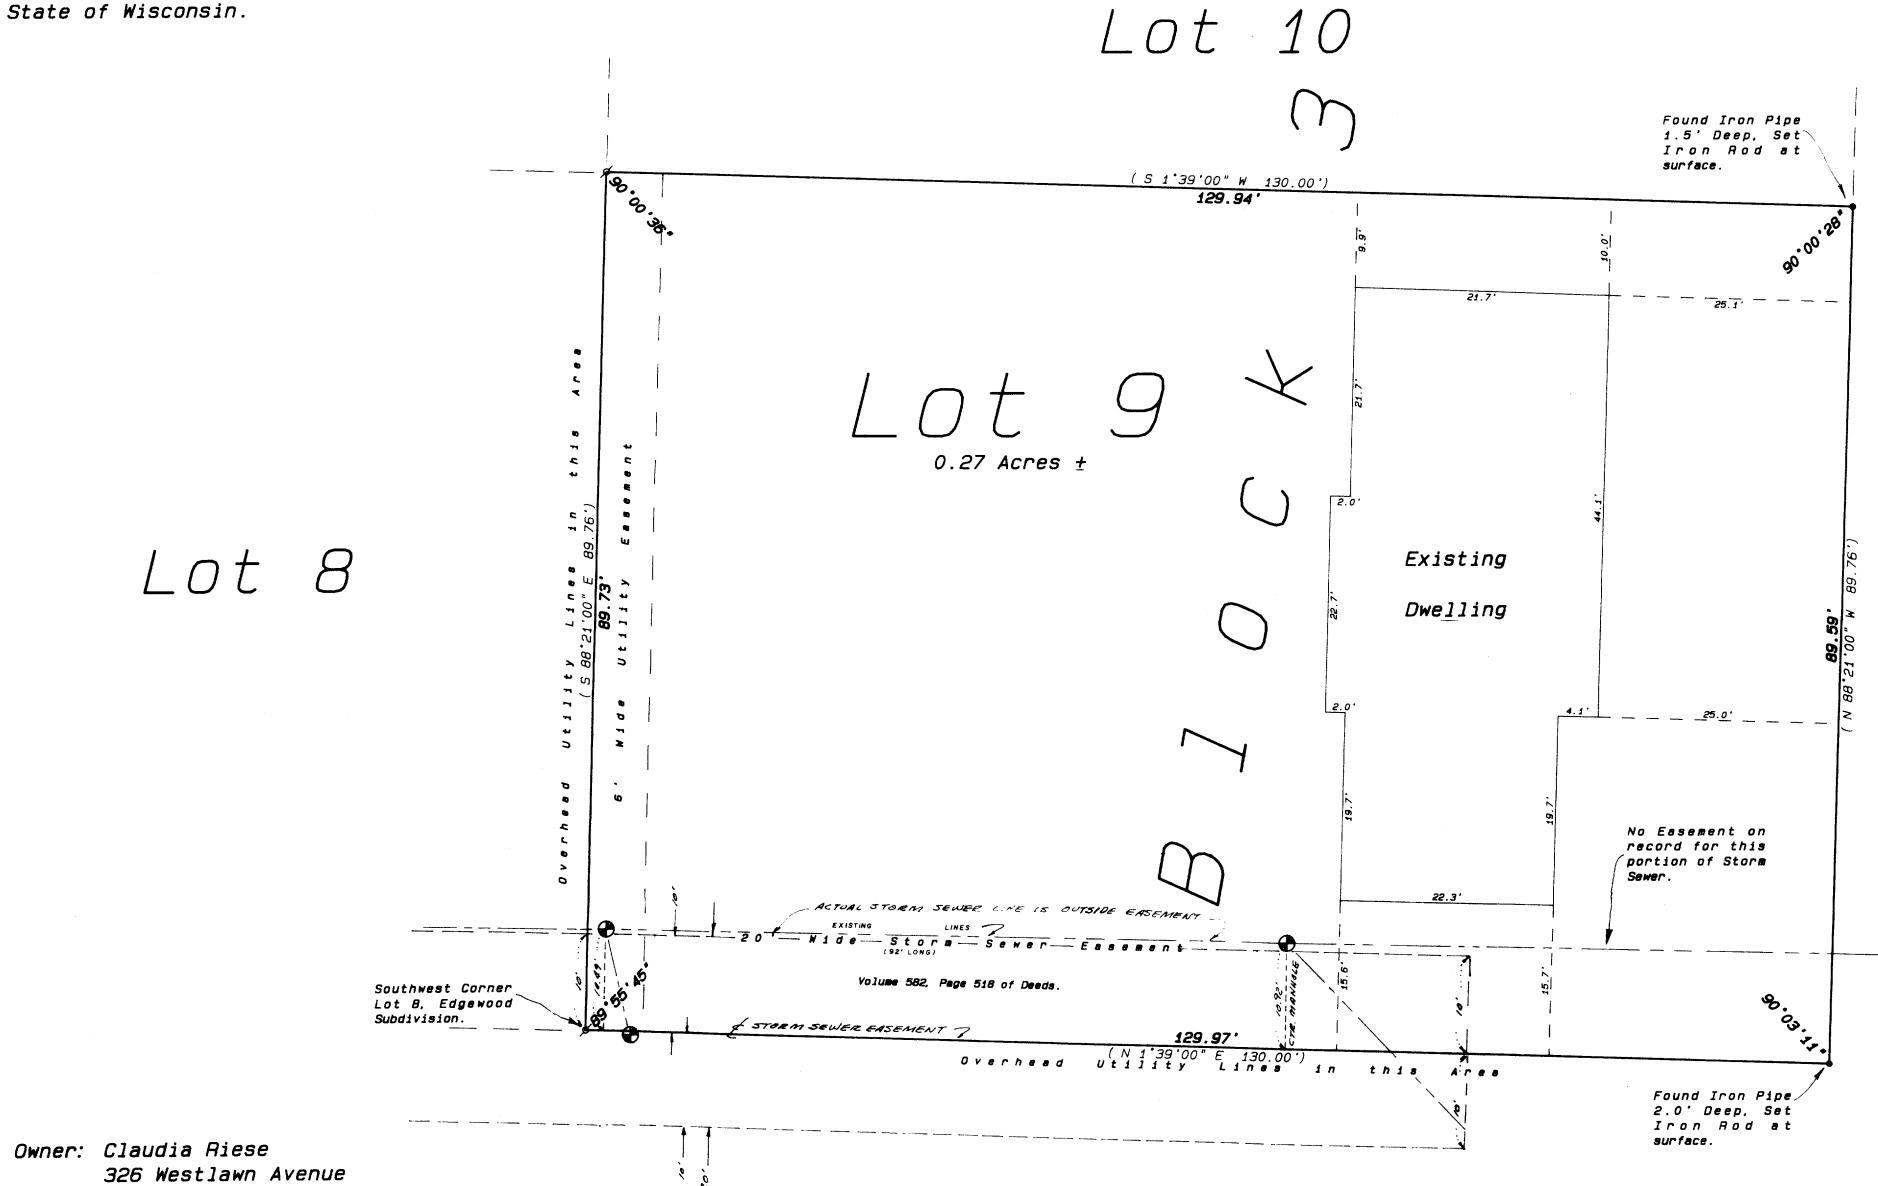

Westlawn Avenue

APR I 5 1994

Legend

FOUND IRON PIPE

FOUND IRON ROD

FOUND BRASS CAPPED MONUMENT

FOUND CONCRETE MONUMENT

CHISEL CUT IN CONCRETE
SET IRON ROD, 24" LONG, WEIGHING 1.5 LBS./LINEAL FT., 3/4" DIA.
SET IRON ROD, 30" LONG, WEIGHING 4.5 LBS./LINEAL FT., 1-11/16" DIA.

(xx) \* RECORDED AS DIMENSION

STORM SEWER MANHOLE

CONSTRUCTION OF STREET

SCALE: 1"= 10 FEET

"I hereby certify that the above described property has been surveyed by me or under my direction and that the above map is a true representation thereof and shows the size and location of the property, its exterior boundaries, the location of all visible structures and dimensions of all principal buildings thereon, boundary fences, apparent easements, roadways and visible encroachments, if any."

This survey is made for the use of the present owners of the property, and also those who purchase mortgage, or guarantee the title thereto within one year from date hereof."

KENNETH B. ABERNATHY, JR.
WISCONSIN REGISTERED LAND SURVEYOR,

ZEVISED 8/24/93 S-1594

Date: August 17, 1993 Job No. 1993.806

Ordered by: Van Brown Jr.
Corner Realty
228 Amos Road
Elkhorn, Wisconsin
53121

Elkhorn, Wisconsin

53121

1-6-1