

FARRIS, HANSEN & ASSOCIATES, INC.  
ENGINEERING, ARCHITECTURE, SURVEYING  
7 RIDGEWAY COURT - P.O. BOX 437, ELKHORN, WISCONSIN 53121  
PHONE: (414) 723-2098 FAX: (414) 723-5886


PLAT OF SURVEY

LOT 3 OF BLOCK 30 OF ROCKWELL'S ADDITION  
TO THE CITY OF ELKHORN, WALWORTH COUNTY,  
WISCONSIN

WORK ORDERED BY:  
DAVID SCUREK  
107 S. CHURCH STREET  
ELKHORN, WISCONSIN

LEGEND  
= SET IRON REBAR STAKE  
O = FOUND IRON PIPE STAKE  
(---) = RECORDED AS


ASSIGNED EAST LINE S. CHURCH STREET  
N 00 02' 24" W

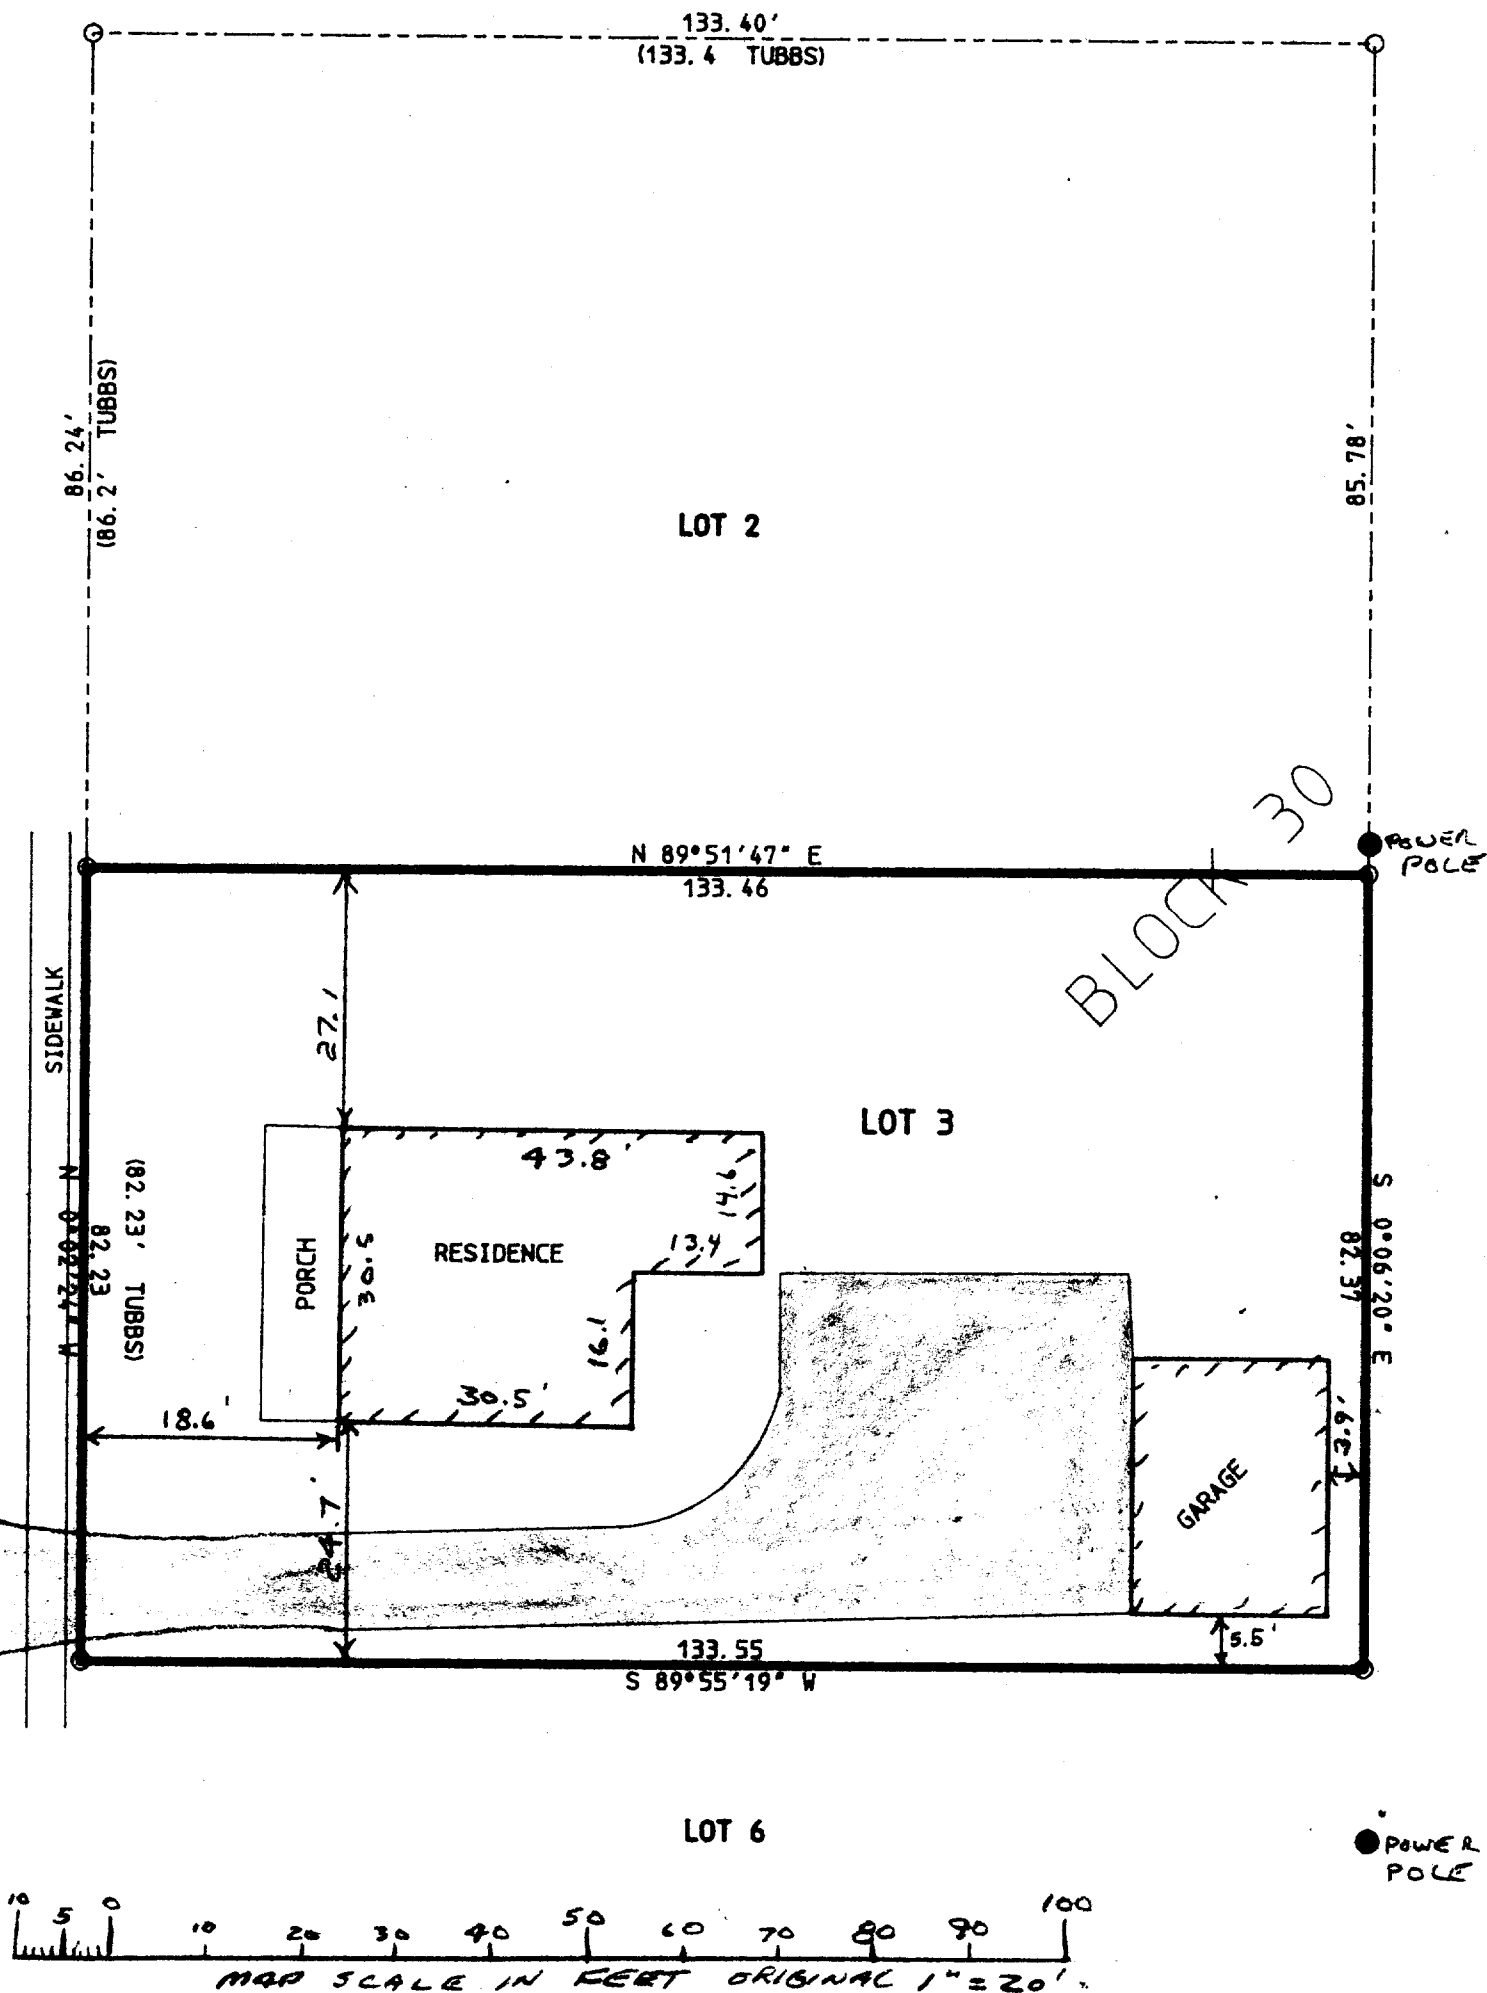


NOTE: COPIES OF THIS MAP TO WHICH THE FOLLOWING CERTIFICATE WILL APPLY ARE BLUE LINE PRINTS SHOWING SURVEYOR'S ORIGINAL SEAL AND SIGNATURE IN BLACK INK. COPIES BY ANY OTHER MEANS MAY HAVE ALTERATIONS WHICH DO NOT REPRESENT THE SURVEYOR'S WORK PRODUCT.

I HEREBY CERTIFY THAT THE ABOVE DESCRIBED PROPERTY HAS BEEN SURVEYED UNDER MY DIRECTION AND THAT THE ABOVE MAP IS A TRUE REPRESENTATION THEREOF AND SHOWS THE SIZE AND LOCATION OF THE PROPERTY AND ITS EXTERIOR BOUNDARIES. THIS SURVEY IS MADE FOR THE USE OF THE PRESENT OWNERS OF THE PROPERTY, AND ALSO THOSE WHO PURCHASE, MORTGAGE, OR GUARANTEE THE TITLE THERETO WITHIN ONE YEAR FROM THE DATE HEREOF.

DATED: 5-18-94

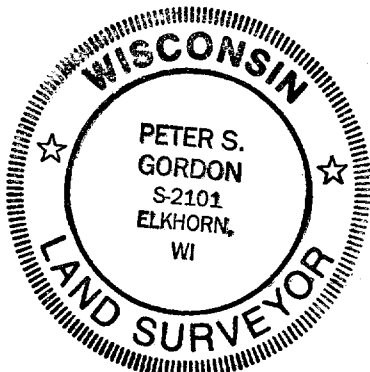

PROJ 4073  
05-18-1994

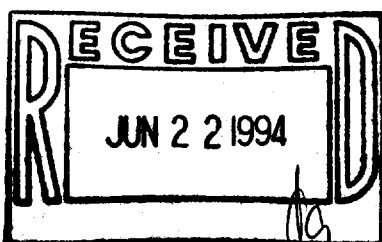

804-872

YRW-38A