


PLAT OF SURVEY
-OF-


LOT 9, RENDON SUBDIVISION, LOCATED IN ALL QUARTERS OF THE NORTHWEST 1/4 OF SECTION 31, TOWN-SHIP 3 NORTH, RANGE 17 EAST IN THE CITY OF ELKHORN, WALWORTH COUNTY, WISCONSIN.

SURVEY FOR: SOUTHEASTERN WISCONSIN HOUSING CORP.

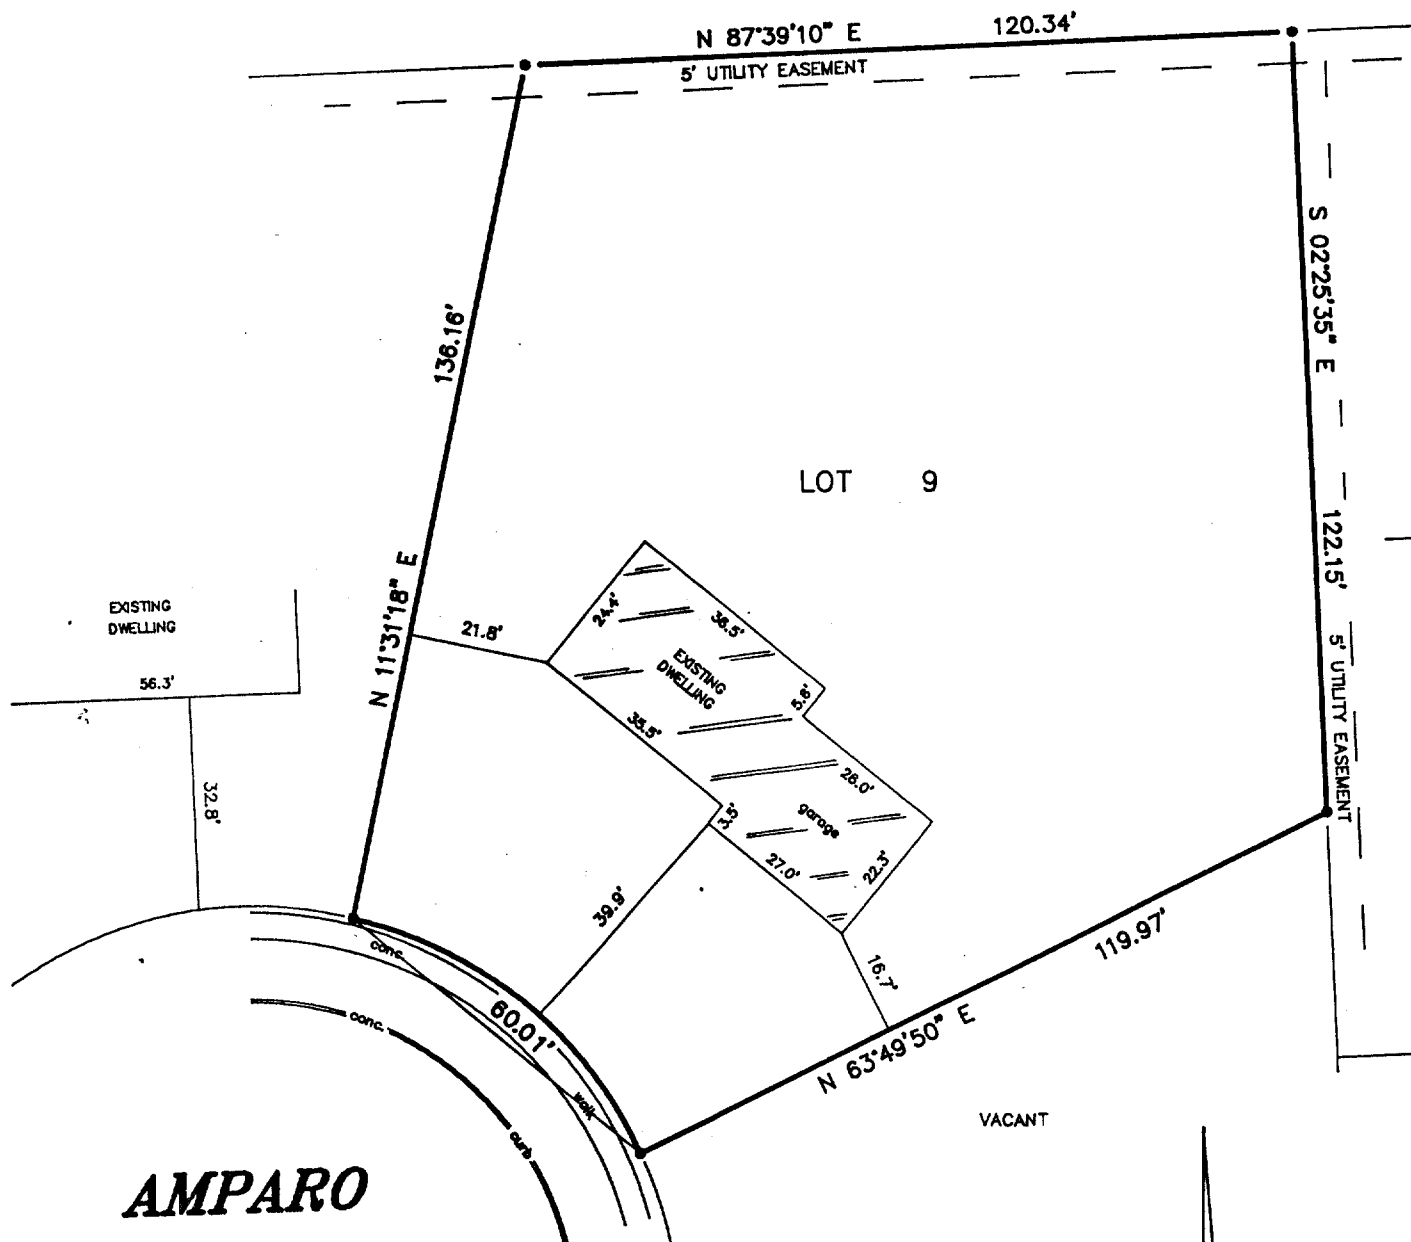


- FOUND IRON ROD
- FOUND IRON PIPE
- SET IRON PIPE

SCALE: 1" = 30'

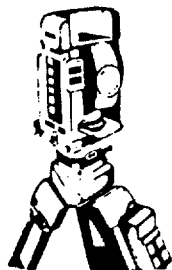

B.W. SURVEYING
Land Surveys
Mapping And Planning
35117 Academy Road
Burlington, Wisconsin 53105
(414) 534-4109

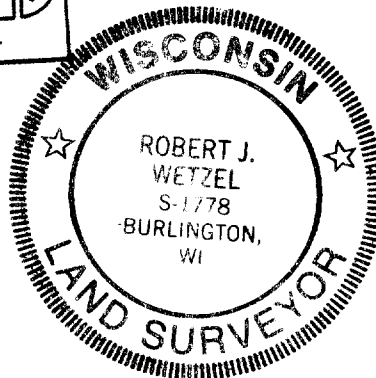

THIS IS NOT AN ORIGINAL PRINT
UNLESS THIS SEAL IS RED

"I hereby certify that I have surveyed the above described property and that the above map is a true representation thereof and shows the size and location of the property, its exterior boundaries, the location of all visible structures and dimensions of all principal buildings thereon, boundary fences, apparent easements, roadways and encroachments, if any."

"This survey is made for the use of the present owners of the property, and those who purchase, mortgage, or guarantee the title thereto within one year from date hereof."

Robert J. Wetzel
ROBERT J. WETZEL
REGISTERED LAND SURVEYOR - 1778

10/22/93
DATE

Revised: 2/21/94

1138 B
JOB NUMBER



004-878

VRE-9

PLAT OF SURVEY
-OF-

LOT 9, RENDON SUBDIVISION, LOCATED IN ALL QUARTERS OF THE NORTHWEST 1/4 OF SECTION 31, TOWN-SHIP 3 NORTH, RANGE 17 EAST IN THE CITY OF ELKHORN, WALWORTH COUNTY, WISCONSIN.


SURVEY FOR: SOUTHEASTERN WISCONSIN HOUSING CORP.

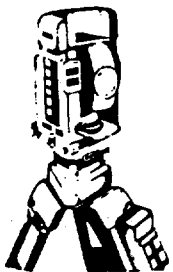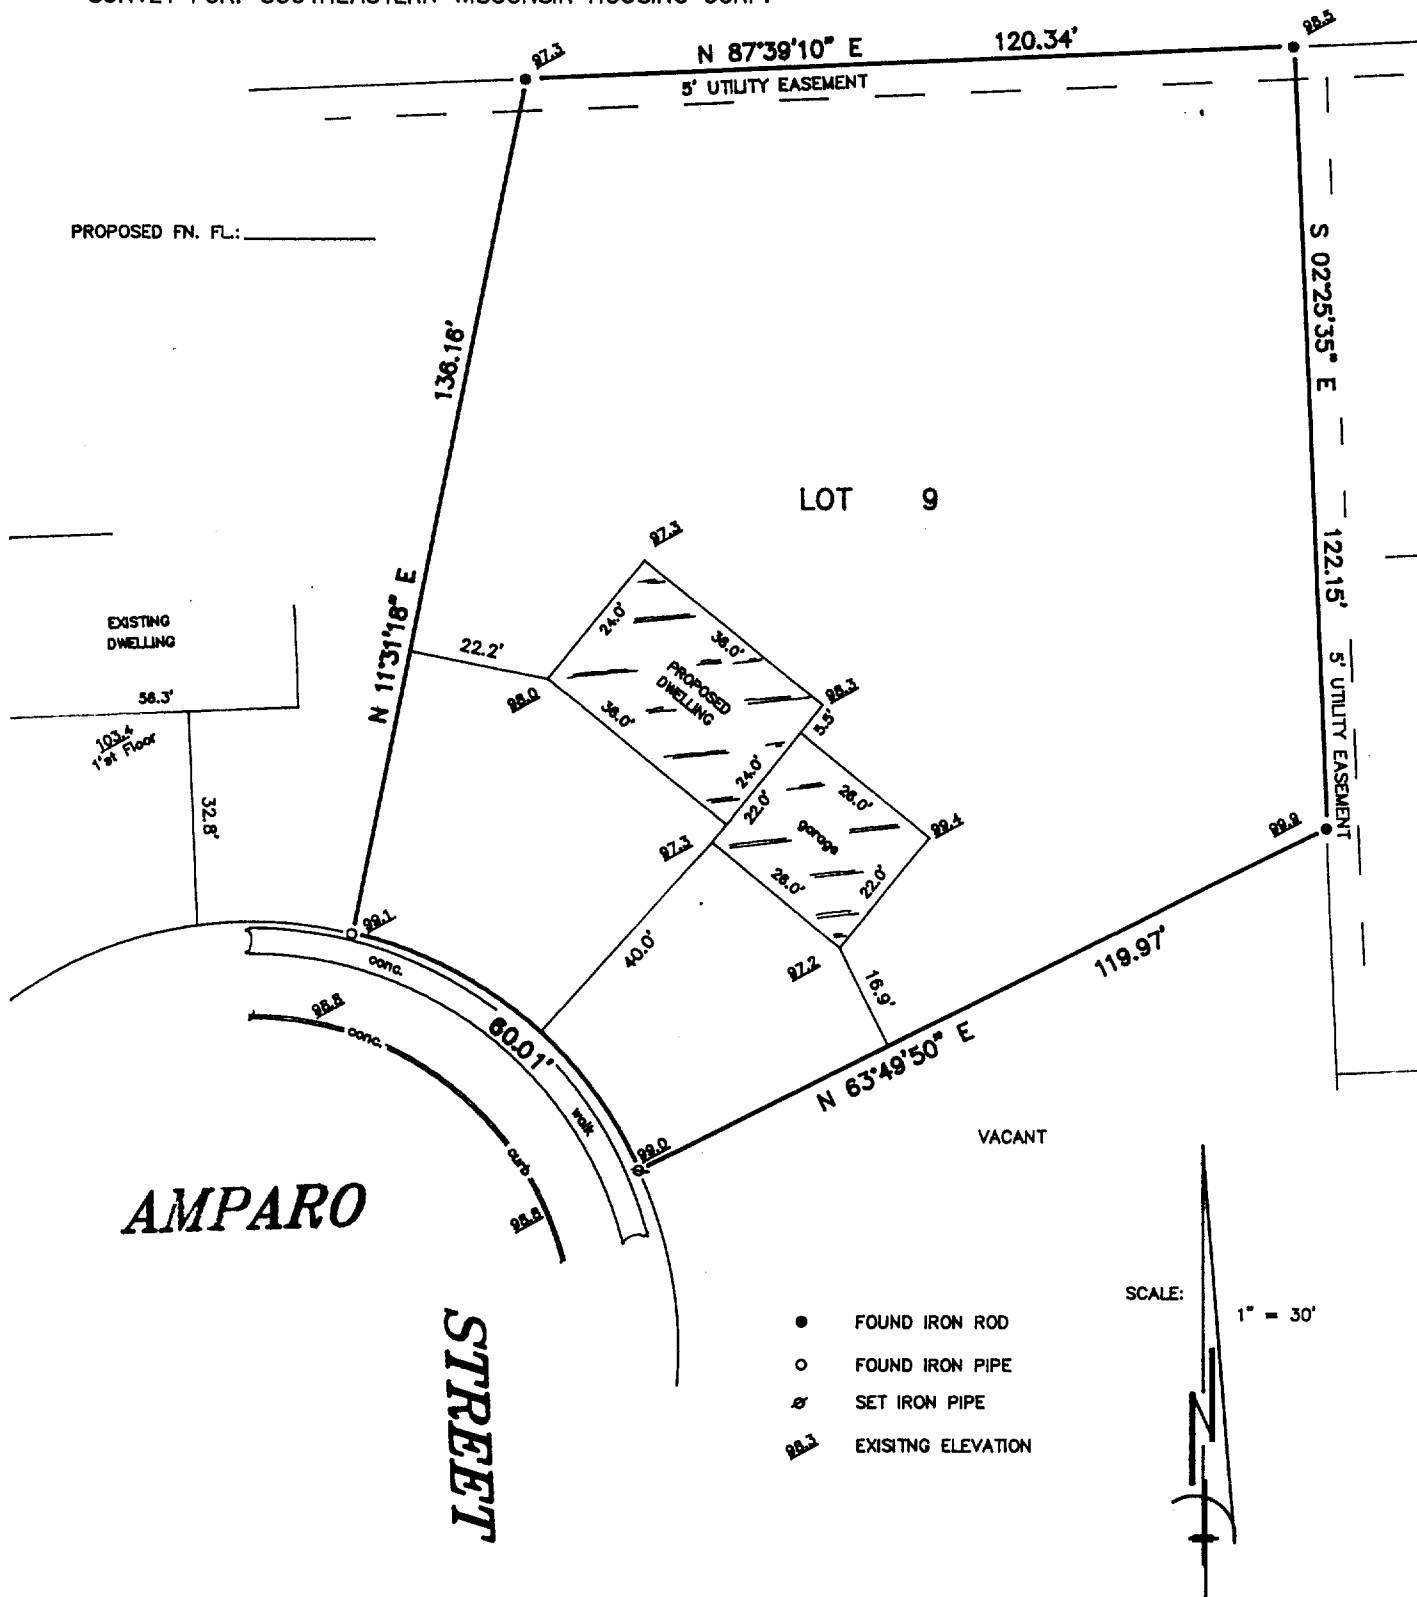

B.W. SURVEYING

Land Surveys
Mapping And Planning
35117 Academy Road
Burlington, Wisconsin 53105
(414) 534-4109

PROPOSED HOUSE WAS STAKED ON ACTUAL CORNERS WITH 5 FOOT CONTROL ON THE LONGEST HOUSE LINE. THE CONTRACTOR WILL BE RESPONSIBLE TO FIELD VERIFY ALL STAKES FOR LOCATION AND DIMENSION PRIOR TO CONSTRUCTION. IF ANY DISCREPANCIES OCCUR, NOTIFY THIS OFFICE AT ONCE.

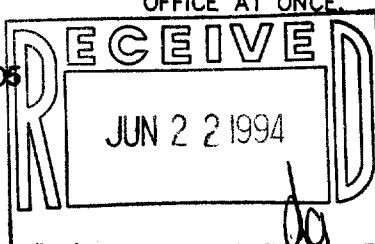

"I hereby certify that I have surveyed the above described property and that the above map is a true representation thereof and shows the size and location of the property, its exterior boundaries, the location of all visible structures and dimensions of all principal buildings thereon, boundary fences, apparent easements, roadways and encroachments, if any."

"This survey is made for the use of the present owners of the property, and those who purchase, mortgage, or guarantee the title thereto within one year from date hereof."

THIS IS NOT AN ORIGINAL PRINT
UNLESS THIS SEAL IS RED

Robert J. Wetzel
ROBERT J. WETZEL
REGISTERED LAND SURVEYOR - 1778

16/22/93
DATE

1138 B
JOB NUMBER