


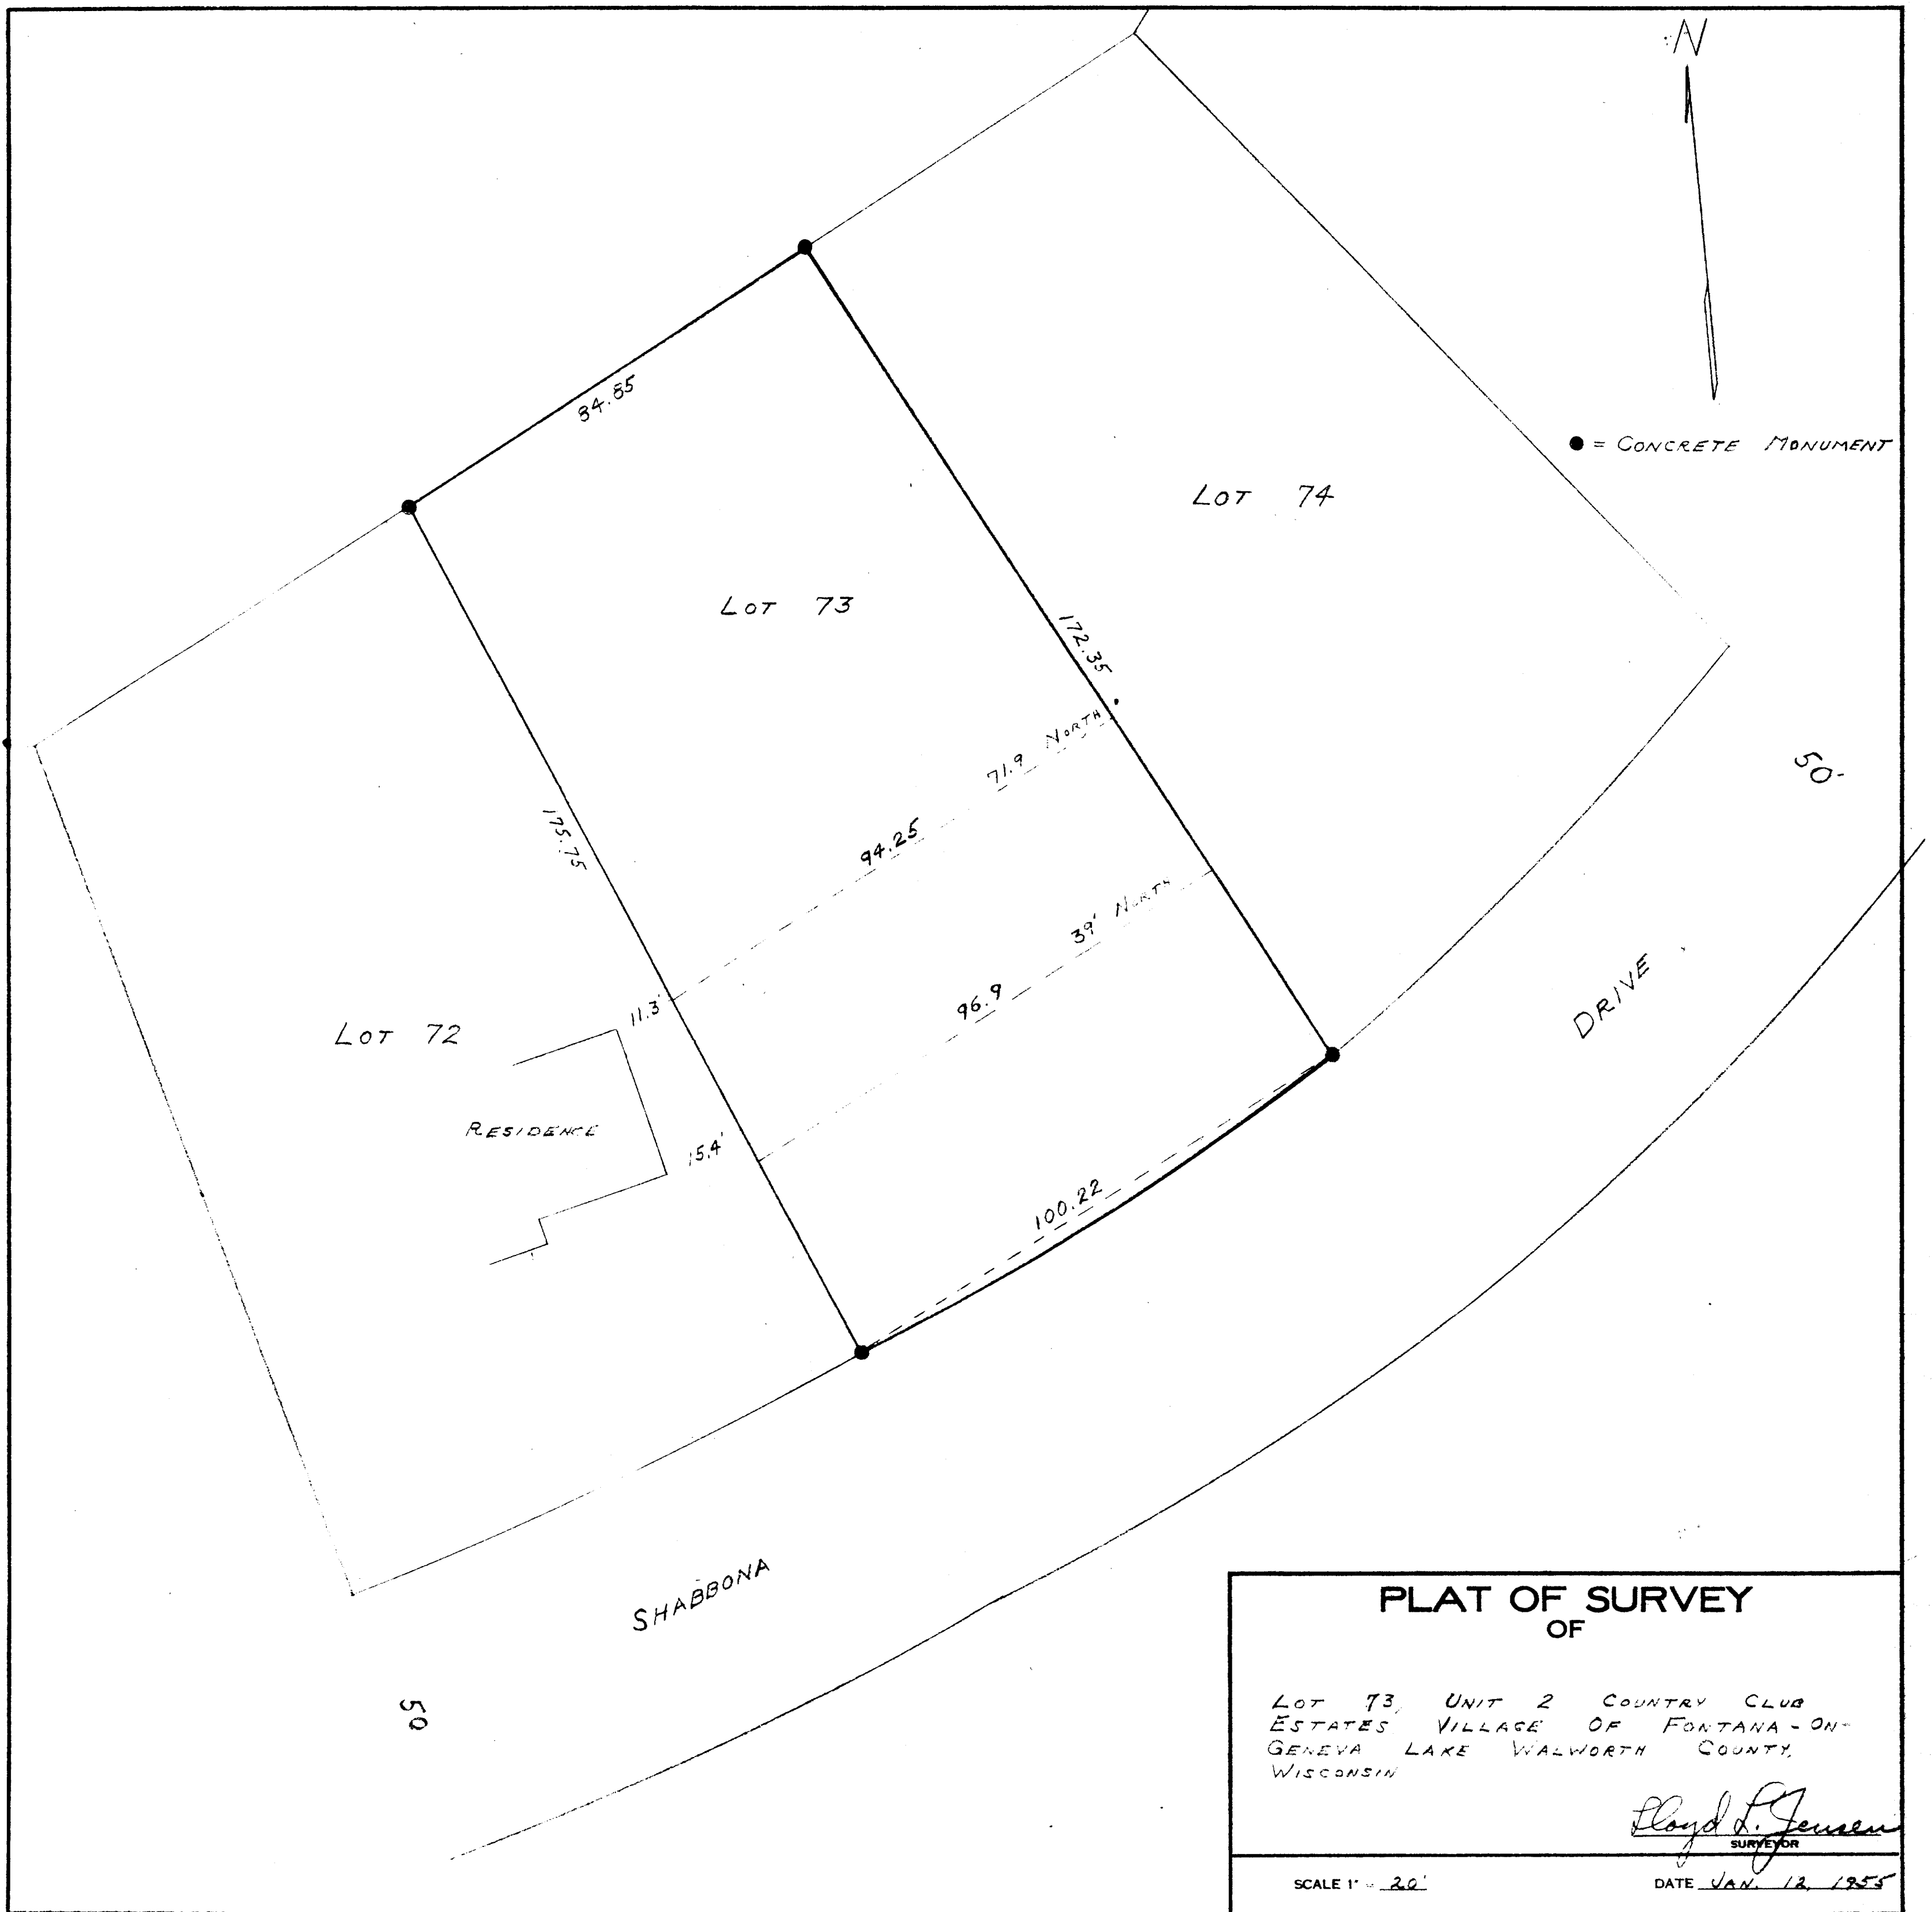

**PLAT OF SURVEY  
OF**

LOT 73, UNIT 2 COUNTRY CLUB  
ESTATES VILLAGE OF FONTANA - ON -  
GENEVA LAKE WALWORTH COUNTY,  
WISCONSIN

*Lloyd L. Jensen*  
SURVEYOR

SCALE 1" = 20'

DATE JAN. 12, 1955

5-100J