


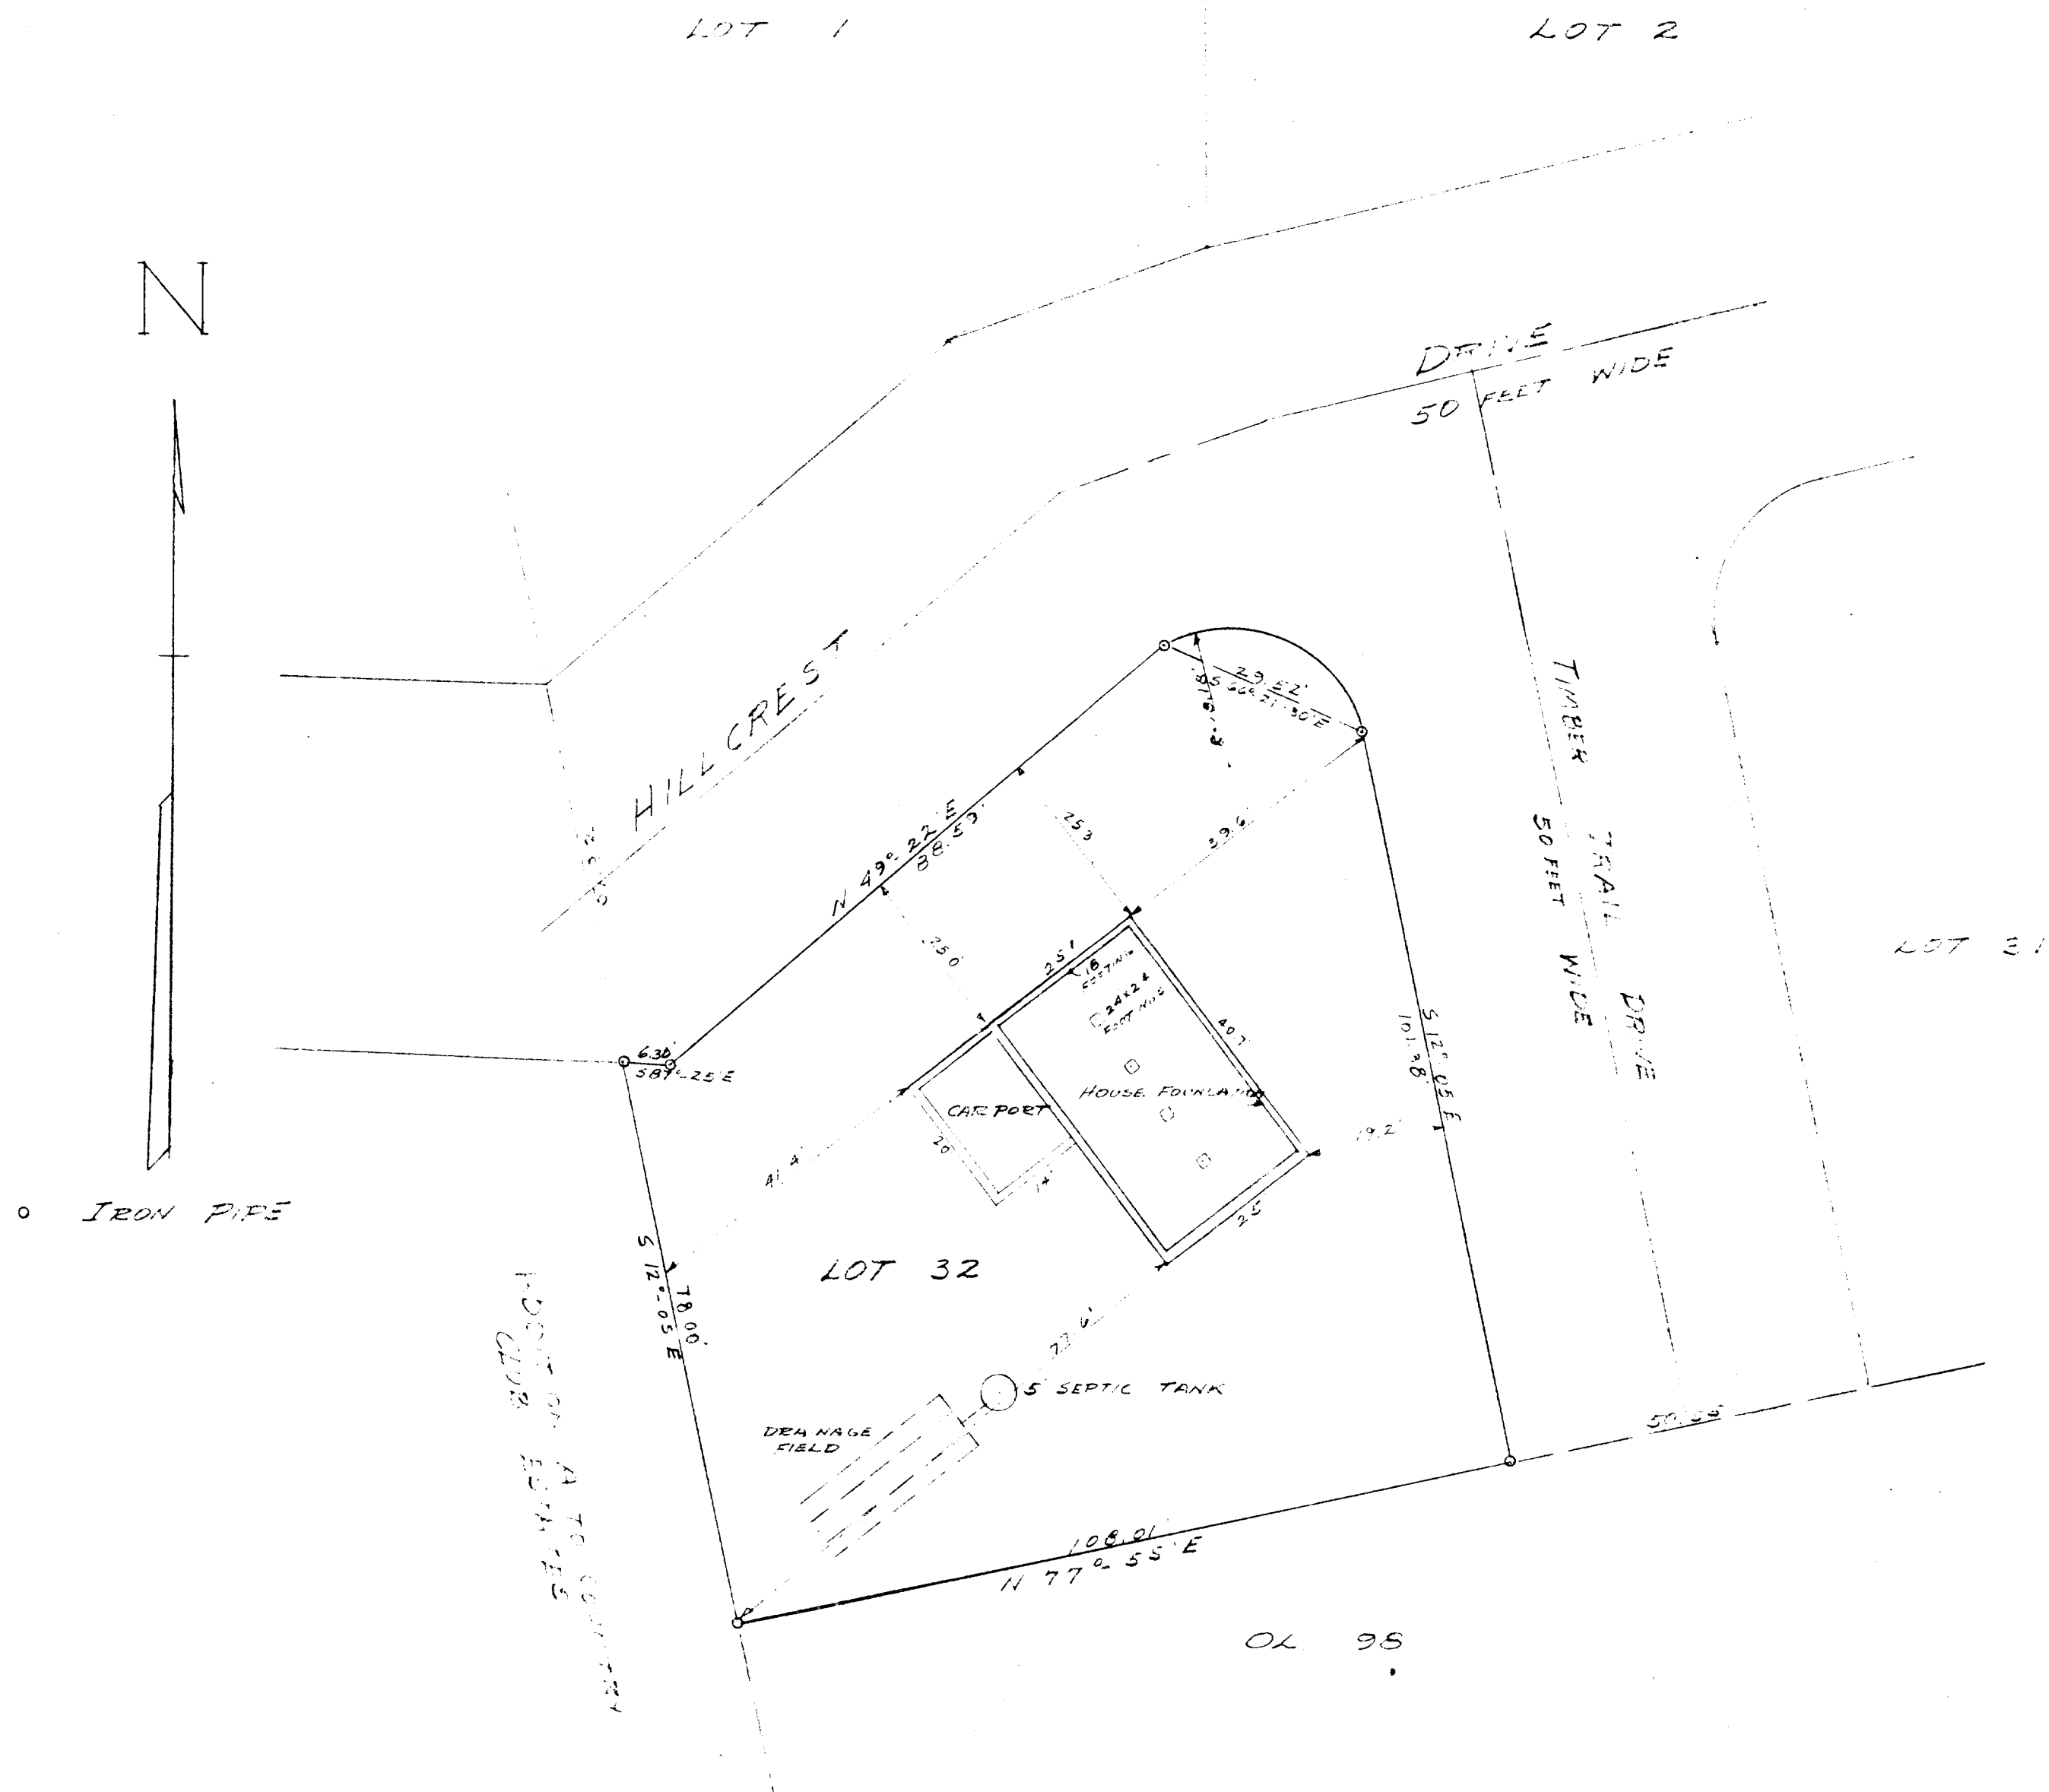

STATE OF WISCONSIN) ss
COUNTY OF WALWORTH)

I, LLOYD L. JENSEN, DO HEREBY CERTIFY THAT I HAVE SURVEYED THE PROPERTY DESCRIBED HEREON ACCORDING TO THE OFFICIAL RECORDS, AND THAT THE PLAT HEREON IS A CORRECT REPRESENTATION OF THE LOT LINES AND PRINCIPAL LINES OF BUILDINGS THEREON.

ELKHORN, WISCONSIN DECEMBER 16 1954

Lloyd L. Jensen
SURVEYOR

PLAT OF SURVEY OF

LOT 32 OF ADDITION "D"
TO COUNTRY CLUB ESTATES
LOCATED IN THE

VILLAGE OF FONTANA-ON GENEVA LAKE
WALWORTH COUNTY, WISCONSIN

Lloyd L. Jensen
SURVEYOR

SCALE 1" = 20'

DATE DEC. 16, 1954

SCTD-33