


LOT K OF THE GARDENS SECOND ADDITION,
EXCEPT A PORTION THEREOF BEGINNING AT
THE NORTHWEST CORNER OF LOT J, THENCE
SOUTHERLY 63.6 FEET; THENCE EASTERLY
TO THE EAST LINE OF LOT K; THENCE
NORTHERLY TO THE NORTH LINE OF THE
GARDENS SUBDIVISION NO. 2; THENCE
N59°30'W 134 FEET, MORE OR LESS, TO
THE POINT OF BEGINNING. SAID LAND BEING
LOCATED IN THE VILLAGE OF FONTANA,
WALWORTH COUNTY, WISCONSIN.

ORDERED BY: REALTY WORLD-TAGGART
756 MAIN STREET
LAKE GENEVA, WISCONSIN
53147

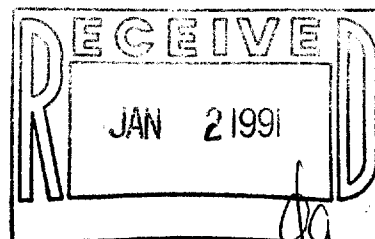

✓-IRON PIPE FOUND
()-RECORDED AS

I HEREBY CERTIFY THAT I HAVE SURVEYED THE ABOVE DESCRIBED PROPERTY AND THAT THE ABOVE MAP IS A TRUE REPRESENTATION THEREOF AND SHOWS THE SIZE AND LOCATION OF THE PROPERTY, ITS EXTERIOR BOUNDARIES, THE LOCATION OF ALL VISIBLE STRUCTURES AND DIMENSIONS OF ALL PRINCIPAL BUILDINGS THEREON, BOUNDARY FENCES, APPARENT EASEMENTS AND ROADWAYS AND VISIBLE ENCROACHMENTS, IF ANY.

THIS SURVEY IS MADE FOR THE EXCLUSIVE USE OF THE PRESENT OWNERS OF THE PROPERTY, AND ALSO THOSE WHO PURCHASE, MORTGAGE, OR GUARANTEE THE TITLE THERETO WITHIN ONE (1) YEAR FROM DATE HEREOF.

ROBERT M. BAERENWALD
WISCONSIN REGISTERED LAND SURVEYOR, S-1508

DATE Aug. 19, 1951 JOB NO. 2108

NOTE: THIS IS NOT A CERTIFIED COPY UNLESS SEALED.