


The site plan shows a property bounded by a wire fence on the left and a gravel parking area on the right. The property is divided into three main sections: a large central area labeled '9', a smaller area labeled '10' containing a 'HOUSE' and a 'SHED', and a small area labeled '11' at the bottom. The 'HOUSE' is a complex polygon with several internal dimensions: 24.3' on the left, 12' on the top-left, 24.2' on the top, 9.4' on the top-right, 8' on the right, 10' on the bottom-right, 12.7' on the bottom, 3.5' on the bottom-left, and 36.2' on the left. The 'SHED' is a small rectangle measuring 10' by 10'. The gravel parking area is a dashed rectangle measuring 25' by 25'. The property is bounded by a wire fence on the left, with dimensions 49.88' (50') on the top and 49.88' (50') on the bottom. The top boundary is 151.60' and the bottom boundary is 145.00'. The right boundary is 82°21' and 97°46'. The total length of the right boundary is 50.00'. The area is labeled 'AWEOGON ROAD' on the right side.

LOT 10, BLOCK 6 OF INDIAN HILLS SUBDIVISION,
LOCATED IN THE VILLAGE OF FONTANA-ON-GENEVA
LAKE, WALWORTH COUNTY, WISCONSIN.



ORDERED BY: ANDREW F. ALLEN
527 CENTER STREET
LAKE GENEVA, WISCONSIN
53147

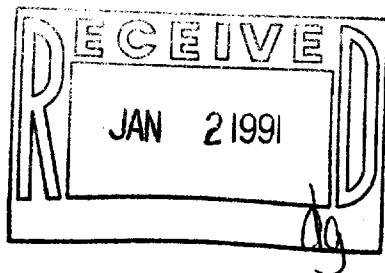

I HEREBY CERTIFY THAT I HAVE SURVEYED THE ABOVE DESCRIBED PROPERTY AND THAT THE ABOVE MAP IS A TRUE REPRESENTATION THEREOF AND SHOWS THE SIZE AND LOCATION OF THE PROPERTY, ITS EXTERIOR BOUNDARIES, THE LOCATION OF ALL VISIBLE STRUCTURES AND DIMENSIONS OF ALL PRINCIPAL BUILDINGS THEREON, BOUNDARY FENCES, APPARENT EASEMENTS AND ROADWAYS AND VISIBLE ENCROACHMENTS, IF ANY.

THIS SURVEY IS MADE FOR THE EXCLUSIVE USE OF THE PRESENT OWNERS OF THE PROPERTY, AND ALSO THOSE WHO PURCHASE, MORTGAGE, OR GUARANTEE THE TITLE THERETO WITHIN ONE (1) YEAR FROM DATE HEREOF.

- Robert M. Baerenwald
ROBERT M. BAERENWALD
WISCONSIN REGISTERED LAND SURVEYOR, S-1508

DATE Aug. 11, 1951 JOB NO. 2087

NOTE: THIS IS NOT A CERTIFIED COPY UNLESS SEALED.