


22

N 43° 14' E 116.32
16.3

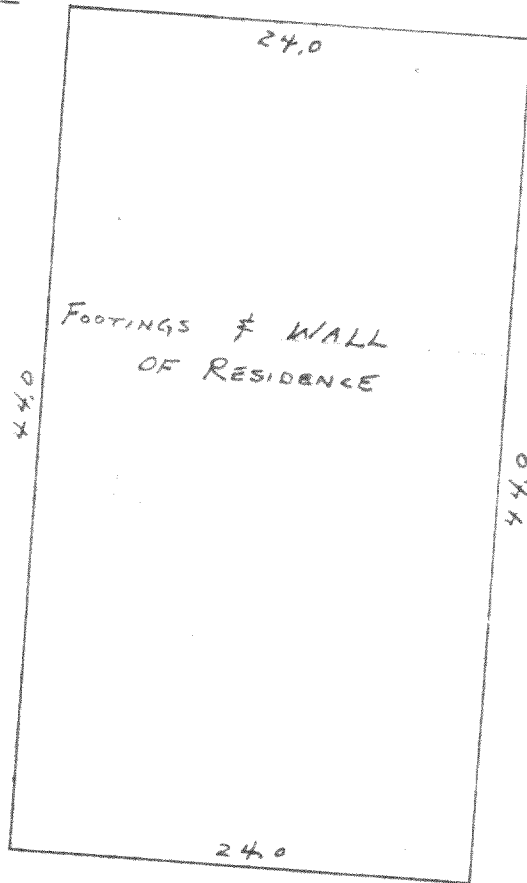

LOT 21

50'

WOODLAND DRIVE

N

• - CONCRETE MONUMENT
○ - IRON PIPE

STATE OF WISCONSIN) SS
COUNTY OF WALWORTH)

I, LLOYD L. JENSEN, DO HEREBY
CERTIFY THAT I HAVE SURVEYED THE
PROPERTY DESCRIBED HEREON ACCORDING TO
THE OFFICIAL RECORDS, AND THAT THE
PLAT HEREON IS A CORRECT REPRESENTATION
OF THE LOT LINES AND PRINCIPAL LINES
OF BUILDINGS THEREON.

ELKHORN, WISCONSIN NOVEMBER, 1954

Lloyd L. Jensen
SURVEYOR

PLAT OF SURVEY
OF

LOT 21 OF ADDITION D
TO COUNTRY CLUB ESTATES
LOCATED IN THE
VILLAGE OF FONTANA-ON-GENEVA LAKE
WALWORTH COUNTY, WISCONSIN

Lloyd L. Jensen
SURVEYOR

SCALE 1" = 10'

DATE Nov. 1954

SCTD-22

NO. 177H-400-3-10-53

FOREST DR