


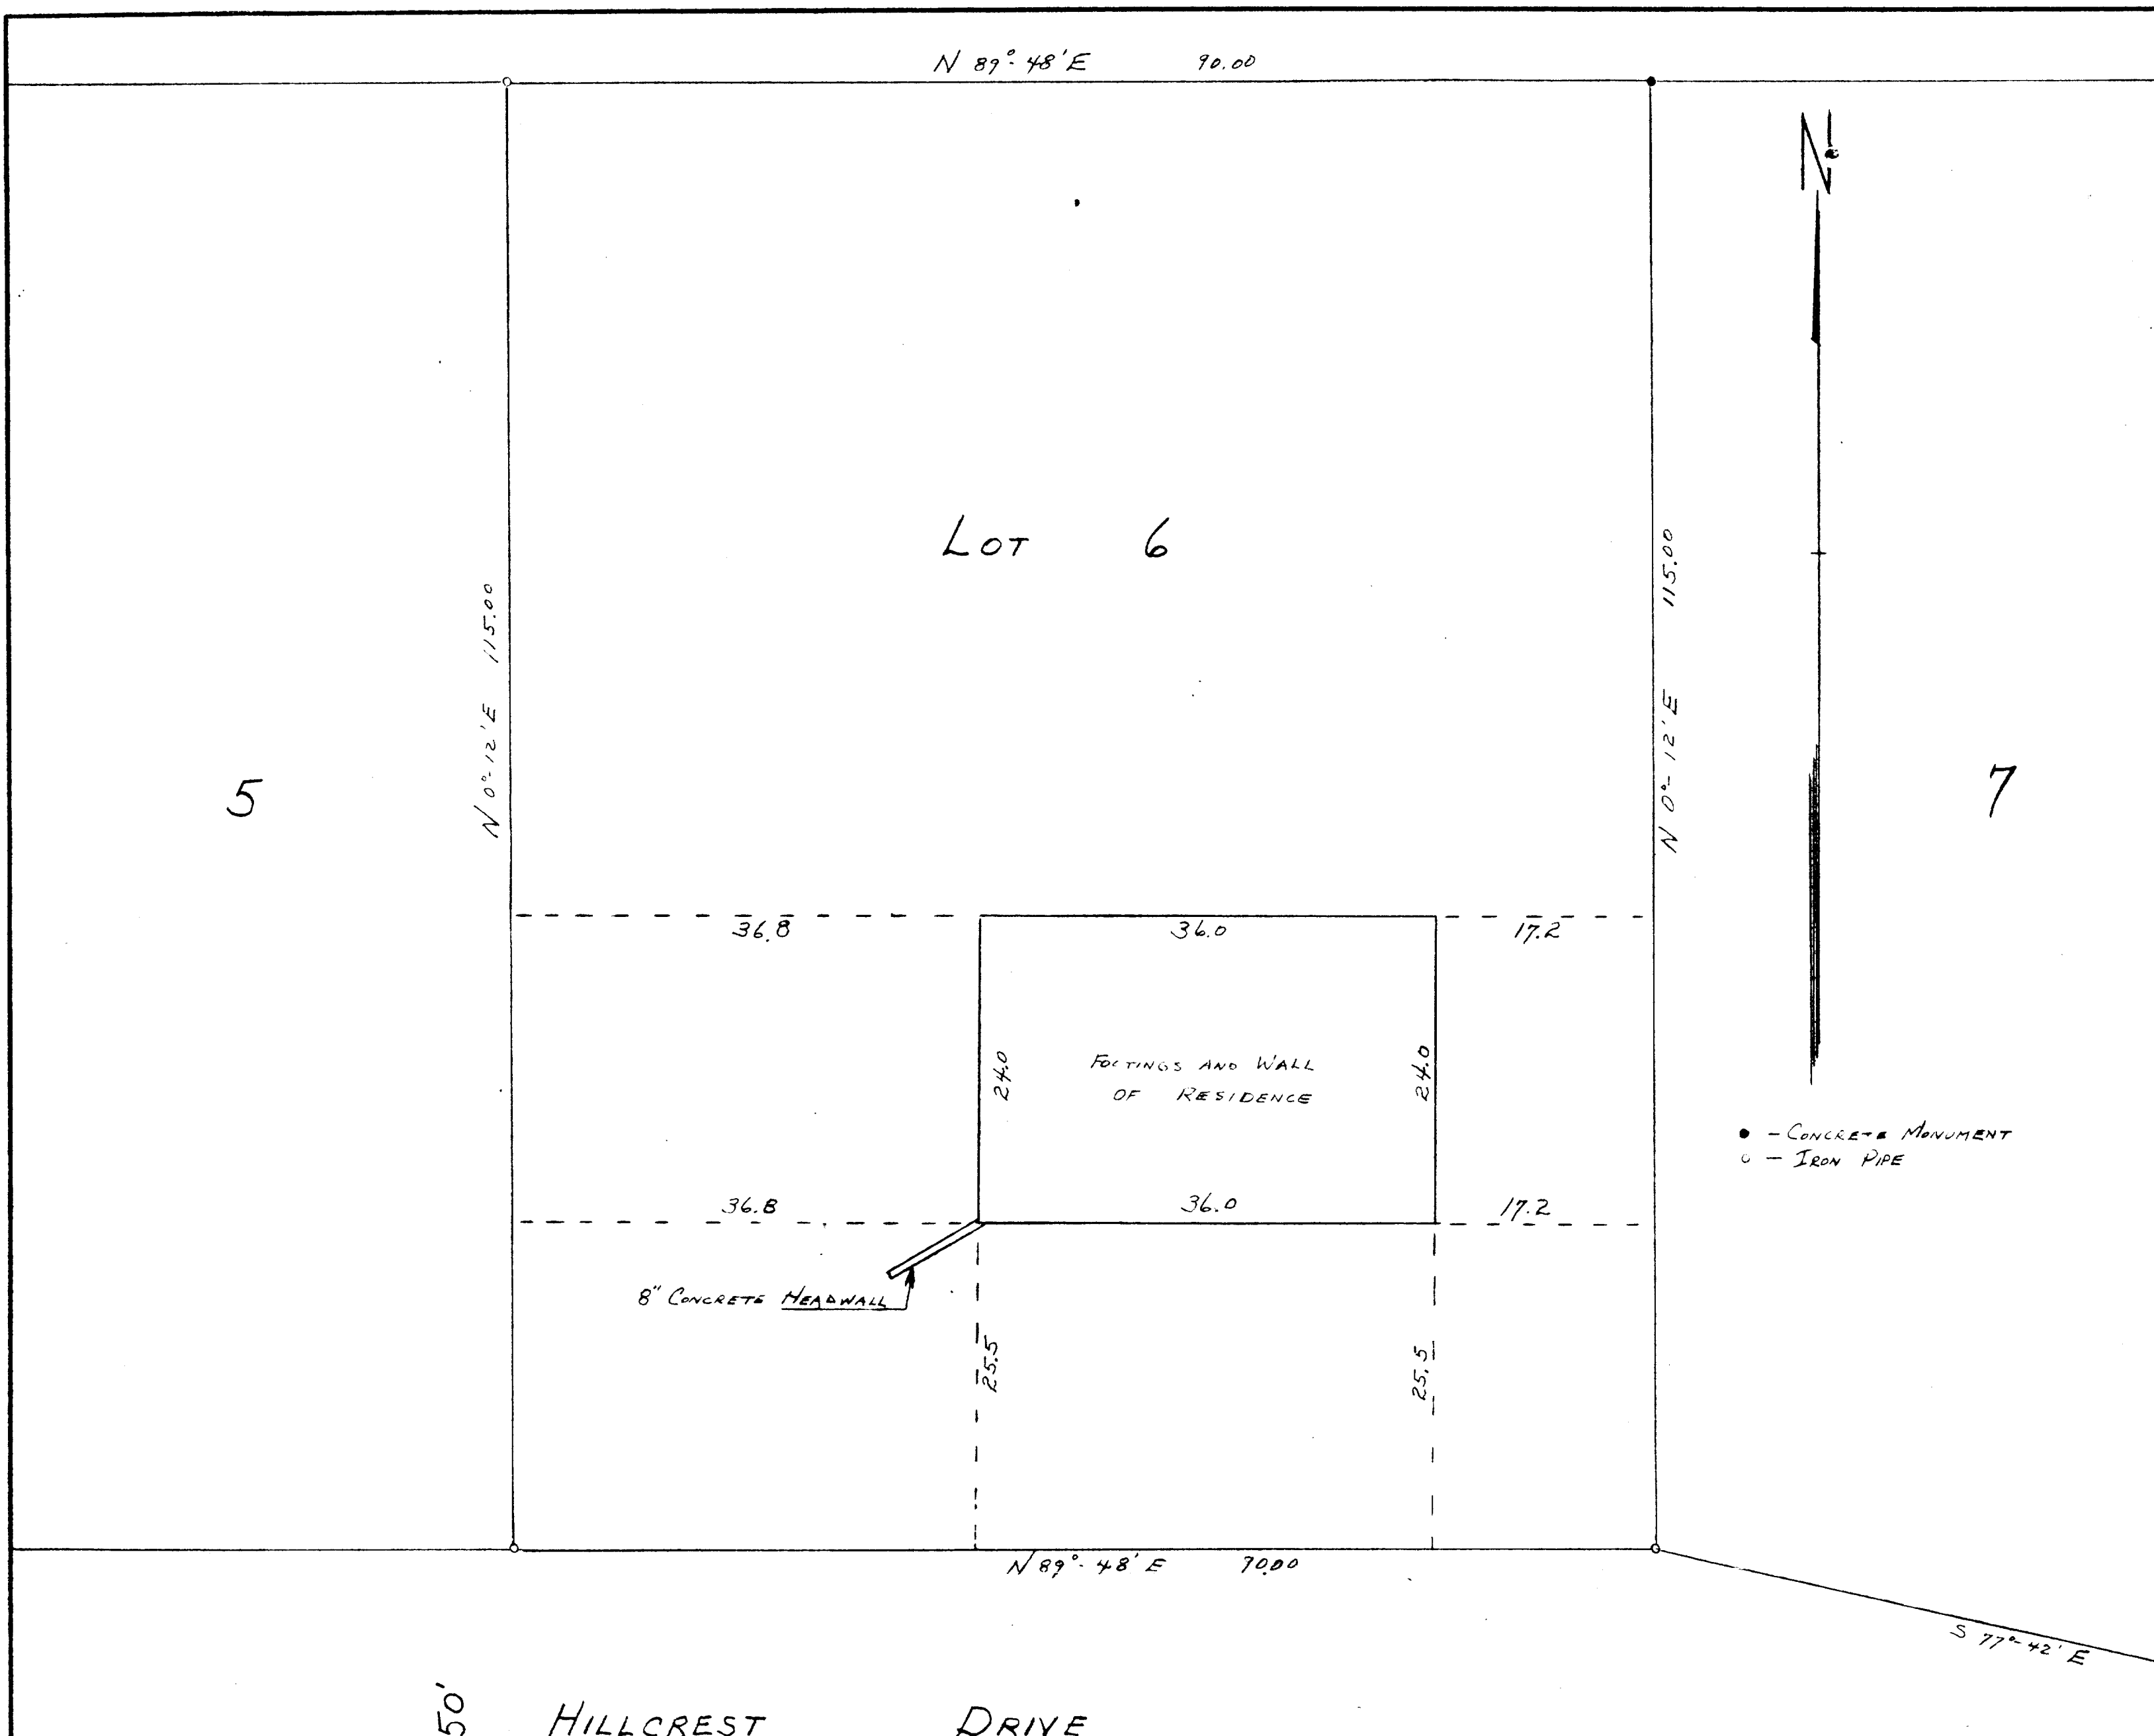

STATE OF WISCONSIN) ss
COUNTY OF WALWORTH)

I, LLOYD L. JENSEN, DO HEREBY CERTIFY THAT I HAVE SURVEYED THE
PROPERTY DESCRIBED HEREON ACCORDING TO THE OFFICIAL RECORDS, AND
THAT THE PLAT HEREON IS A CORRECT REPRESENTATION OF THE LOT
LINES AND PRINCIPAL LINES OF BUILDINGS THEREON.

ELKHORN, WISCONSIN NOVEMBER, 1954

Lloyd L. Jensen
SURVEYOR

PLAT OF SURVEY
OF

LOT 6 OF ADDITION D

TO COUNTRY CLUB ESTATES
LOCATED IN THE

VILLAGE OF FONTANA-ON-GENEVA LAKE
WALWORTH COUNTY, WISCONSIN

Lloyd L. Jensen
SURVEYOR

SCALE 1" = 10'

DATE Nov. 1954

5CTD-6