

32

10/27/21

Survey of
N.E. 1/4 Sect. 13. T. 1, N. R
Geneva Lake, Wis.
Found E. 1/4 Cor. in ctr.
below surface. and
stake, driving it 3"
stones.

Wit. { 24 3/4' S
33' S
1 1/2 line
N. 45° E
5 3'

Measured west 10.16
East line above

Measured west 73.82
to fence

Measured west 1322
surface, set
2 1/2' below surf.

Wit. { 3'
4.45'
5 1'

10/28/21

Finished above survey
to 1/8 cor. made points
670.89' and 912.45'
Cor's Barber lot

With Transit over 912.45'
Turned angle 90 1/4 (W. line)

5 acres, Geo. M. Barber, Jr.
162. Town of Walworth S. side

of highway, old wood stake, 10"
set 18" iron stake, in the wood
below surface, and packed with
to ctr. of cor. post, fence running East
" " " " " " " " West
with E. Agrs line fence running south
32.1' to 24" white oak, old blaze
20.3' " 30" " " " " scars,
(670.89') and set stone in road
5 acres.

Wit. to stone N.E. 16.3' to tel pole
S.E. 21.5' to " pole
5 chs. 914.5' W. line, above 5 acres
should be 912.45'

to 1/8 sect. line, E. 2" iron stake 18" below
1" iron stake in the 2" and drove
acc.

33' to ctr. of cor. fence post,
W. 32.1' level to blaze on 10" white oak
W. 21' to foot of 18" Black oak

With transit run line from 1/4 cor.
and set iron stakes in road at
West of 1/4 cor. for S.E. + S.W.

stake sighted on 670.89' stake and
no farther, N.E. 1/4 line 88 3/4° E, 20'

38

continued line to lake
at $24\frac{3}{4}'$ N. (road line) 414'
At 414' turned rt. angle
on E. line, ~~with~~ and set
this point (4' offset used)
made point for road
set iron & wood stake
line to the lake shore
from shore. line (stake)
W. line is 6" 2 of fence post
600' N. It is 8' 2. and
shore app. 2' W. of A. F.


Description:

Begin at an iron
T. 1 N. R. 10 E. 678 89'
thence N. 1° E. 914. 76'
thence South ^{W.} along
point 241.56' ~~directly~~ West
thence S. 1° W. 858' to
thence E. on said $\frac{1}{4}$ line
S. M. Farber to Nichols the 11.
iron stakes on E line at
from lake shore. on
1114' W. and 5' 858' N.

shore and set iron and wood stake
north and S. South of shore line.
and measured E. 241.56' for point
iron & wood stakes, with Transit on
sighted on E. point in road
fence $24\frac{3}{4}'$ N of road point
inverted telescope, and continued
and set iron & wood stake 32'
at S. W. Cor. $1\frac{1}{4}'$ E. at 414' N. at app.
at lake 24'. E. line is at lake
Nightingale cottage.

Stake on E. & W. $\frac{1}{4}$ line, Sect. 13
West of the E. end of said $\frac{1}{4}$ line
to the shore of Seneca Lake.
the shore of said lake to a
from the 1st described line above;
The E. & W. $\frac{1}{4}$ line said Sect. 13;
241.56' to place of beginning
 $\frac{1}{2}$ of the above described parcel
S. end. $24\frac{3}{4}'$ N. 414' N. and 32'
West line at S. end. $24\frac{3}{4}'$ N.
Lake shore.

43.0
42.8

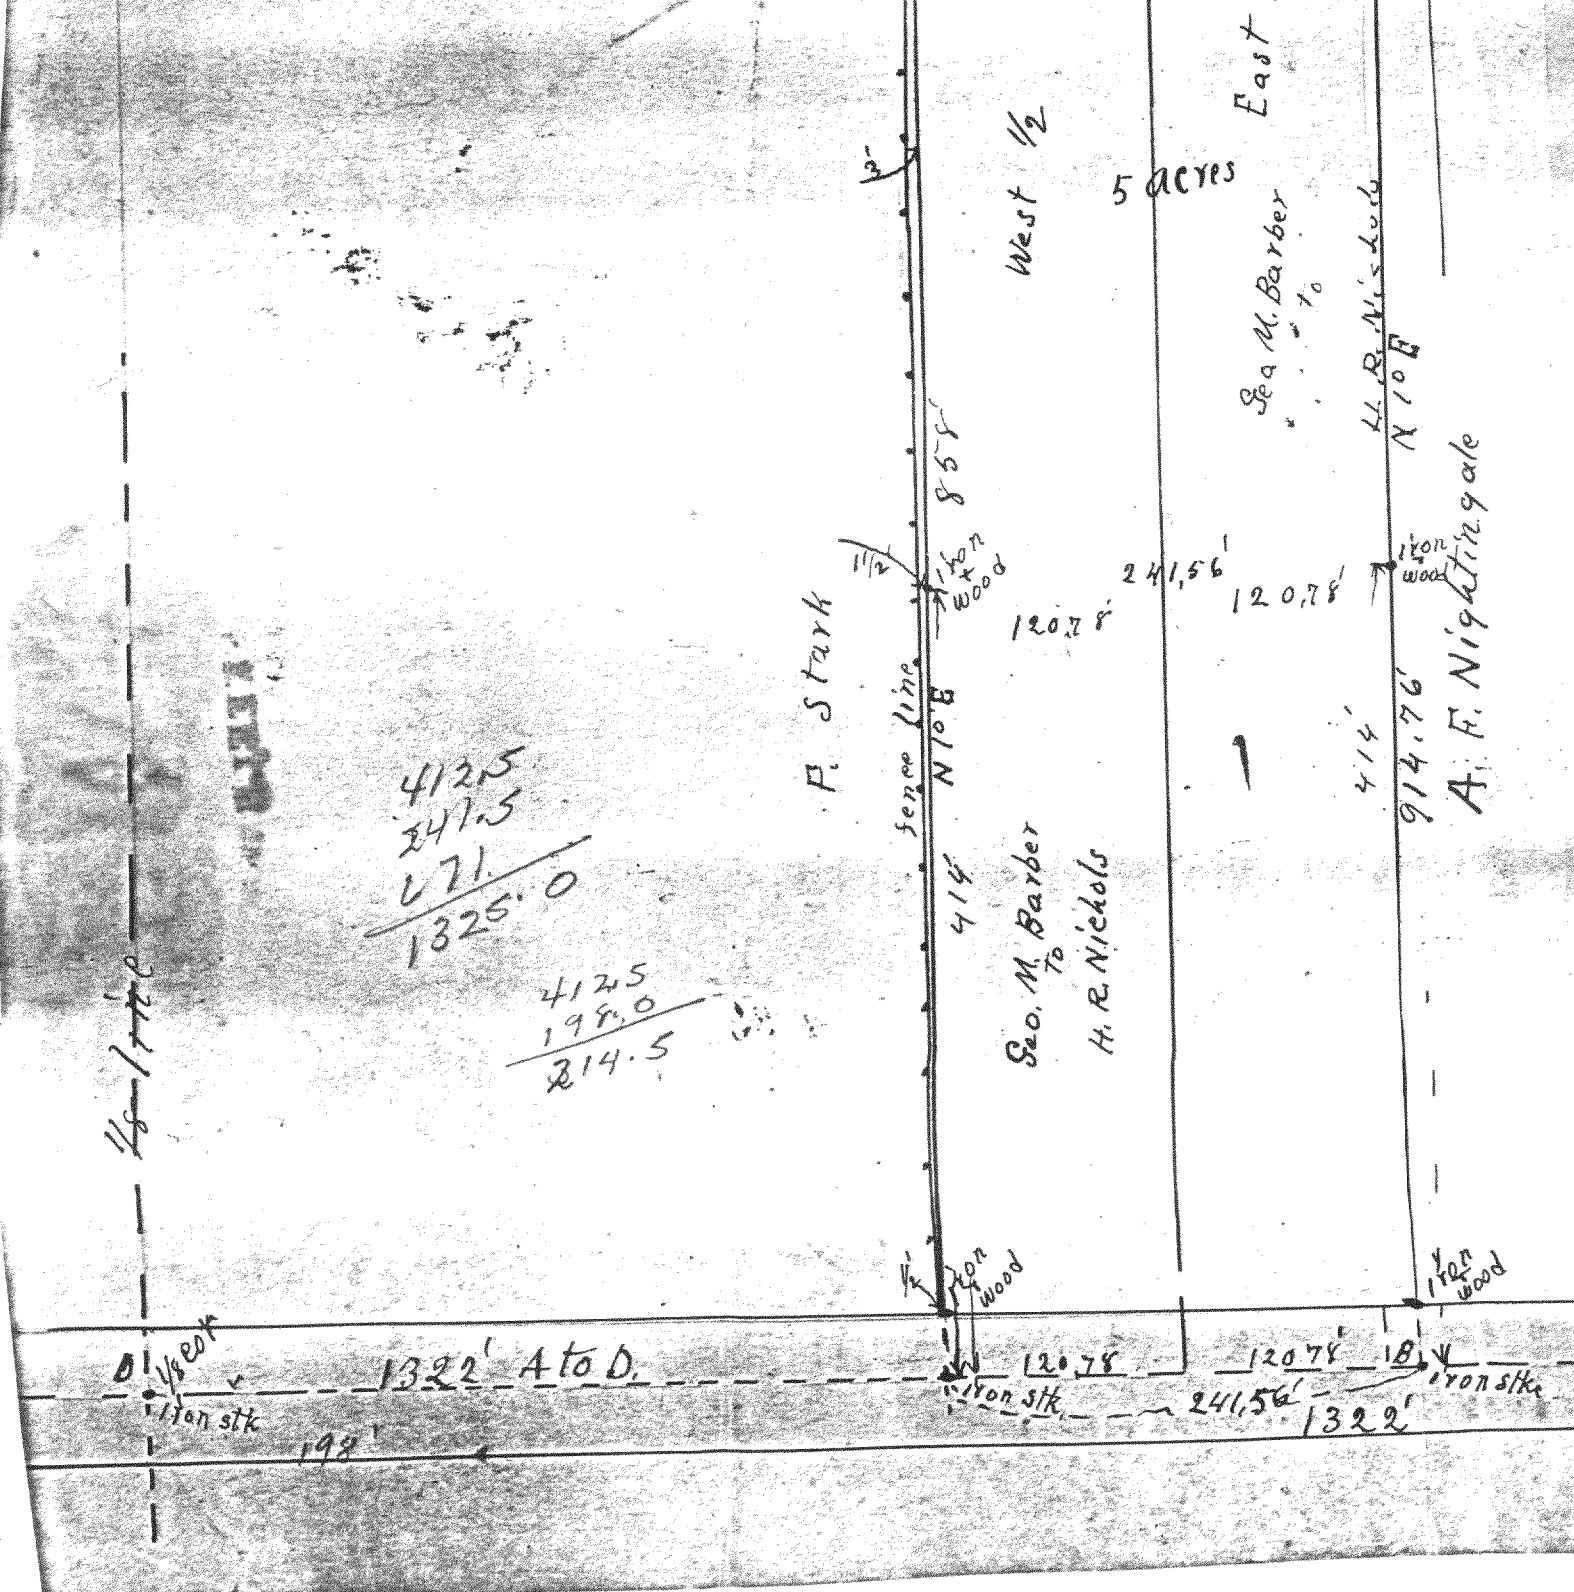

412.5
241.5
671.
1325.0

412.5
198.0
214.5

Certificate,
By request of Chas
surveyed and staked a
plat. The following de
in the N. E. 1/4 Sect. 13 T. 1
Begin at an iron stake in
Sect. 13, T. 1, N. R. 17, E. 6
of said 1/4 line; thence
shore of Geneva Lake; to
the shore of said lake
of the east line above o
858' to the said 1/4 sec
1/4 sect. line 241.56' f
The west 1/2 of said tr
to H. R. Nichols.

Scale 100' to 1"
Oct. 28, 1921
See Book J, page