


ABELL
SURVEYING & MAPPING

DELAVER, WISCONSIN 53115

414-728-6737

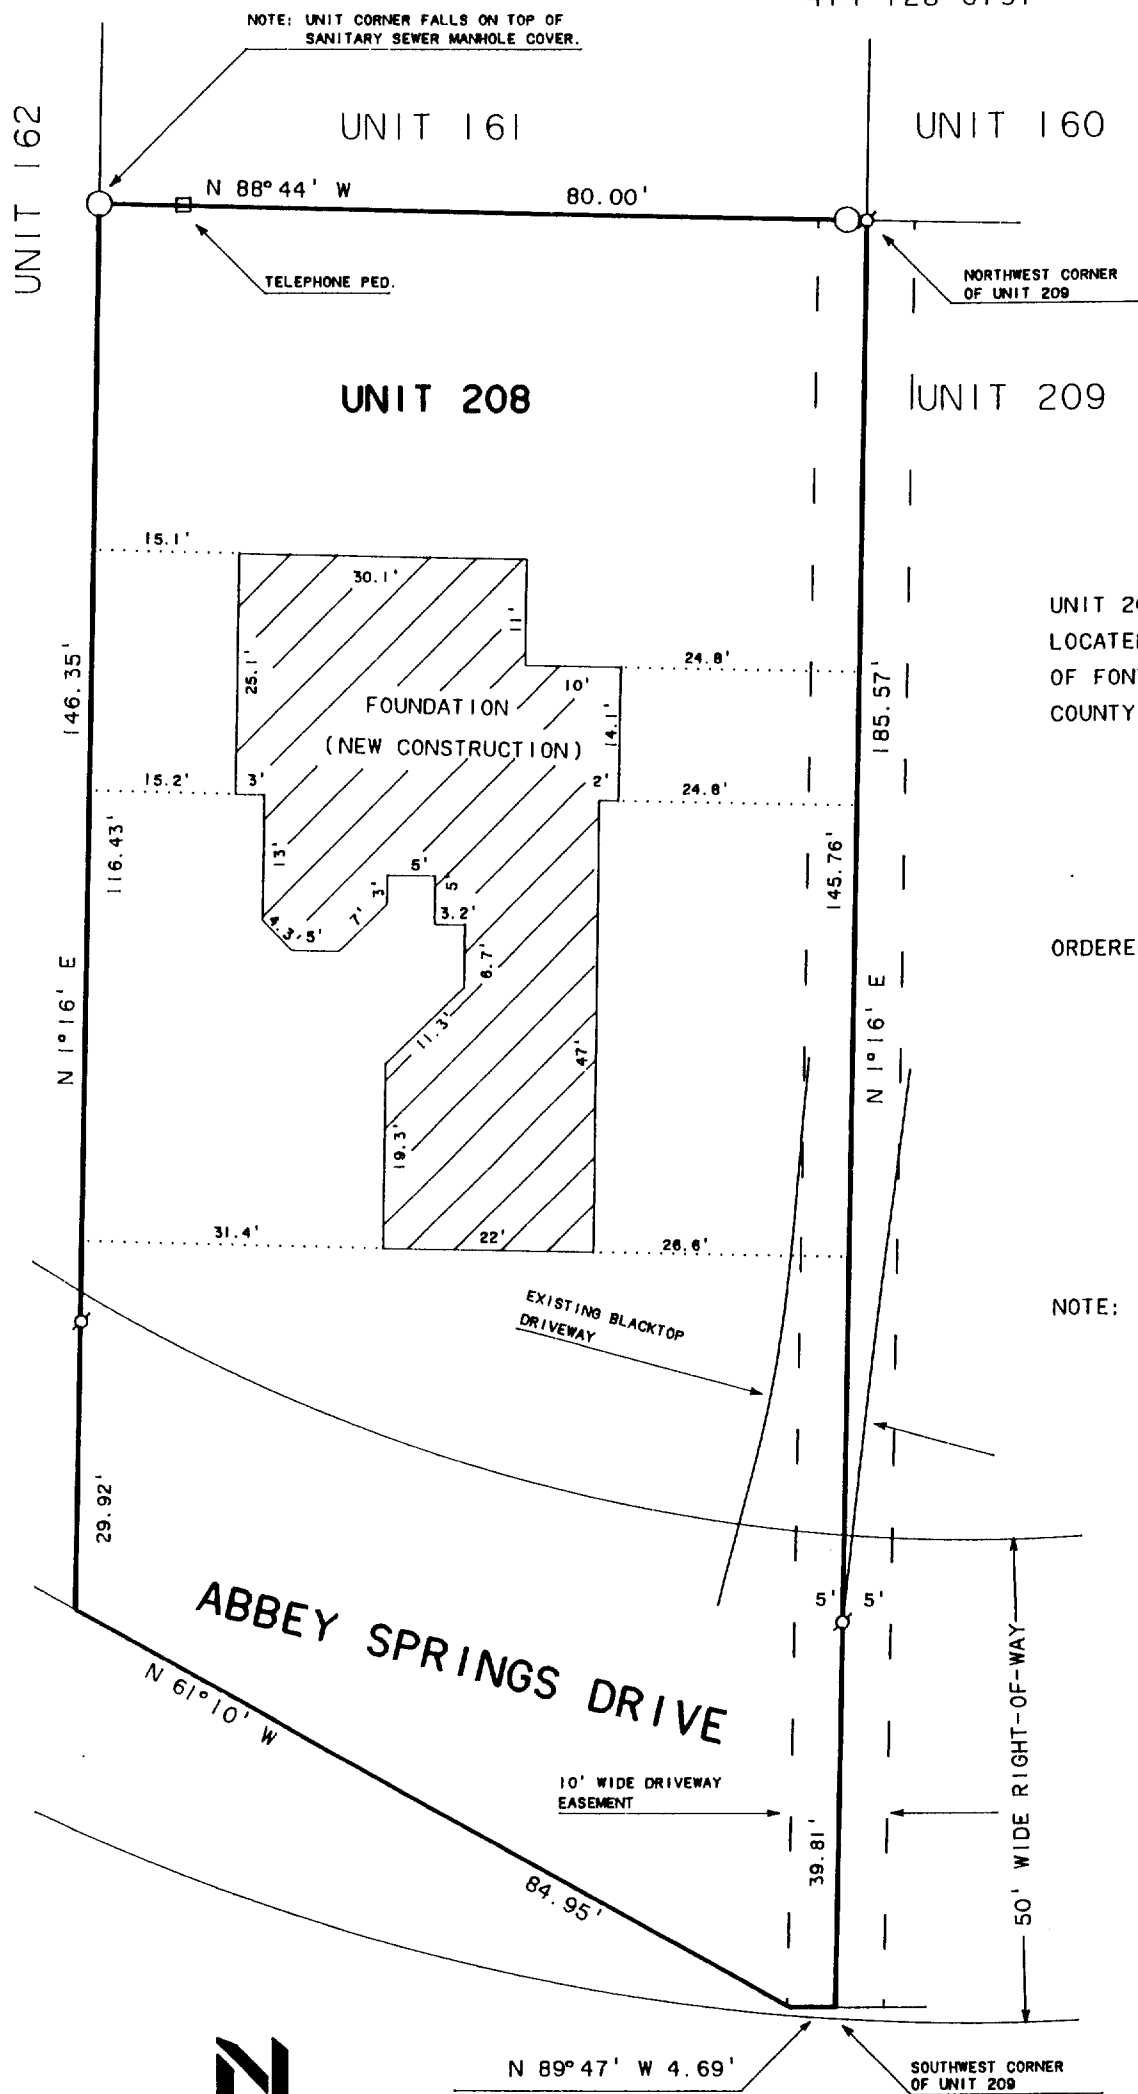

005-1107

SCDB SP0208