


Baxter & Woodman of Wisconsin

326 NORTH PINE STREET / BURLINGTON, WI 53105 / 414/763-7834
FAX / 414/763-2509

PLAT OF SURVEY AND HOUSE LOCATION FOR ROBERT OLSON



The East 90.07 feet of Lot 9, Block 1, C. L. Douglass Addition No. 1 to the Village of Fontana, Walworth County, Wisconsin.

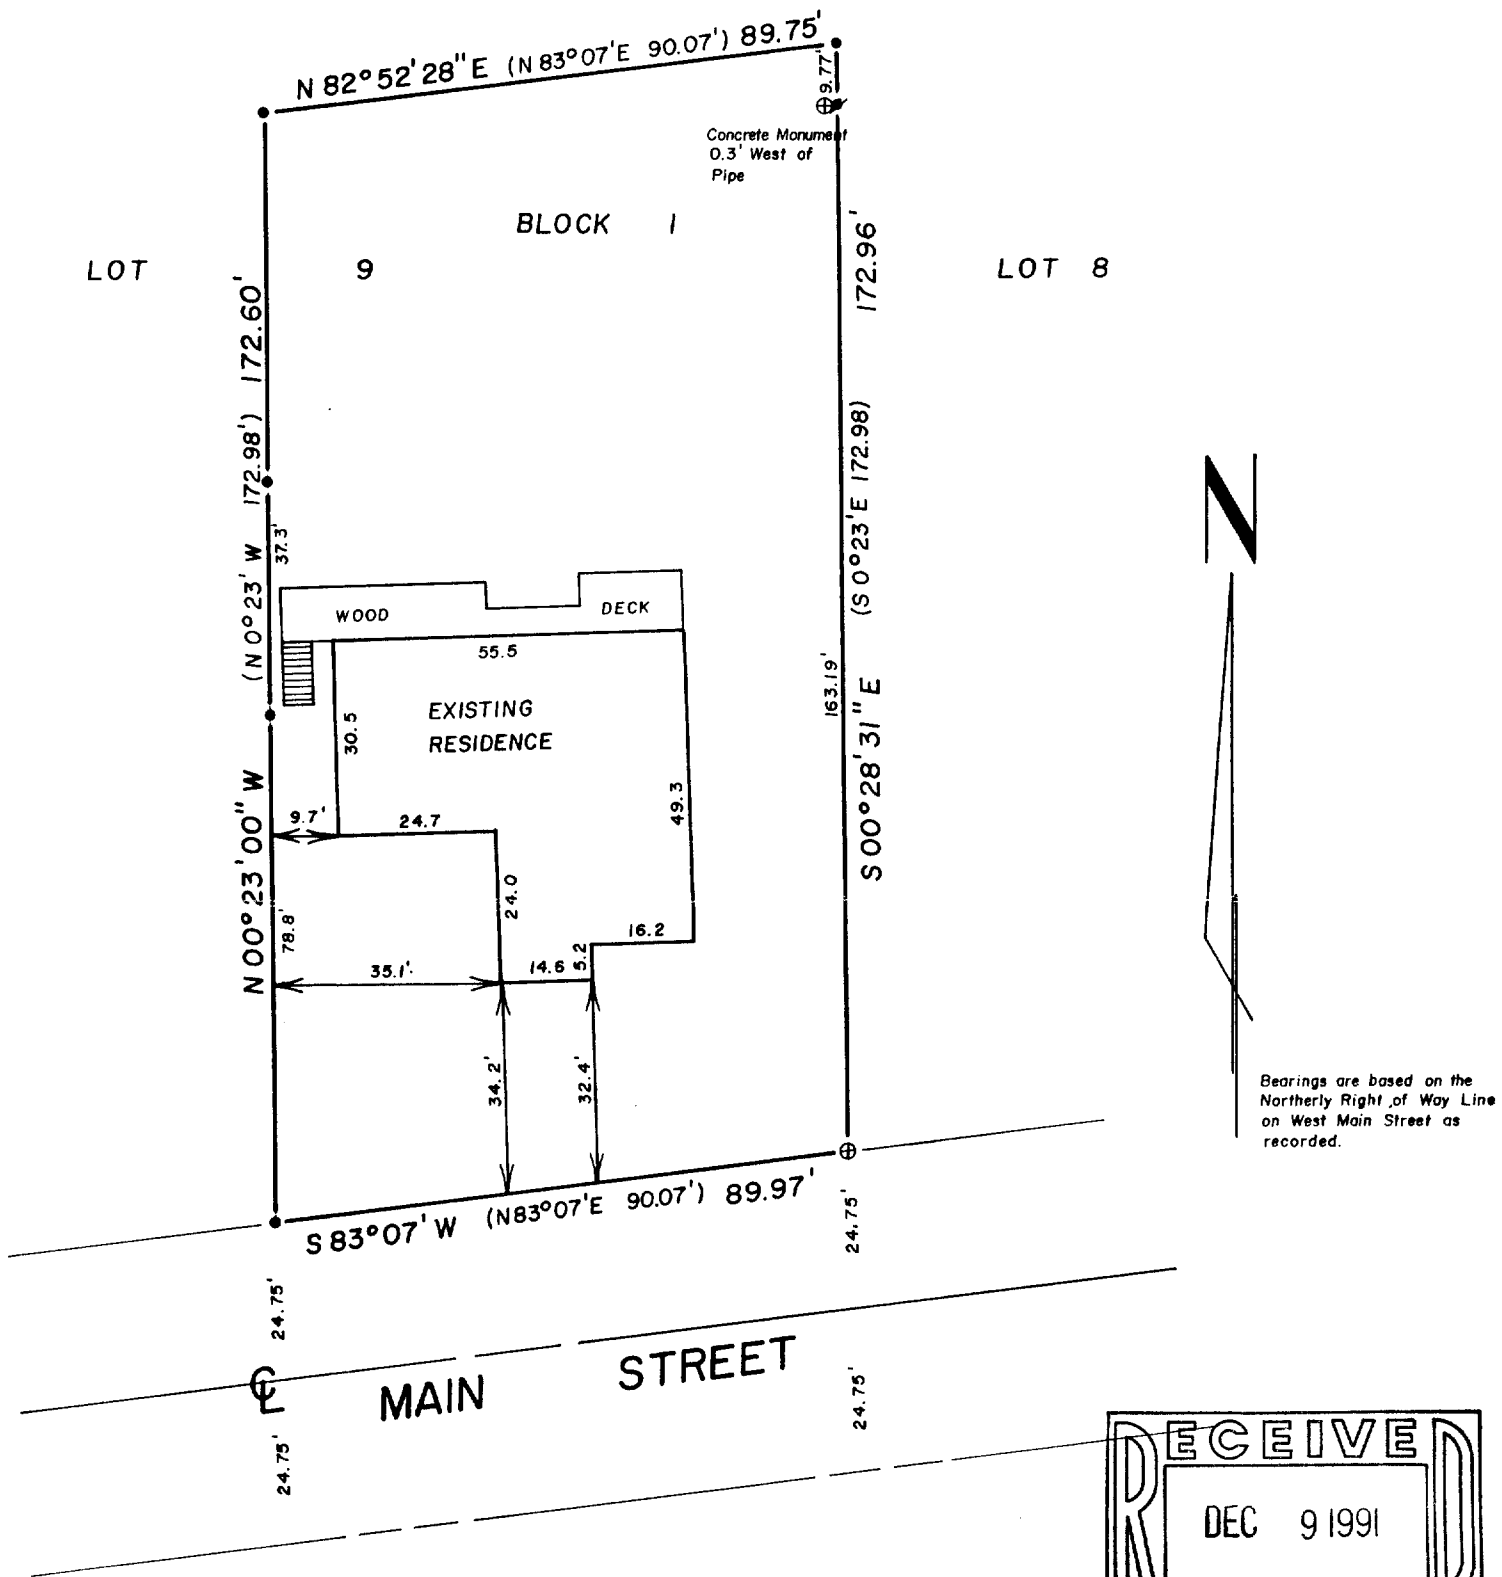

"I hereby certify that I have surveyed the above described property and that the above map is a true representation thereof and shows the size and location of the property, its exterior boundaries, the location of all visible structures and dimensions of all principal buildings thereon, boundary fences, apparent easements, roadways and visible encroachments, if any.

"This survey is made for the use of the present owners of the property, and also those who purchase, mortgage, or guarantee the title thereto within one year from date hereof."

NO MONUMENTATION HAS BEEN WAIVED IN ACCORDANCE WITH A-E 7.01(2) OF THE WISCONSIN ADMINISTRATIVE CODE.

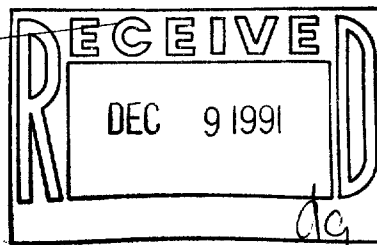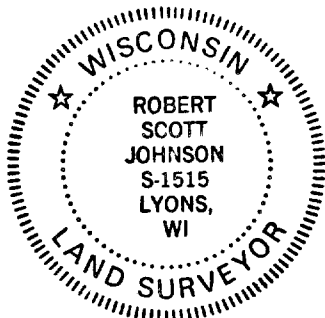

LEGEND

- + CHISEL CUT IN CONCRETE
- o PK NAIL
- FOUND IRON PIPE - 1 1/4"
- FOUND IRON PIPE - 1"
- SET IRON PIPE -
- FOUND BRASS CAPPED MONUMENT
- ⊕ FOUND CONCRETE MONUMENT
- FENCE
- () RECORDED AS
- EXISTING GROUND ELEVATION

SCALE - 1" = 30'

Robert Scott Johnson
WISCONSIN REGISTERED LAND SURVEYOR

11/14/91
DATE

FIELD WORK BY rsj & bjz DRAWN BY bjz

91232
JOB NUMBER

GMB 1020H
005-1126

STEV 00179

R.D.