
## ABELL SURVEYING & MAPPING

DELAVAN, WISCONSIN 53115 414-728-6737



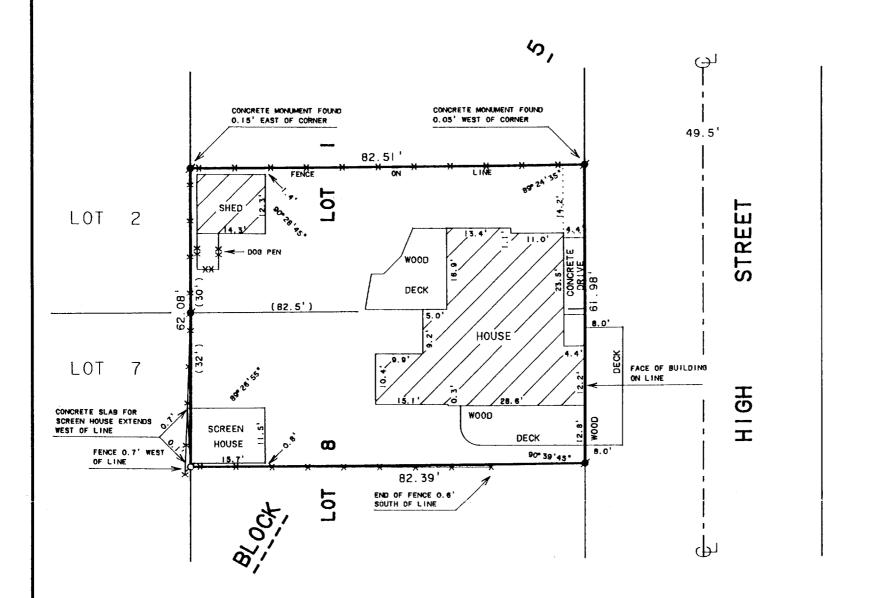

THE NORTH 32 FEET OF LOT 8 AND THE SOUTH 30 FEET OF LOT 1, BLOCK 5, ORIGINAL PLAT OF THE VILLAGE OF FONTANA-ON-GENEVA LAKE, WALWORTH COUNTY, WISCONSIN.

PLAT OF SURVEY OF

SCALE I "= 20'
LEGEND



ORDERED BY: KEEFE REAL ESTATE

704 MAIN STREET

LAKE GENEVA, WI. 53147

I HEREBY CERTIFY THAT I HAVE SURVEYED THE ABOVE DESCRIBED PROPERTY AND THAT THE ABOVE MAP IS A TRUE REPRESENTATION THEREOF AND SHOWS THE SIZE AND LOCATION OF THE PROPERTY, ITS EXTERIOR BOUNDARIES, THE LOCATION OF ALL VISIBLE STRUCTURES AND DIMENSIONS OF ALL PRINCIPAL BUILDINGS THEREON, BOUNDARY FENCES, APPARENT EASEMENTS, ROADWAYS AND VISIBLE ENCROACHMENTS, IF ANY, TO THE BEST OF MY KNOWLEDGE AND BELIEF.

THIS SURVEY IS MADE FOR THE USE OF THE PRESENT OWNERS OF THE PROPERTY, AND ALSO THOSE WHO PURCHASE, MORTGAGE, OR GUARANTEE THE TITLE THERETO WITHIN ONE (1) YEAR

David 7. alel

WISCONSIN REGISTERED LAND SURVEYOR, S-1596

June 11, 1991

JOB NUMBER - 91120

NOTE: THIS IS NOT A CERTIFIED COPY UNLESS SEALED.