
ABELL SURVEYING & MAPPING

DELAVAN. WISCONSIN 53115



FONTANA

BOULEVARD

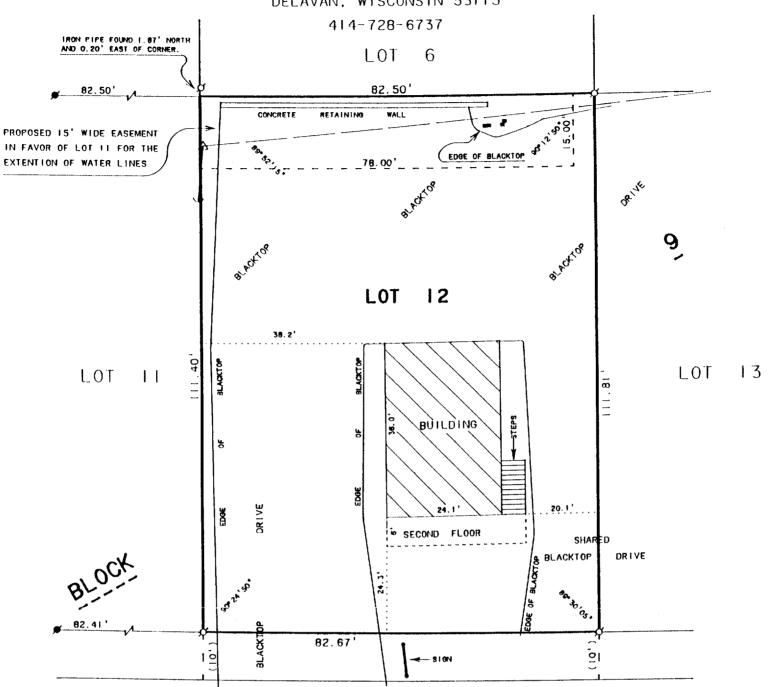

SCALE | "= 20'


LEGEND

- Ø IRON PIPE FOUND
- - CONCRETE MONUMENT FOUND
- A -UTILITY POLE
- WATER VALVE BOX
- ()-RECORDED AS

PLAT OF SURVEY OF

LOT 12, BLOCK 9 OF THE ORIGINAL PLAT OF THE VILLAGE OF FONTANA-ON-GENEVA LAKE, WALWORTH COUNTY, WISCONSIN. EXCEPTING THEREFROM THE SOUTH 10 FEET OF SAID LOT 12.

ORDERED BY: DEAN HOLDEN
P.O. BOX H
FONTANA, WI. 53125

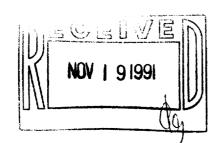

I HEREBY CERTIFY THAT I HAVE SURVEYED THE ABOVE DESCRIBED PROPERTY AND THAT THE ABOVE MAP IS A TRUE REPRESENTATION THEREOF AND SHOWS THE SIZE AND LOCATION OF THE PROPERTY. ITS EXTERIOR BOUNDARIES. THE LOCATION OF ALL VISIBLE STRUCTURES AND DIMENSIONS OF ALL PRINCIPAL BUILDINGS THEREON, BOUNDARY FENCES, APPARENT EASEMENTS, ROADWAYS AND VISIBLE ENCROACHMENTS, IF ANY, TO THE BEST OF MY KNOWLEDGE AND BELIEF.

THIS SURVEY IS MADE FOR THE USE OF THE PRESENT OWNERS OF THE PROPERTY. AND ALSO THOSE WHO PURCHASE, MORTGAGE, OR GUARANTEE THE TITLE THERETO WITHIN ONE (+) YEAR

David 7. abell

WISCONSIN REGISTERED LAND SURVEYOR, S-1596

September 16, 1991

NOTE: THIS IS NOT A CERTIFIED COPY UNLESS SEALED.