



 SCALE 1"=20'
 LEGEND
 ○ - IRON PIPE FOUND
 ● - IRON ROD FOUND
 () - RECORDED AS

NOTE: BEARINGS ARE REFERENCED TO THE
 RECORDED CONDOMINIUM PLAT.

 NOTE: LOCATION OF STREAM TAKEN FROM
 EXISTING SURVEY RECORDS.

 ORDERED BY: ABELL & REDDING
 799 ELM ST. SUITE 205
 WINNETKA, IL. 60093

ABELL
SURVEYING & MAPPING
 DELAVAN, WISCONSIN 53115
 414-728-6737

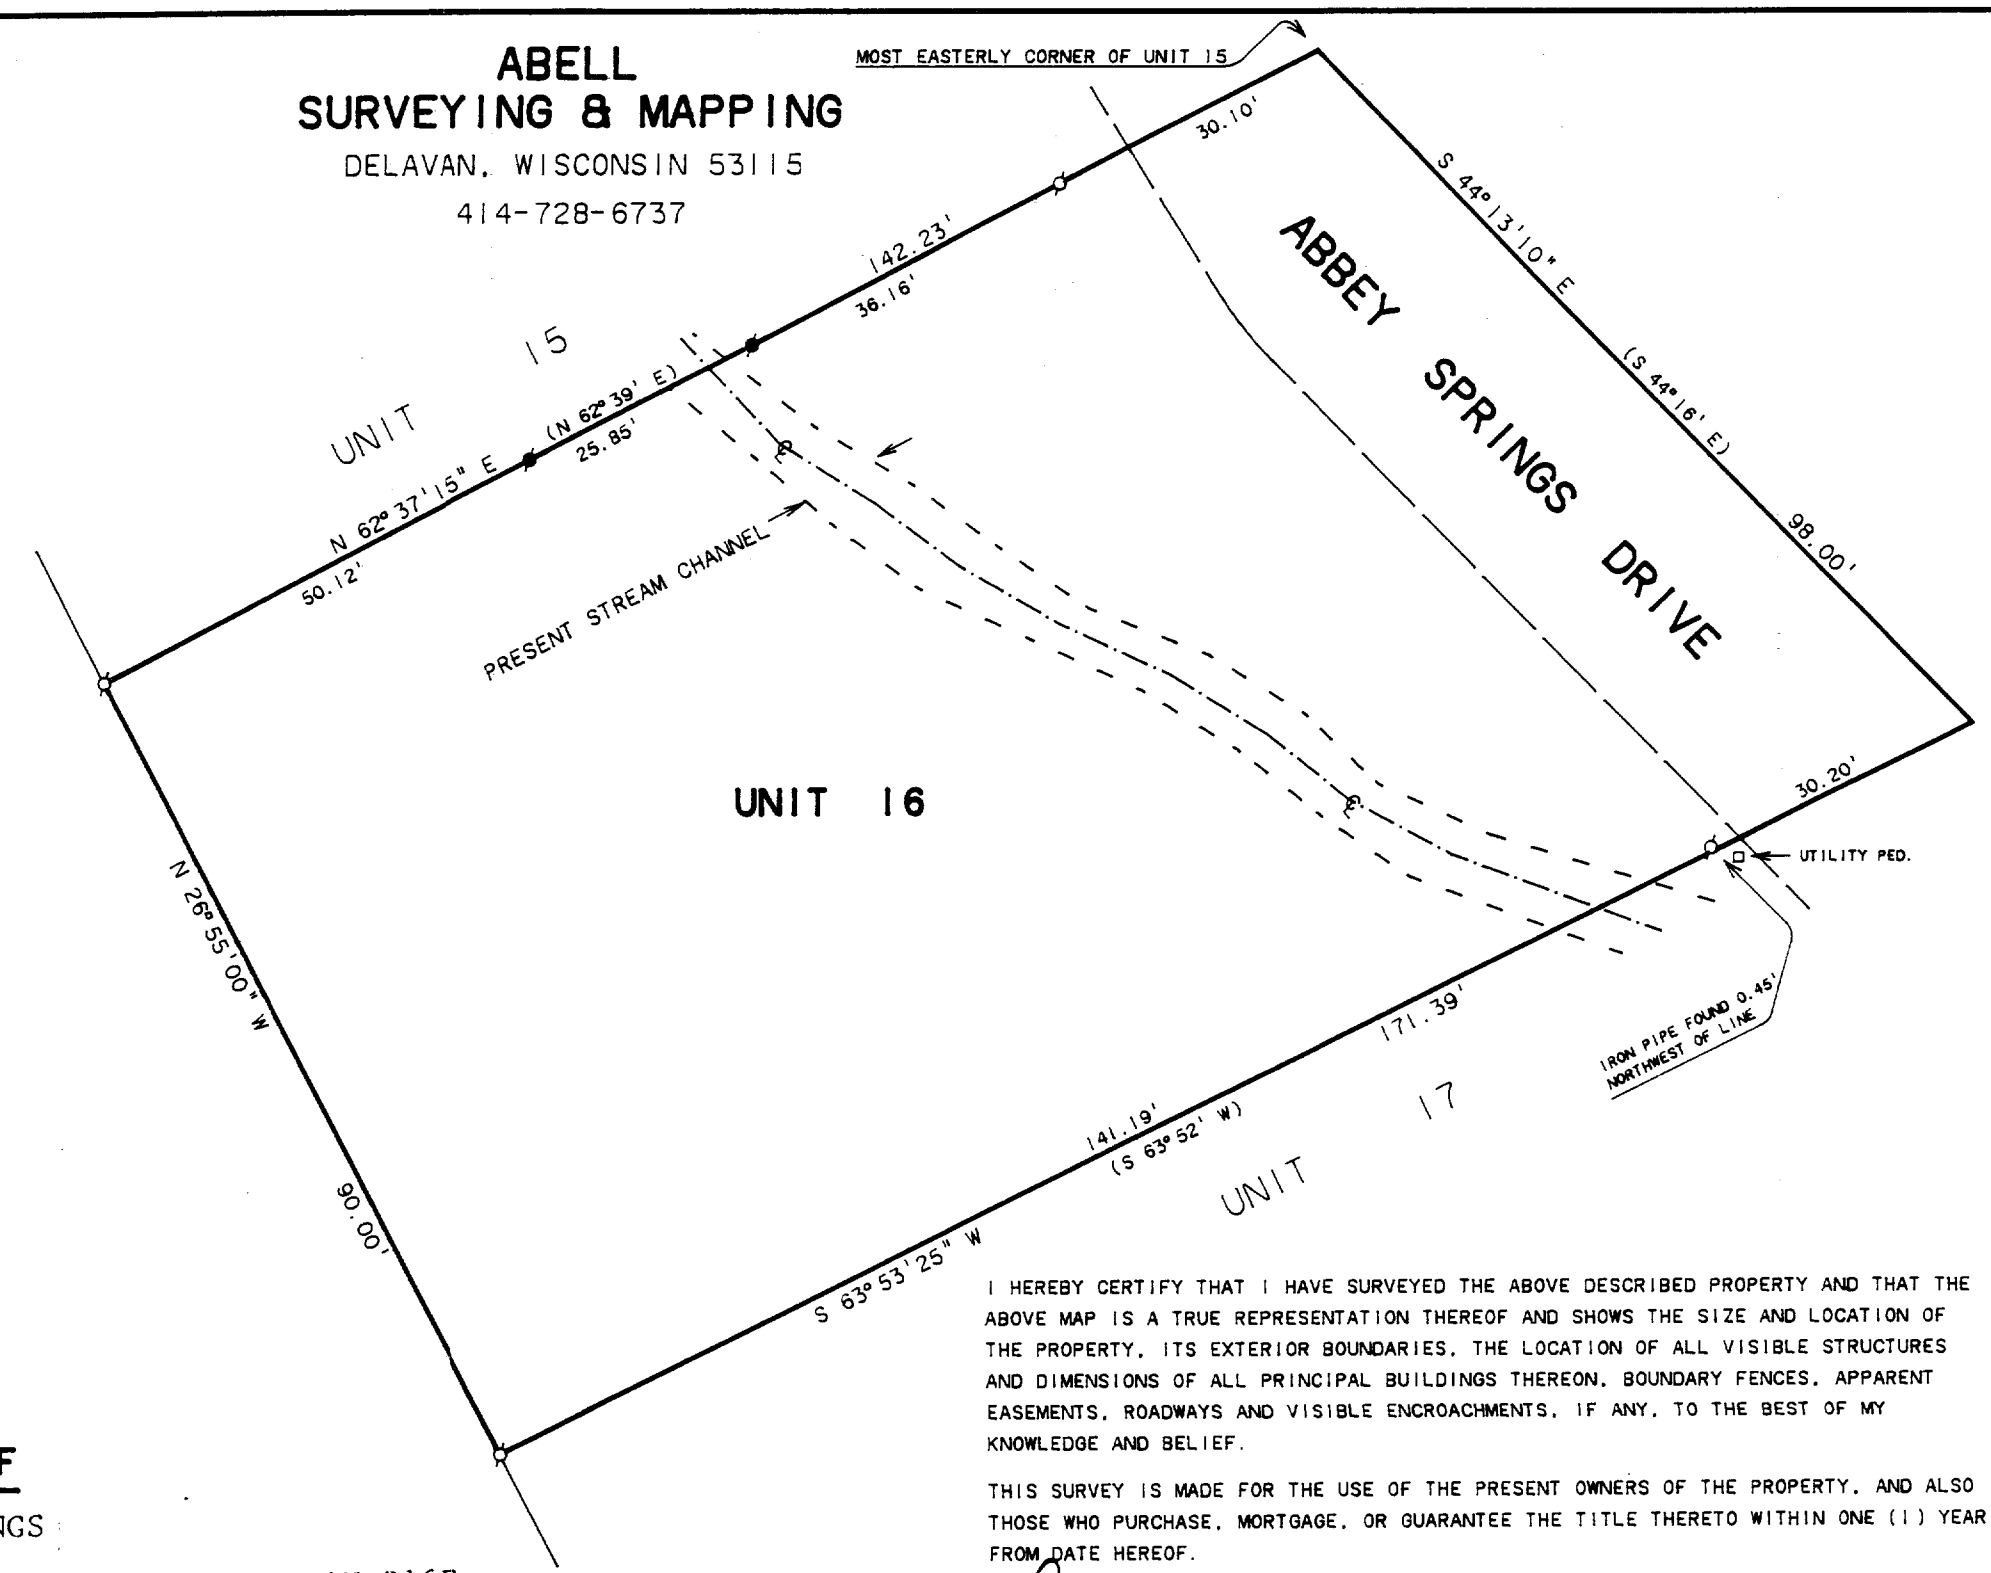


PLAT OF SURVEY OF

UNIT 16 OF ABBEY SPRINGS


A parcel of land located in the South ½ of Section 13, T1N R16E, Village of Fontana-on-Geneva Lake, Walworth County, Wisconsin, described as follows to wit:

Beginning at the most Easterly corner of Unit 15 of Abbey Springs; thence S44°-16'E 98.00 feet; thence S63°-52'W 171.39 feet; thence N26°-55'W 90.00 feet; thence N62°-39'E 142.23 feet to the place of beginning, containing 0.3303 acres of land more or less.

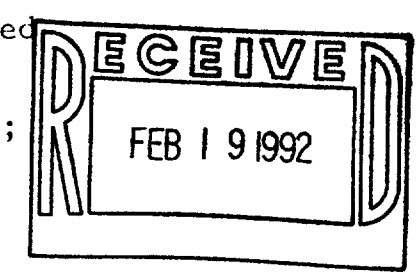

I HEREBY CERTIFY THAT I HAVE SURVEYED THE ABOVE DESCRIBED PROPERTY AND THAT THE ABOVE MAP IS A TRUE REPRESENTATION THEREOF AND SHOWS THE SIZE AND LOCATION OF THE PROPERTY, ITS EXTERIOR BOUNDARIES, THE LOCATION OF ALL VISIBLE STRUCTURES AND DIMENSIONS OF ALL PRINCIPAL BUILDINGS THEREON, BOUNDARY FENCES, APPARENT EASEMENTS, ROADWAYS AND VISIBLE ENCROACHMENTS, IF ANY, TO THE BEST OF MY KNOWLEDGE AND BELIEF.

THIS SURVEY IS MADE FOR THE USE OF THE PRESENT OWNERS OF THE PROPERTY, AND ALSO THOSE WHO PURCHASE, MORTGAGE, OR GUARANTEE THE TITLE THERETO WITHIN ONE (1) YEAR FROM DATE HEREOF.

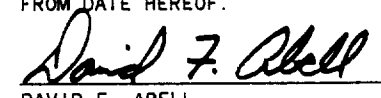
 DAVID F. ABELL
 WISCONSIN REGISTERED LAND SURVEYOR. S-1596

October 15, 1991
 DATE JOB NUMBER - 91216
 NOTE: THIS IS NOT A CERTIFIED COPY UNLESS SEALED.