

ABERNATHY and ASSOCIATES

Kenneth B. Abernathy Jr.

Wisconsin Registered Land Surveyor S-1594



Rt. 3, Box 273
Elkhorn, Wisconsin 53121
Phone: (414) 723-4260 (office)
(414) 723-4813 (residence)

PLAT OF SURVEY

LOT 39 OF BUENA VISTA SUBDIVISION, A SUBDIVISION
LOCATED IN SECTIONS 11 AND 14, TOWN 1 NORTH, RANGE 16
EAST, VILLAGE OF FONTANA, WALWORTH COUNTY, WISCONSIN.

OWNERS: ROBERT C. CHANSON
SONETTE C. SALTER
C/O MOORE BUSINESS FORMS
615 N. LONGWOOD ST
SUITE 200
ROCKFORD, ILL. 61107-4249

ORDERED BY: HOME DESIGN MFG. CORP
HMY 67 NORTH
FONTANA, WI. 53125

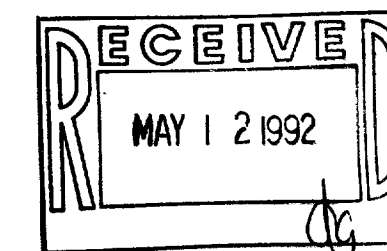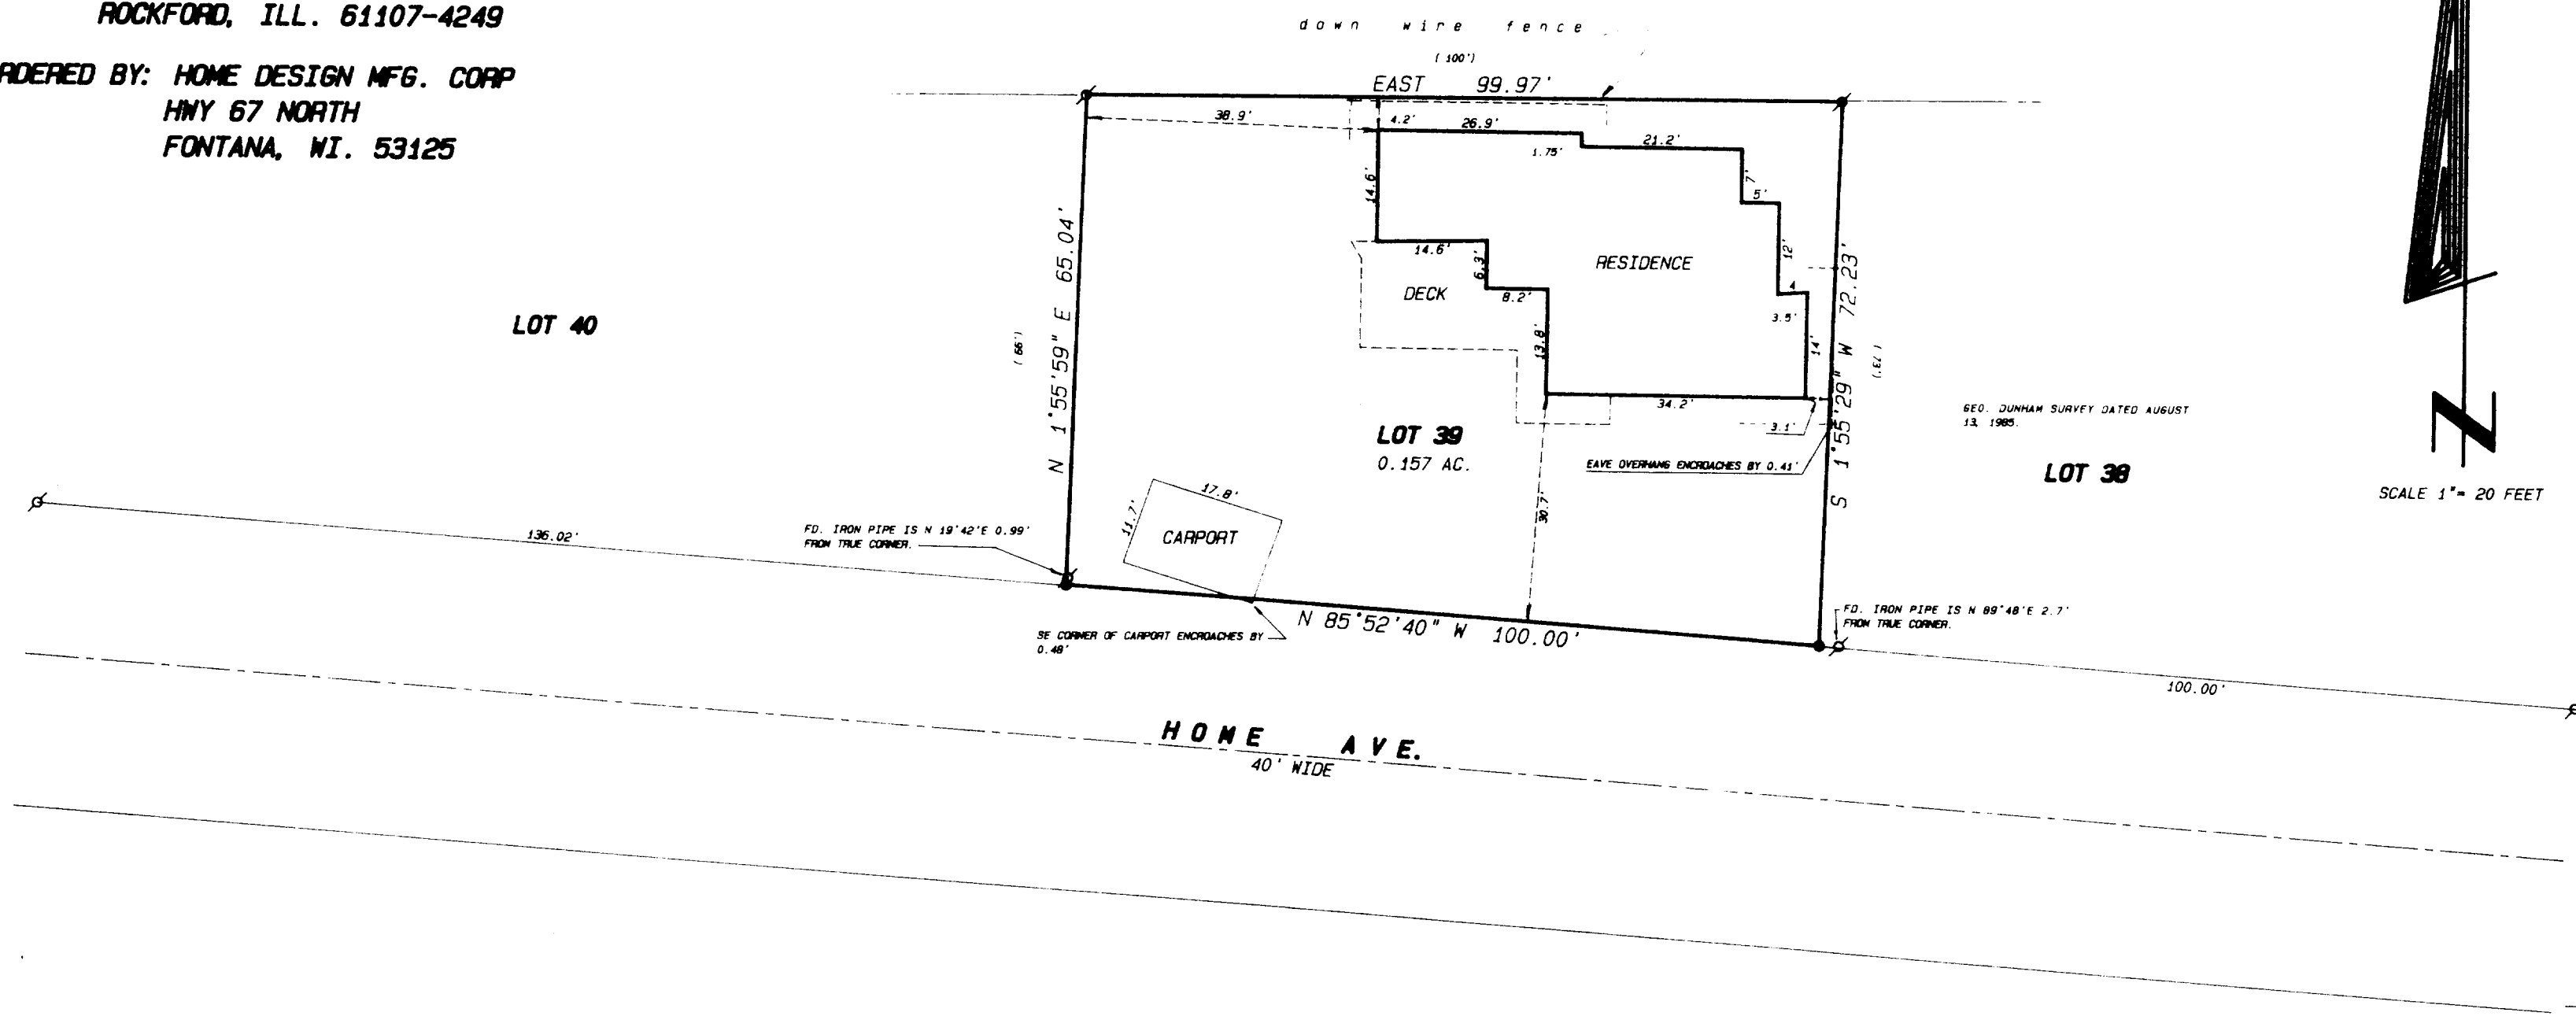

SCALE: 1" = 20 FEET

I hereby certify that I have surveyed the above described property and that the above map is a true representation thereof and shows the size and location of the property, its exterior boundaries, the location of all visible structures and dimensions of all principal buildings thereon, boundary fences, apparent easements, roadways and visible encroachments, if any.

This survey is made for the use of the present owners of the property, and also those who purchase, mortgage, or guarantee the title thereto within one year from date hereof.

Kenneth B. Abernathy Jr.
KENNETH B. ABERNATHY, JR.
WISCONSIN REGISTERED LAND SURVEYOR,
S-1594

Date: 3/4/92 Job No. 92 302

