


N

- CONCRETE MONUMENT
- IRON PIPE

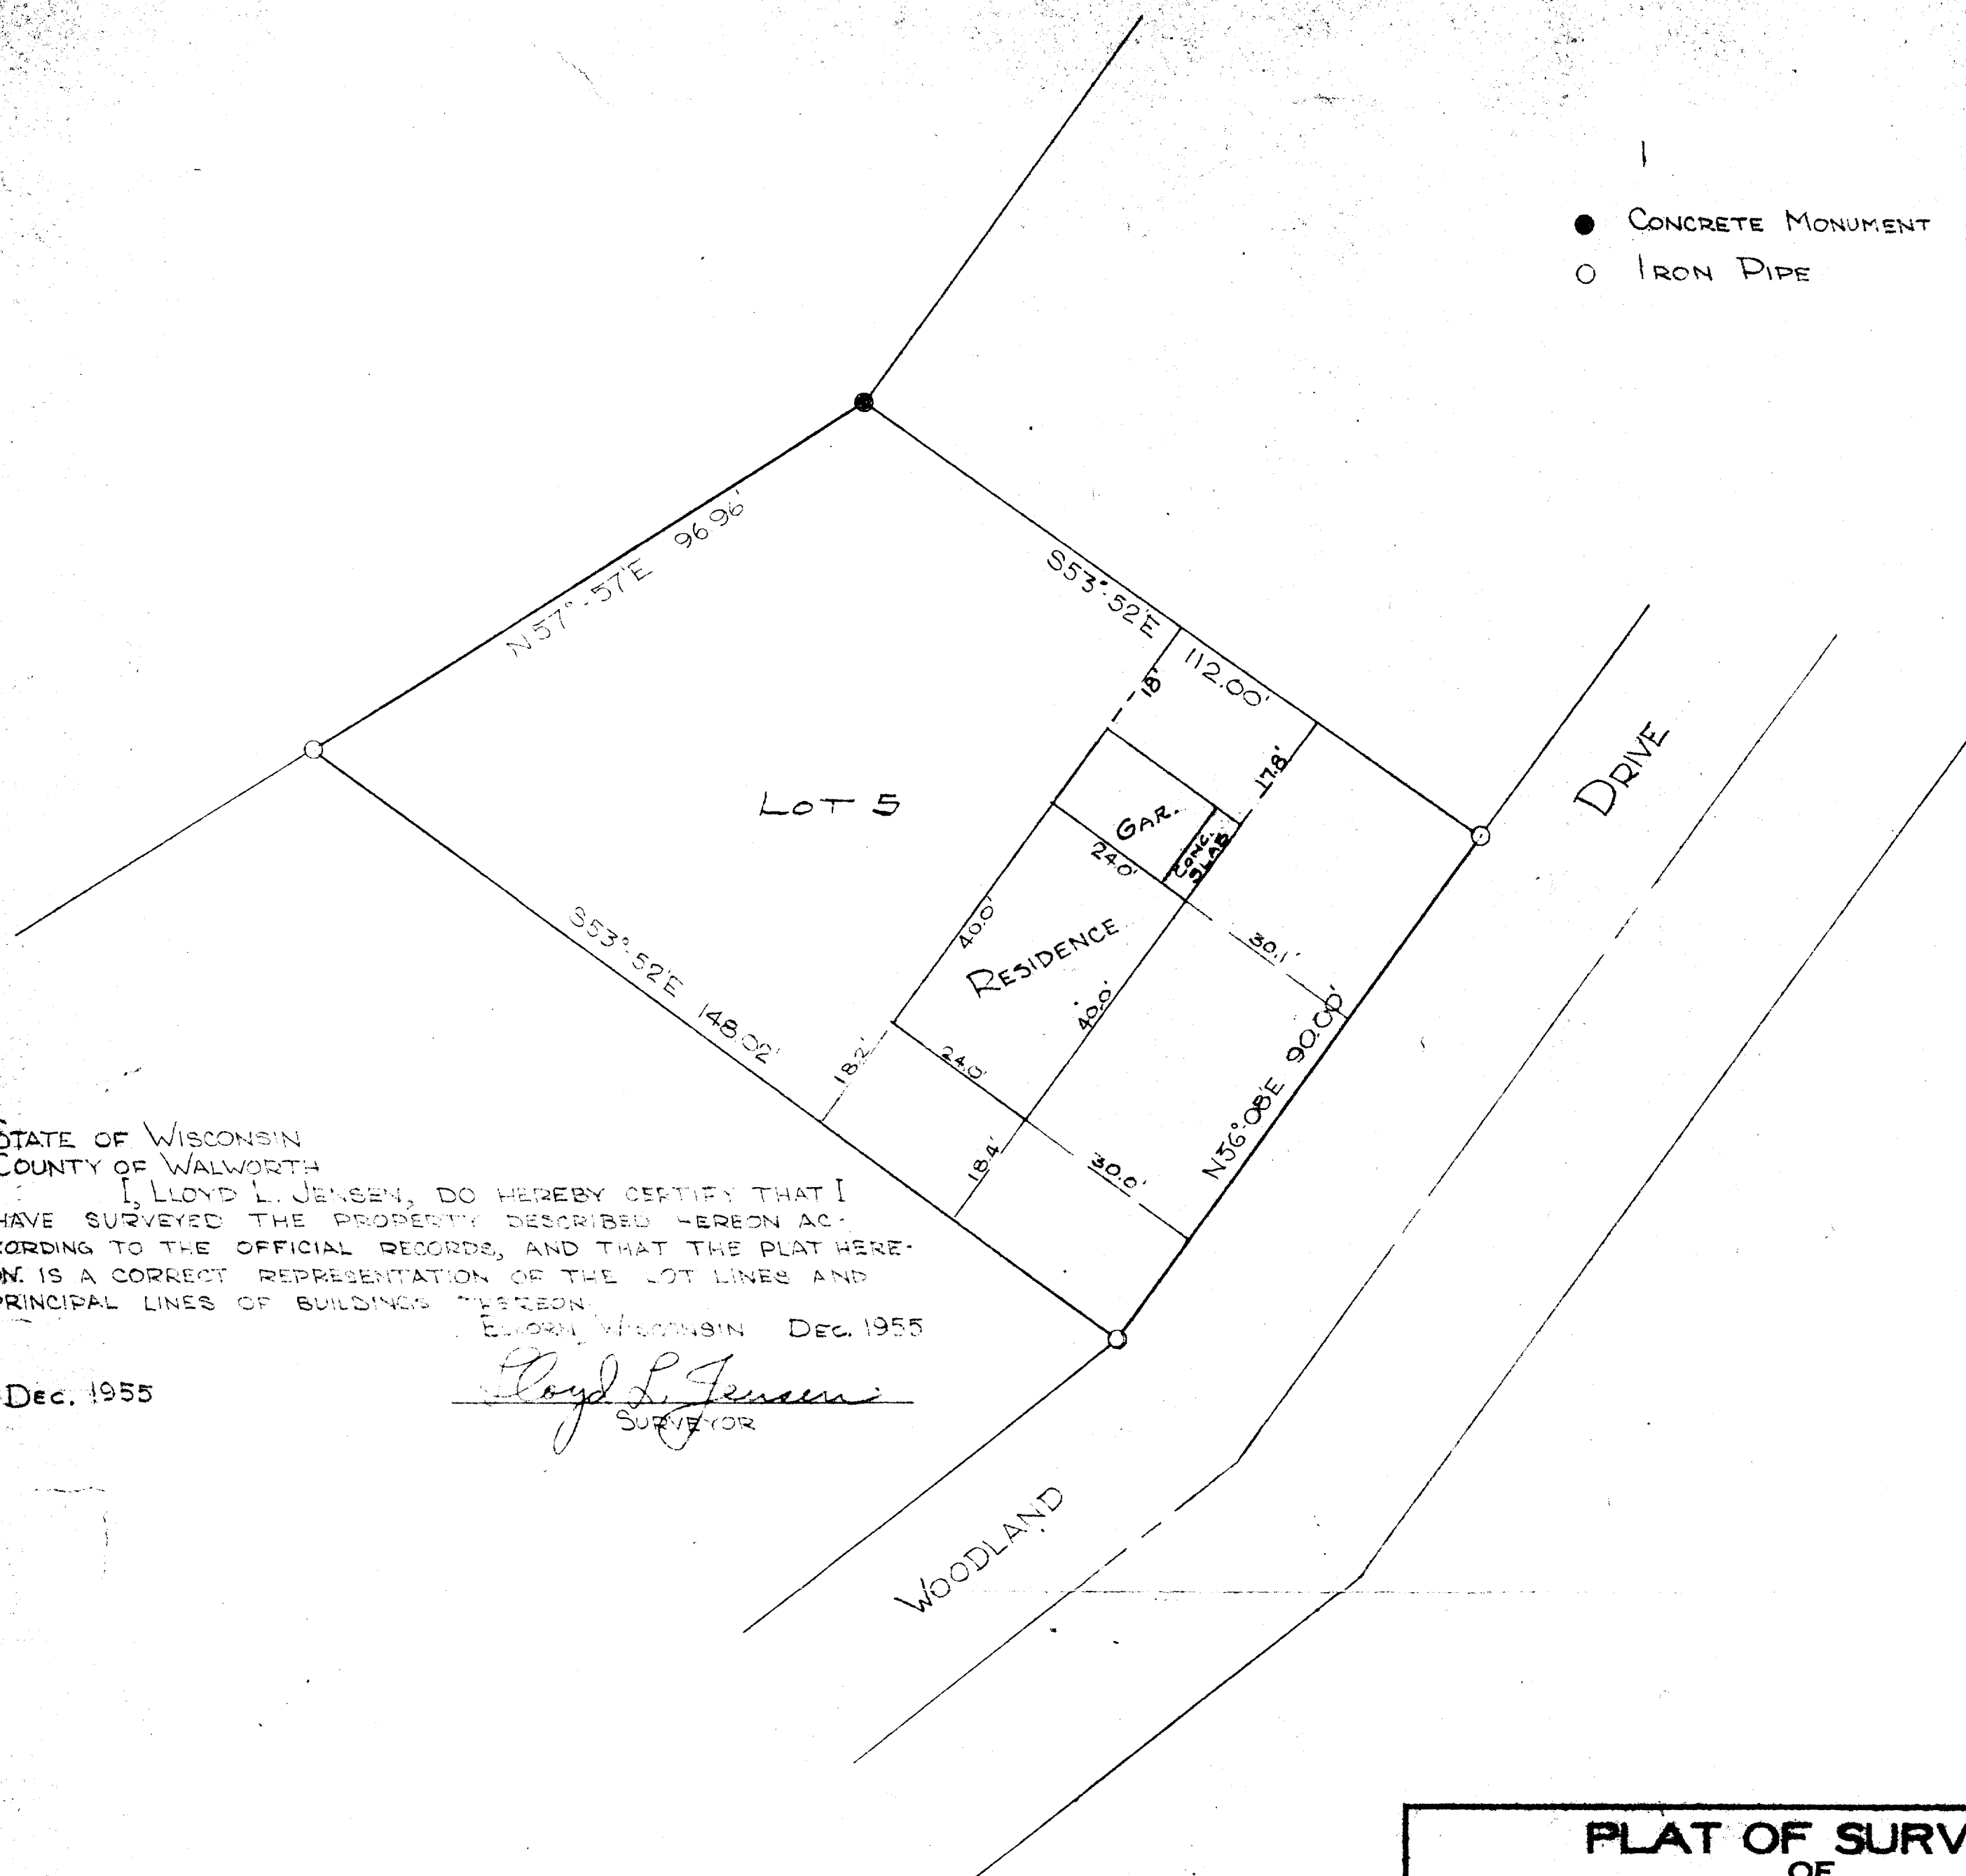

STATE OF WISCONSIN
 COUNTY OF WALWORTH
 I, LLOYD L. JENSEN, DO HEREBY CERTIFY THAT I
 HAVE SURVEYED THE PROPERTY DESCRIBED HEREON AC-
 CORDING TO THE OFFICIAL RECORDS, AND THAT THE PLAT HERE-
 ON, IS A CORRECT REPRESENTATION OF THE LOT LINES AND
 PRINCIPAL LINES OF BUILDINGS THEREON.

WISCONSIN DEC. 1955

Dec. 1955

Lloyd L. Jensen
 SURVEYOR

PLAT OF SURVEY

OF
 LOT 5

ADDITION E TO COUNTRY CLUB ESTATES
 LOCATED IN
 VILLAGE OF FONTANA, WALWORTH COUNTY, WIS.

Lloyd L. Jensen
 SURVEYOR

SCALE 1" = 20'

DATE DEC. 1955

607E-5

5-116 J