


DUNHAM SURVEYING, S.C.
SURVEYING & SUBDIVIDING
DELAVER, WISCONSIN 53115

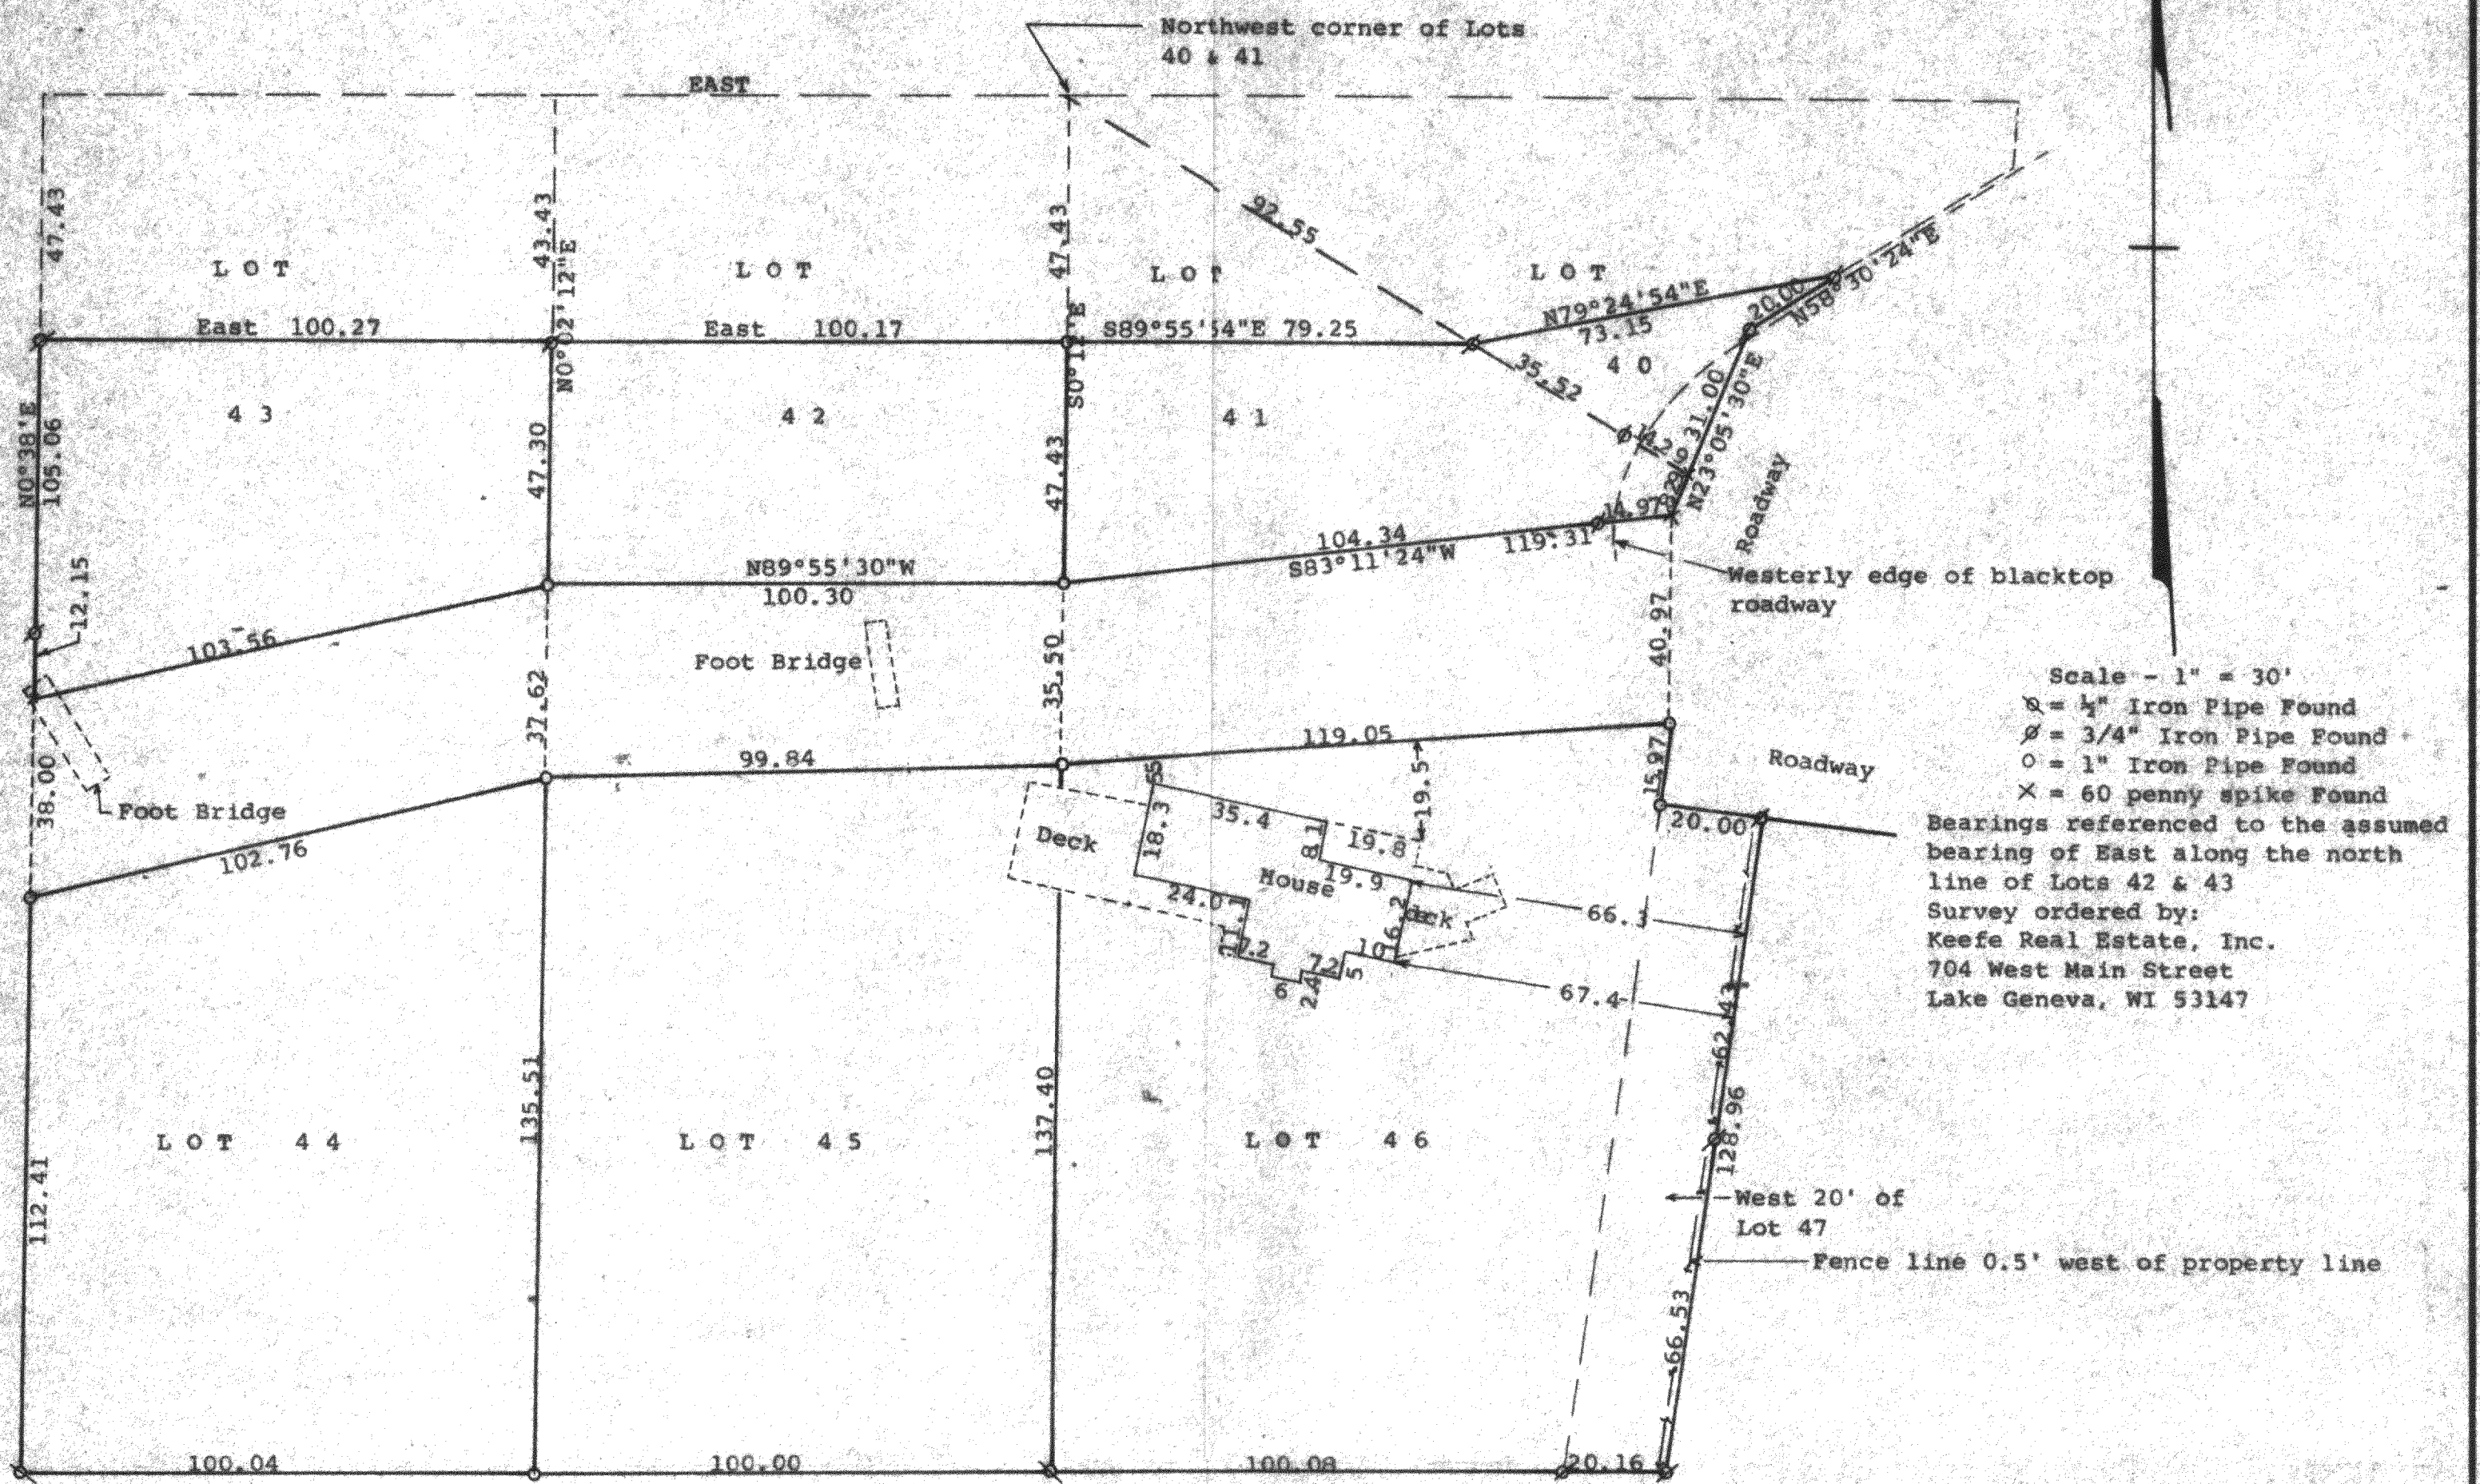

STATE OF WISCONSIN) SS
COUNTY OF WALWORTH)

I, George T. Dunham, Surveyor, certify that I have surveyed the property described as follows:

That part of Lots 40, 41, 42, and 43 of the Revised Plat of The Gardens, a subdivision located in the Village of Fontana-on-Geneva Lake, Walworth County, Wisconsin, described as follows: Lots 42 and 43, EXCEPTING THEREFROM the North 47.43 feet thereof, and the following described portion of Lots 40 and 41: Commencing at the northwest corner of said Lot 41; thence S0°12'E along the west line of said Lot 41, 47.43 feet to the place of beginning; thence S89°55'54"E 79.25 feet to the southwesterly line of said Lot 40; thence N79°24'54"E 73.15 feet to the northwesterly line of a roadway; thence S58°30'24"W along said roadway 20.00 feet; thence S23°05'30"W 31.00 feet to the corner of said Lots 40 and 41; thence continue S23°05'30"W 8.29 feet to the southeast corner of said Lot 41; thence S83°11'24"W 119.31 feet to the southwest corner of said Lot 41; thence N0°12'W along the west line of said Lot 41, 47.43 feet to the place of beginning. ALSO all of Lots 44, 45, 46 and a parcel of land 20.00 feet in width along the entire westerly side of Lot 47, all located in the Revised Plat of The Gardens, a subdivision located in the Village of Fontana-on-Geneva Lake, Walworth County, Wisconsin.

and that the plat shown hereon is a correct representation thereof and shows the size and location of the property, its exterior boundaries, the location of all visible structures and dimensions of all principal buildings thereon, boundary fences, apparent easements, roadways and visible encroachments, if any, and that I have surveyed the property hereon described, according to the official records, to the best of my knowledge and belief.

November 21, 1991

George T. Dunham
George T. Dunham, Surveyor

