


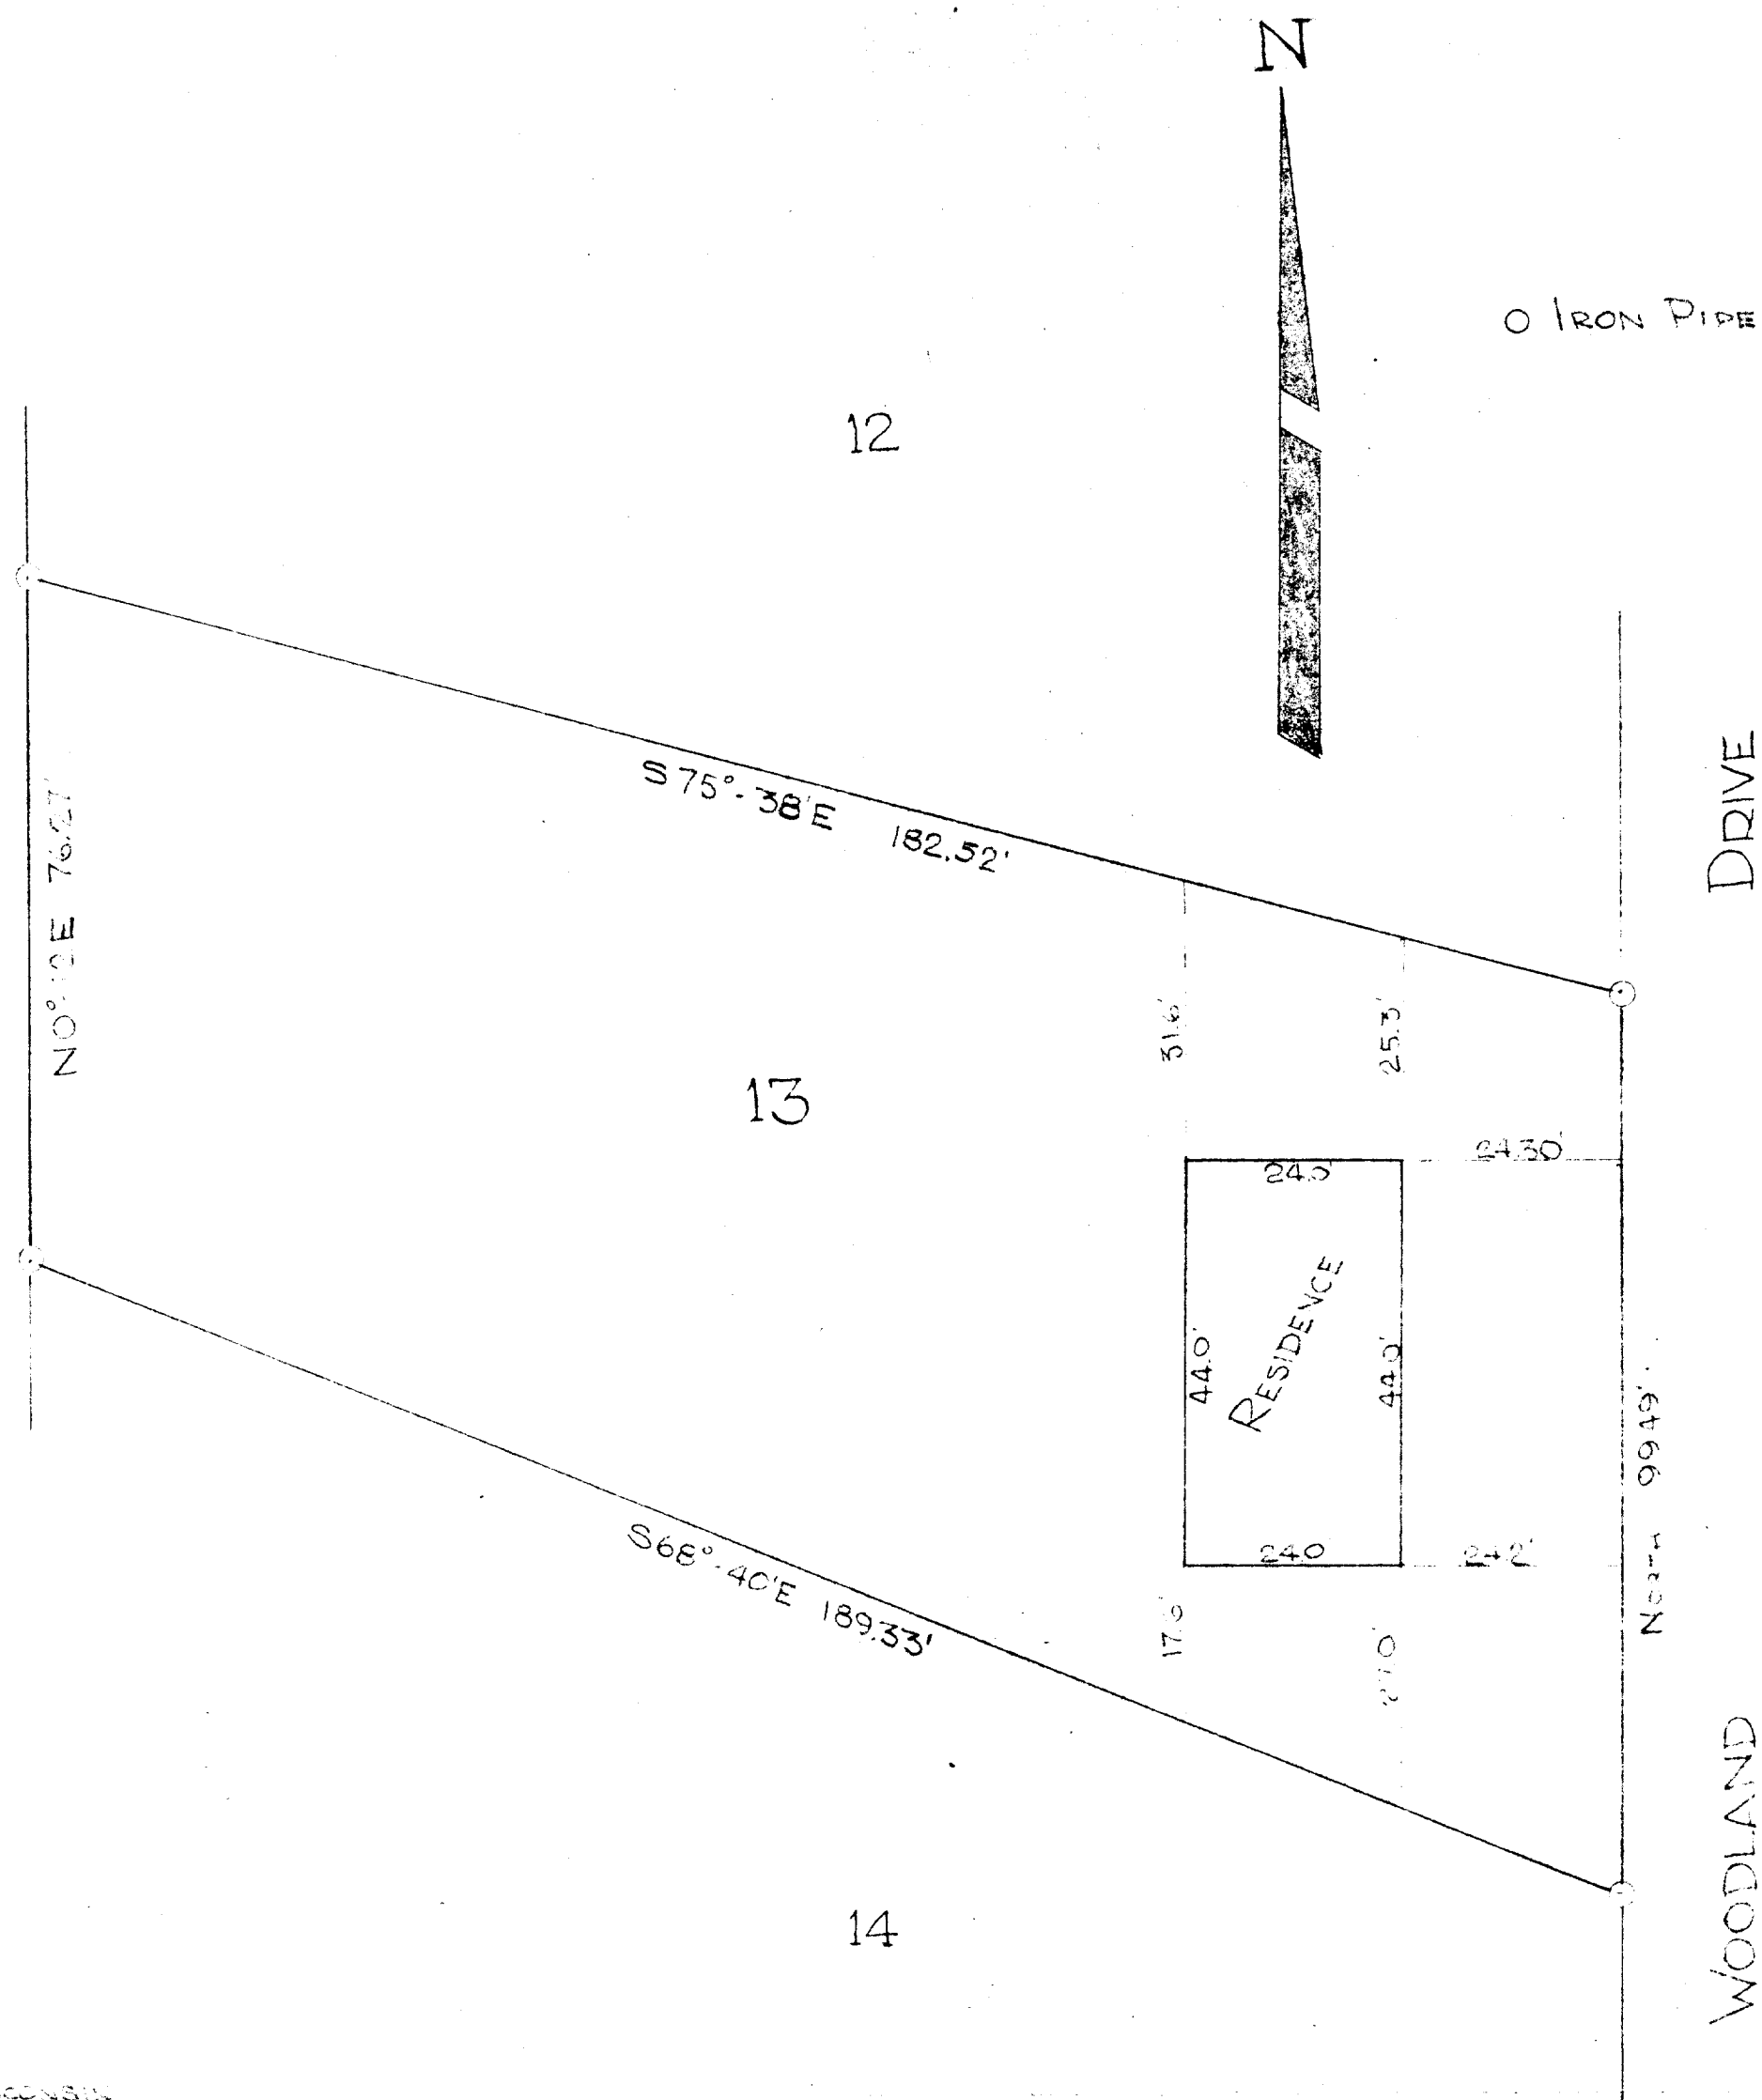

STATE OF WISCONSIN
COUNTY OF WALWORTH

I, LLOYD L. JENSEN, DO HEREBY CERTIFY THAT I HAVE SURVEYED
THE PROPERTY DESCRIBED HEREON ACCORDING TO THE OFFICIAL RE-
CORDS, AND THAT THE PLAT HEREON IS A CORRECT REPRESENTATION
OF THE LOT LINES AND PRINCIPAL LINES OF BUILDINGS THEREON
ELKORN, WISCONSIN JULY 1955

JULY 1955

Lloyd L. Jensen
SURVEYOR

**PLAT OF SURVEY
OF**

LOT 13

ADDITION D TO COUNTRY CLUB ESTATES
LOCATED IN
VILLAGE OF FONTANA, WALWORTH COUNTY, WIS.

Lloyd L. Jensen
SURVEYOR

SCALE 1" = 20'

DATE JULY 1955

5CTD-14

NO. 1727-42-3-10-51

5-117J