


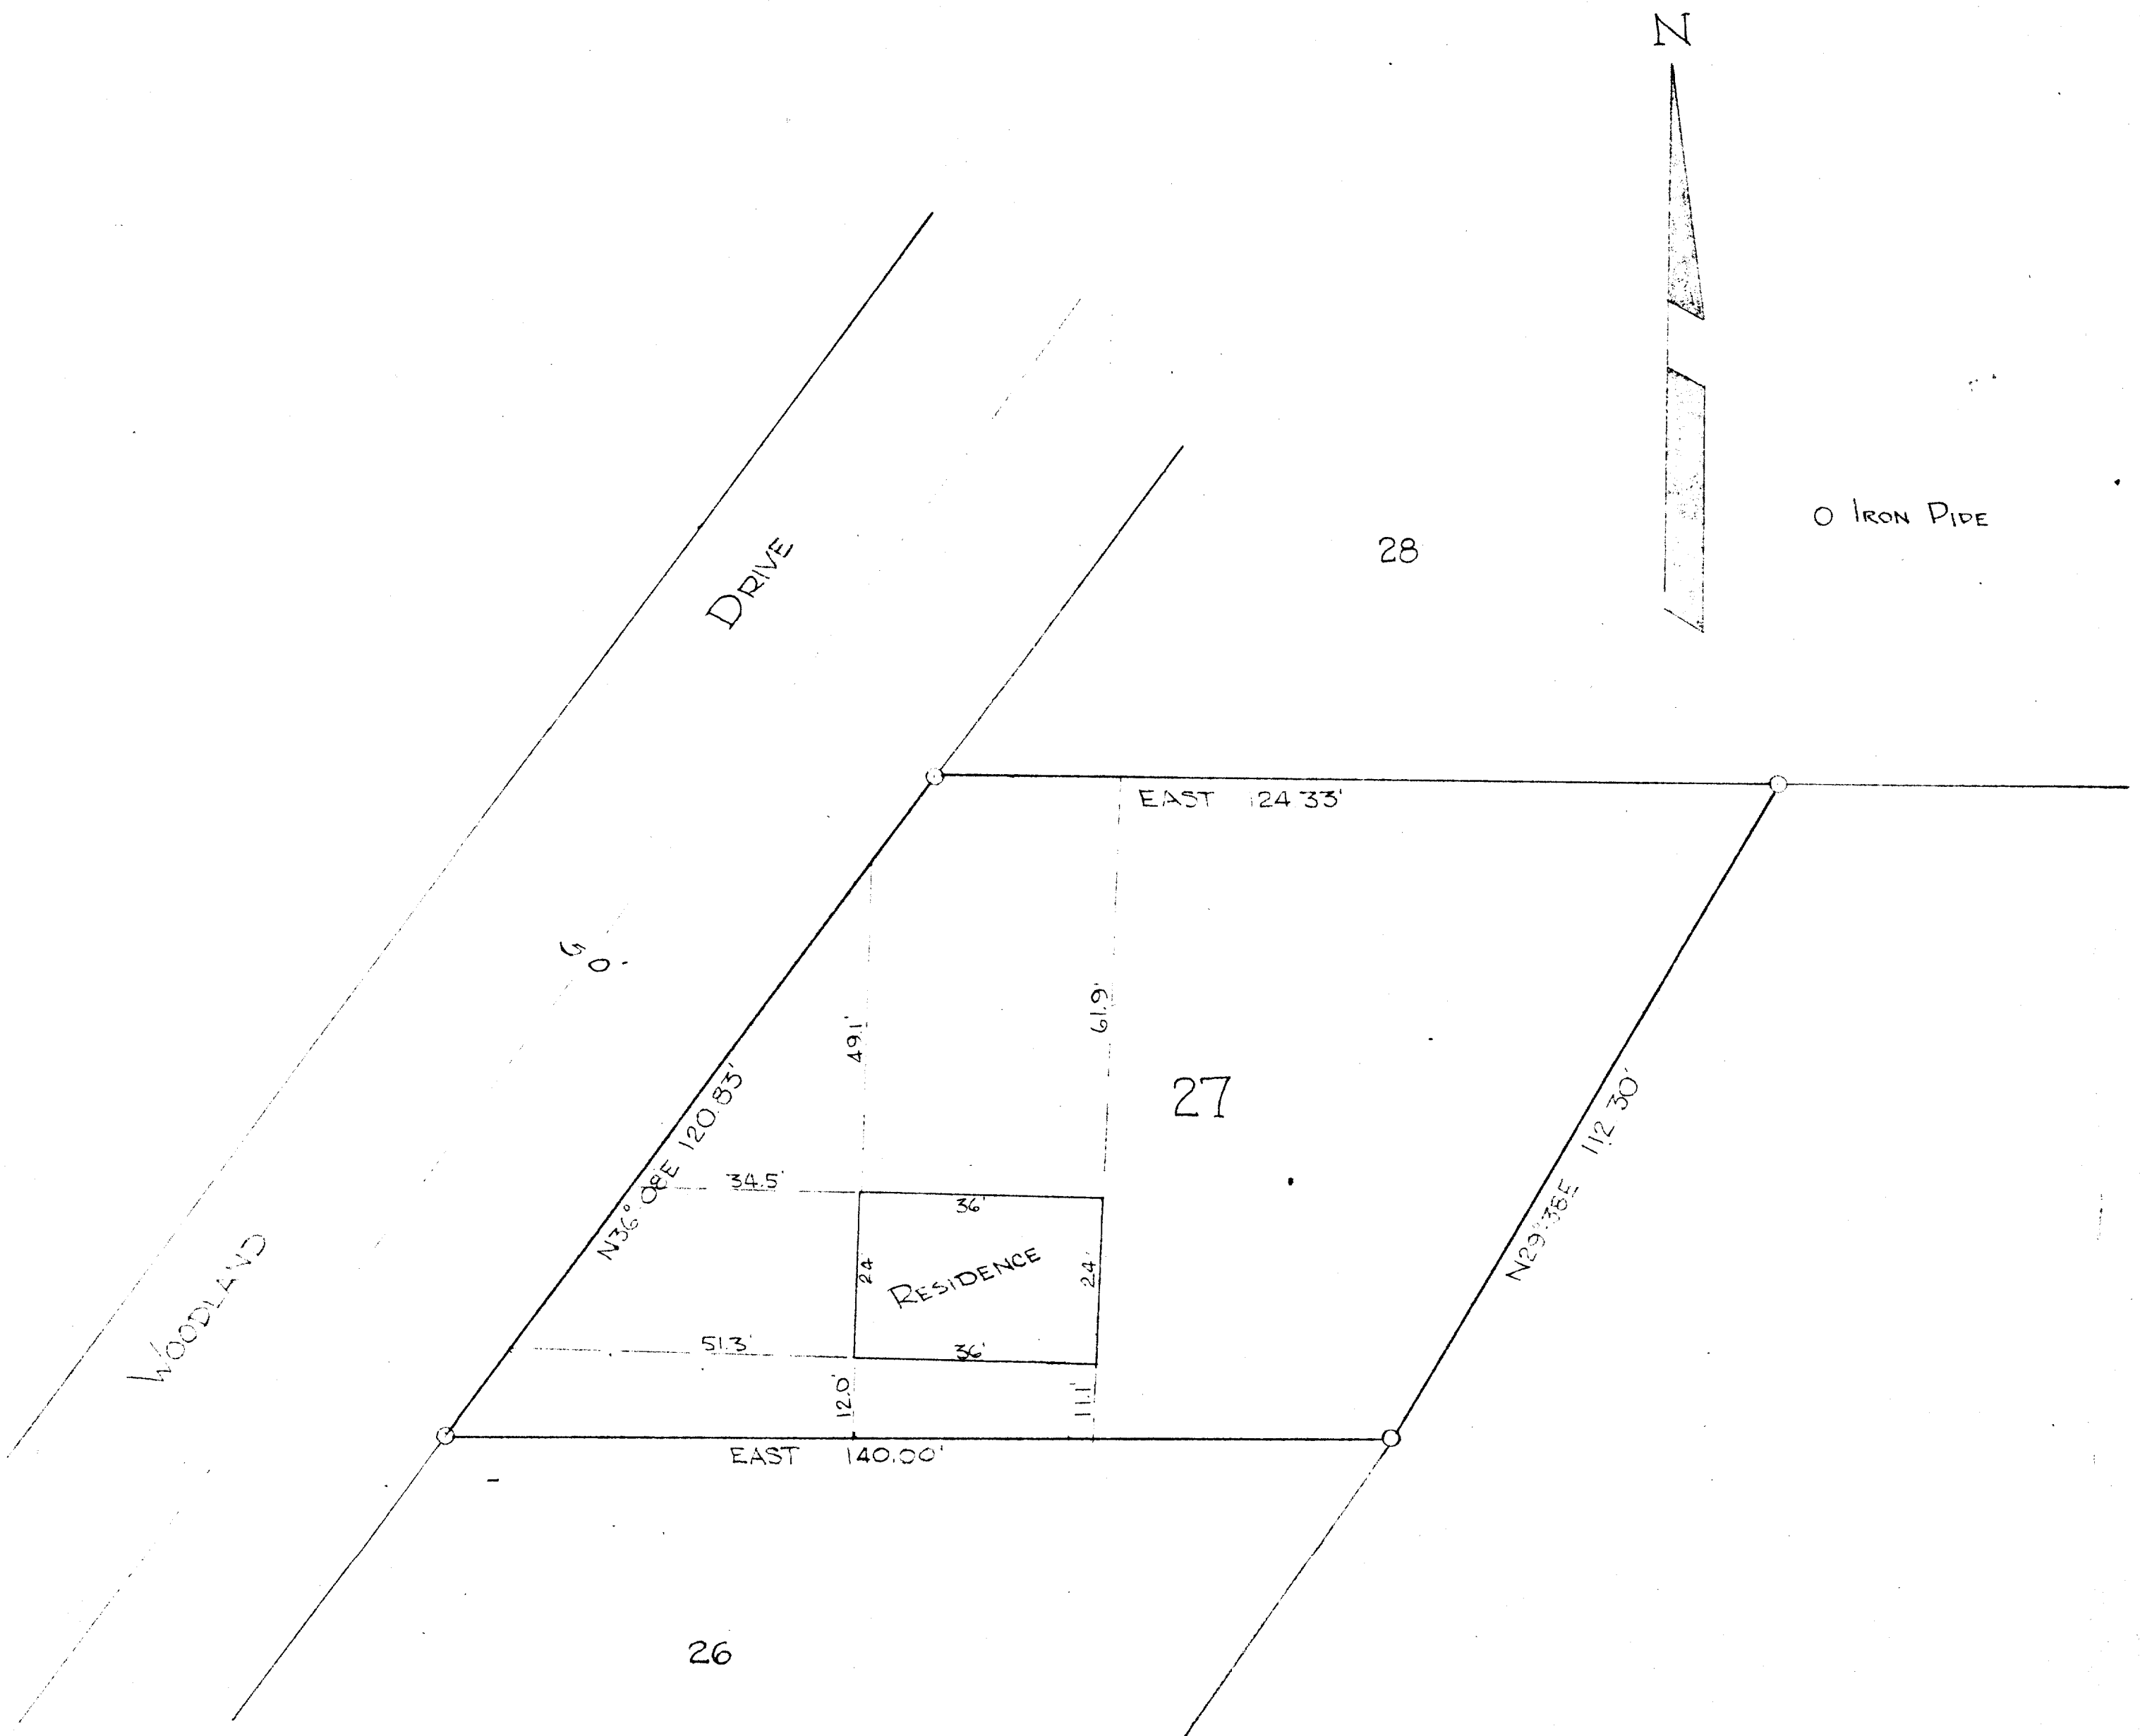

STATE OF WISCONSIN
COUNTY OF WALWORTH

I, LLOYD L. JENSEN, DO HEREBY CERTIFY THAT I HAVE
SURVEYED THE PROPERTY DESCRIBED HEREON ACCORDING TO THE
OFFICIAL RECORDS, AND THAT THE PLAT HEREON IS A CORRECT RE-
PRESENTATION OF THE LOT LINES AND PRINCIPAL LINES OF BUILD-
INGS THEREON

JULY 1955

ELKORN, WISCONSIN JULY 1955

Lloyd L. Jensen
SURVEYOR

PLAT OF SURVEY OF

LOT 27

ADDITION E TO COUNTRY CLUB ESTATES
LOCATED IN
VILLAGE OF FONTANA, WALWORTH COUNTY, WIS.

Lloyd L. Jensen
SURVEYOR

SCALE 1" = 20'

DATE July 1955