


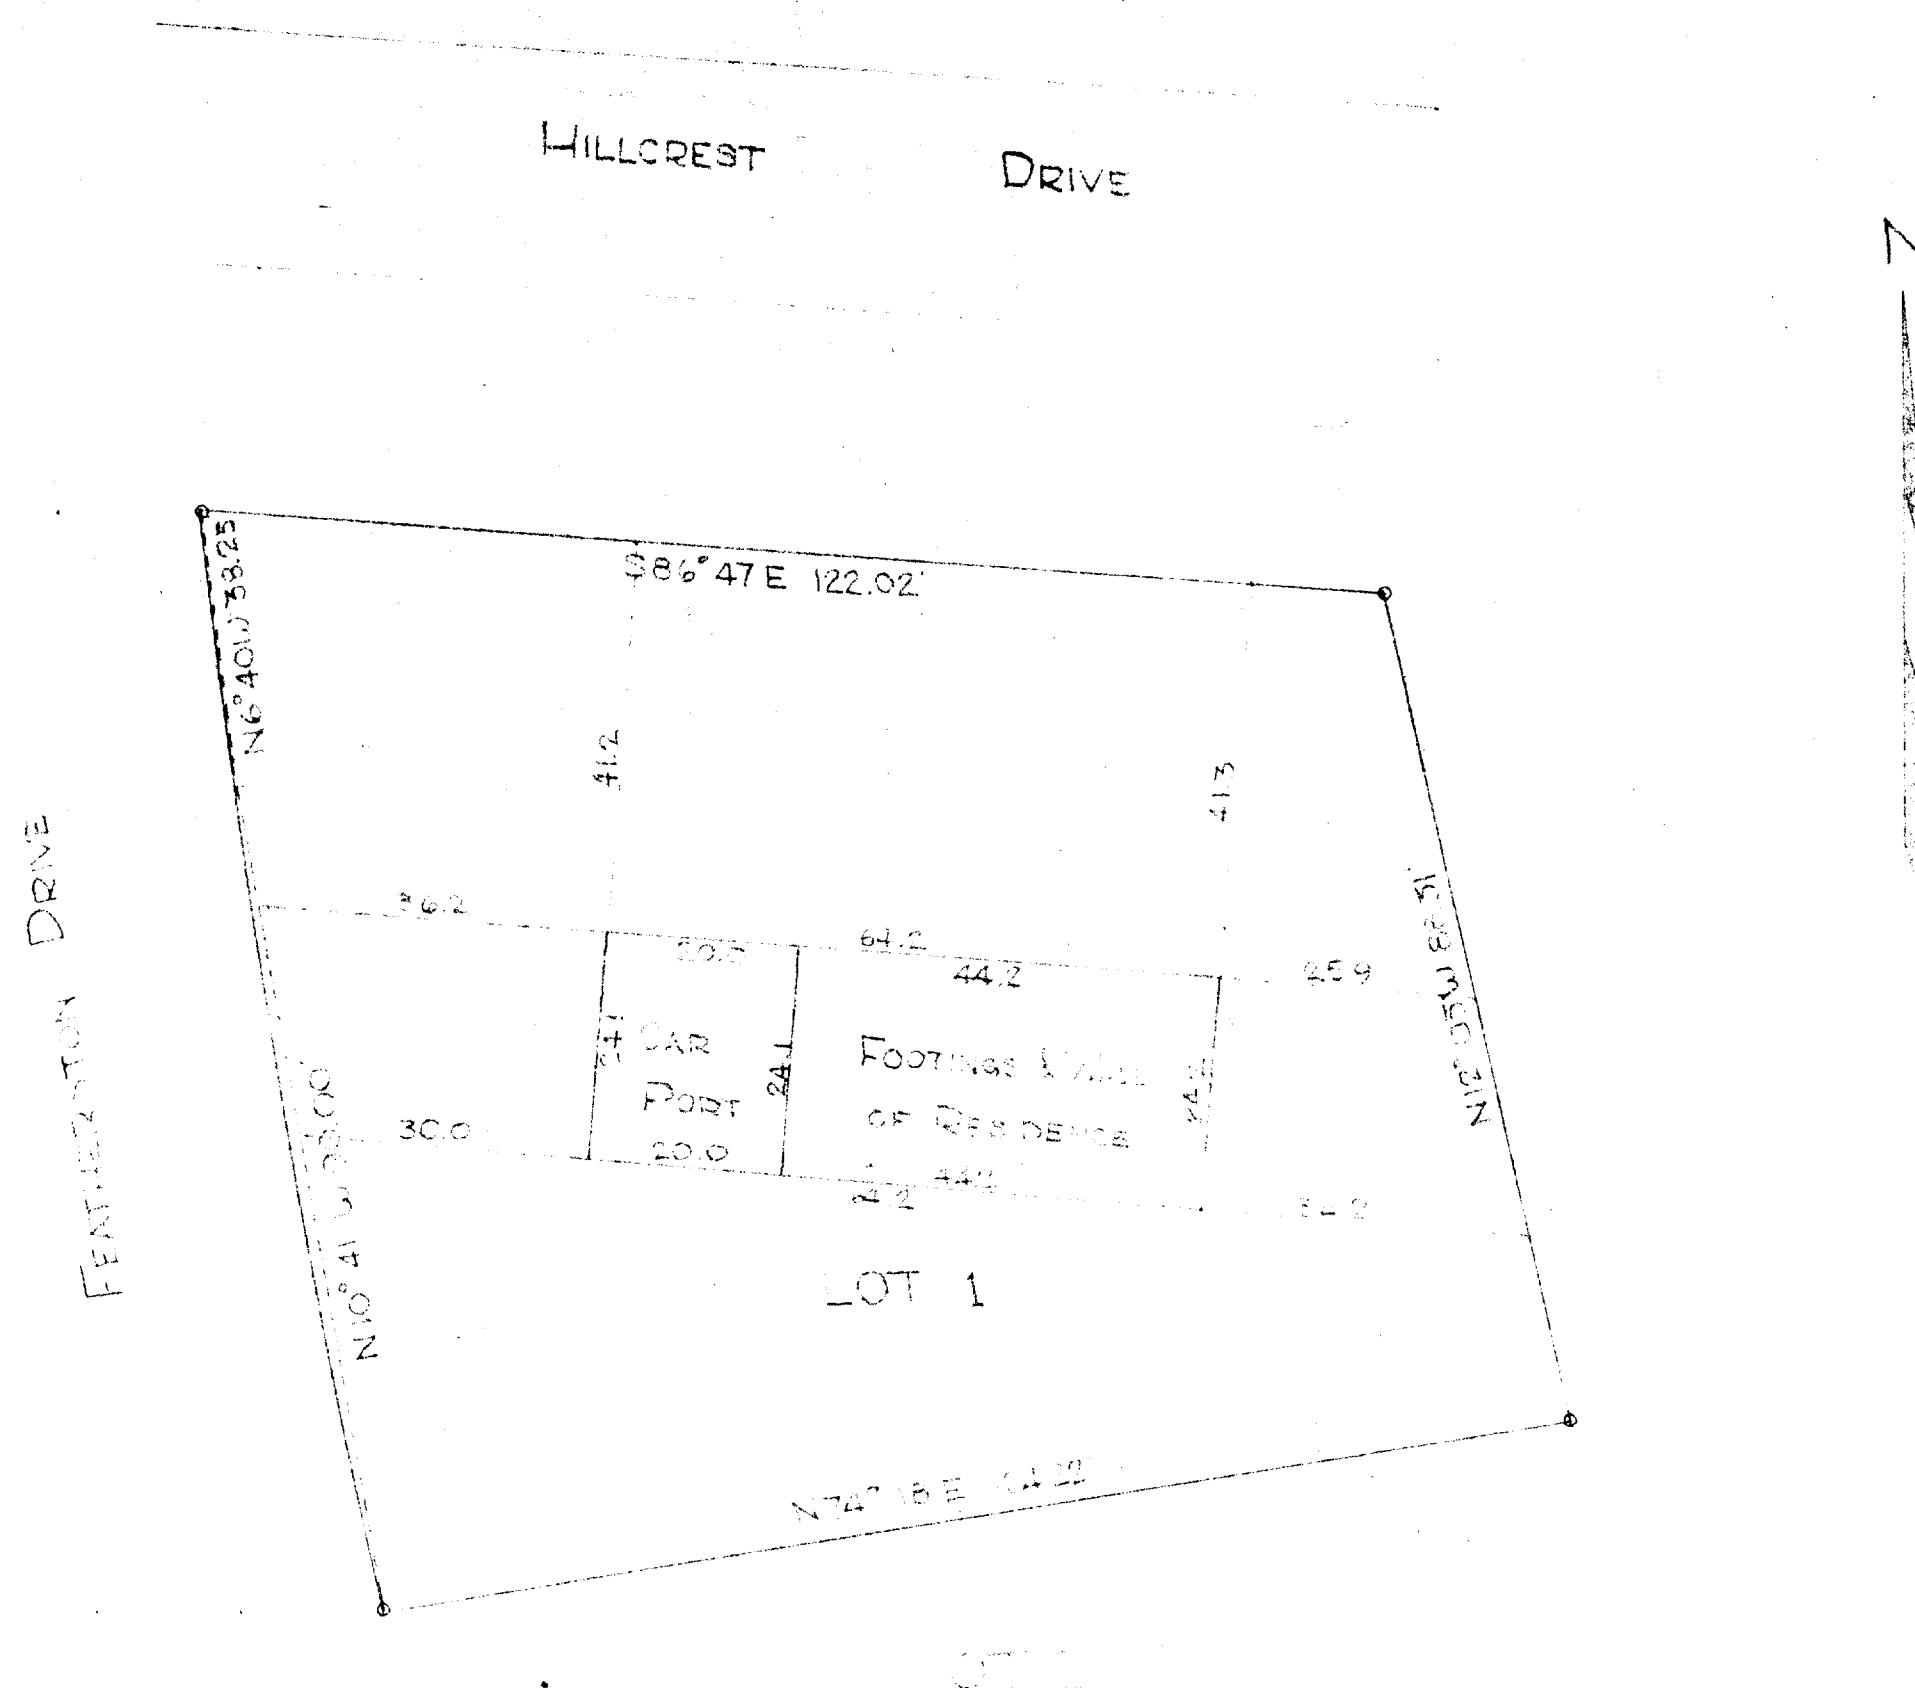

STATE OF WISCONSIN
COUNTY OF WALWORTH

I, LLOYD L. JENSEN, DO HEREBY CERTIFY THAT I HAVE SURVEYED
THE PROPERTY DESCRIBED HEREON ACCORDING TO THE OFFICIAL RECORDS, AND
THAT THE PLAT HEREON IS A CORRECT REPRESENTATION OF THE LOT LINES
AND PRINCIPAL LINES OF BUILDINGS THEREON

ELKHORN, WISCONSIN MAY 4, 1955

Lloyd L. Jensen
SURVEYOR

PLAT OF SURVEY
OF
LOT 1 OF ADDITION "A"
TO COUNTRY CLUB ESTATES
LOCATED IN THE
VILLAGE OF FONTANA ON GENEVA LAKE
WALWORTH COUNTY WISCONSIN

Lloyd L. Jensen
SURVEYOR

SCALE 1" = 20'

DATE MAY 4 1955

SCTA-1