


GEORGE T. DUNHAM
SURVEYING & SUBDIVIDING
DELAVER, WISCONSIN

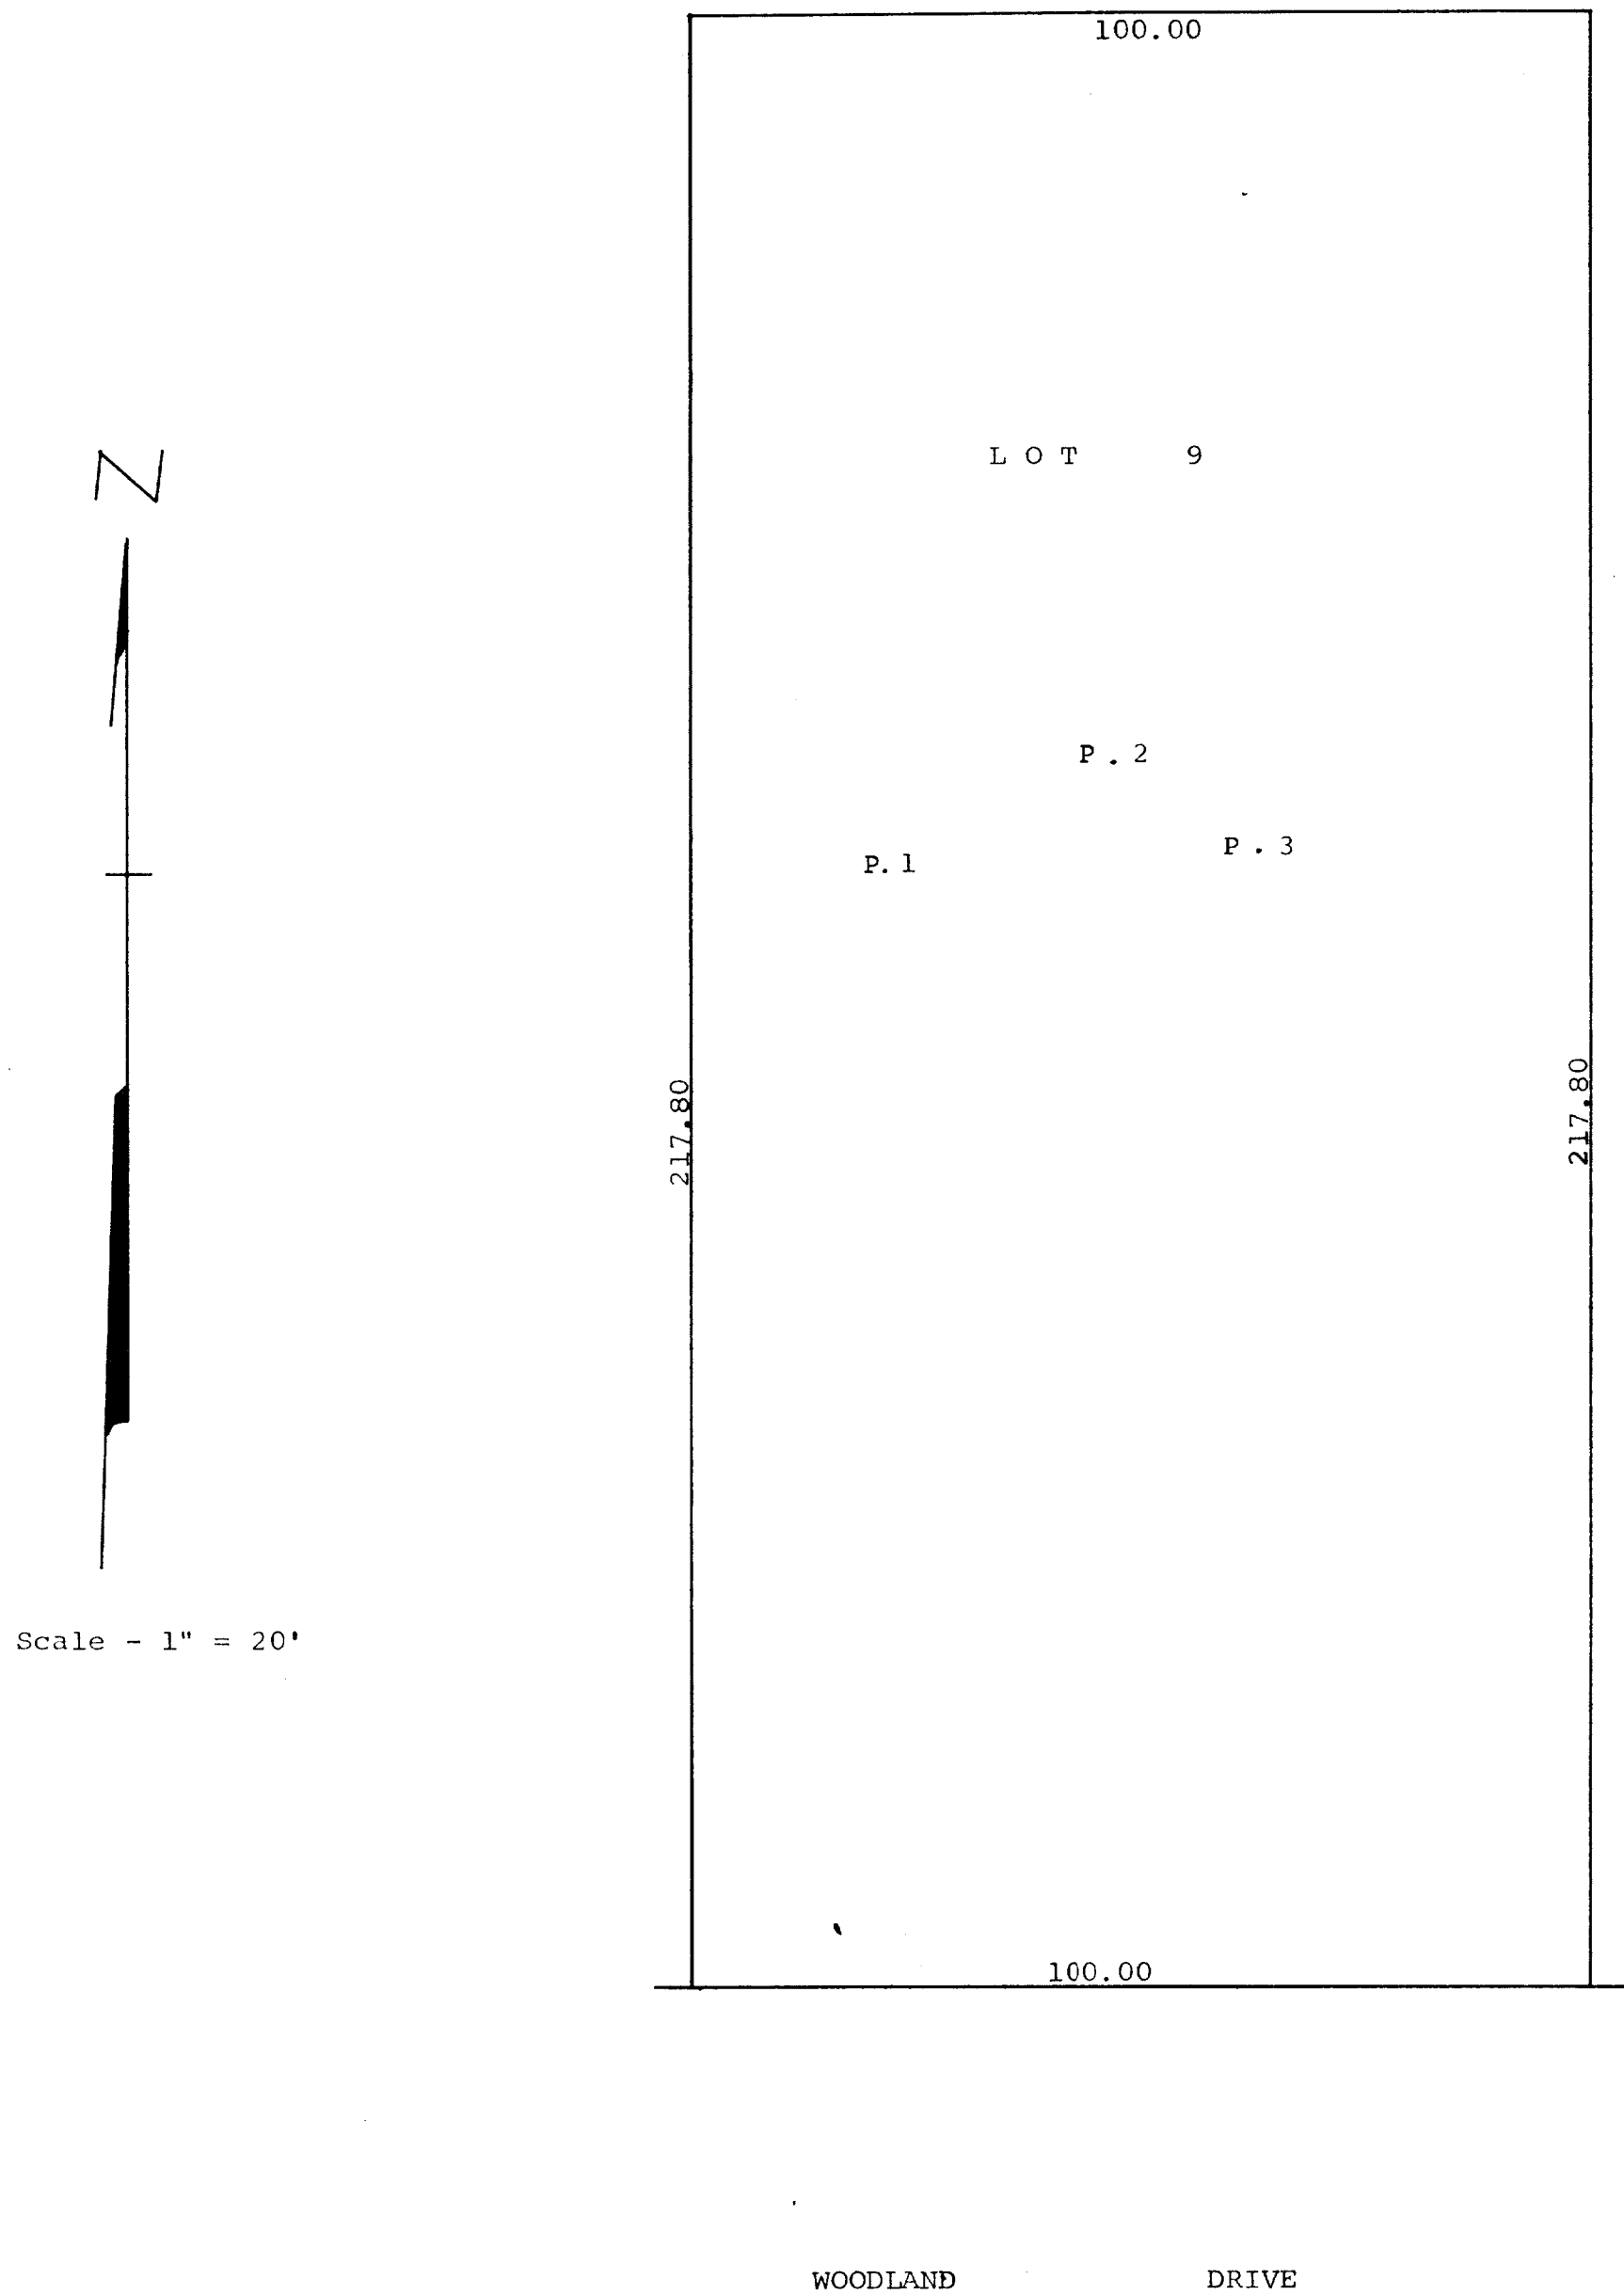

Plat showing the location of the percolation tests
made on Lot 9, Block 3, Brookwood Subdivision located
in the Village of Fontana, Walworth County, Wisconsin.
May 3, 1969

George T. Dunham
George T. Dunham, Surveyor