
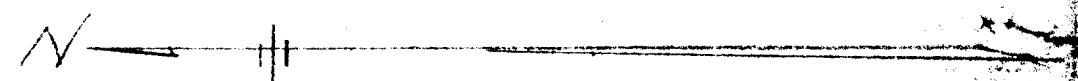


NORTH LINE OF LOT 1
D. H. REID'S ADD. TO
EAST 100' WIDE, EXTENDED

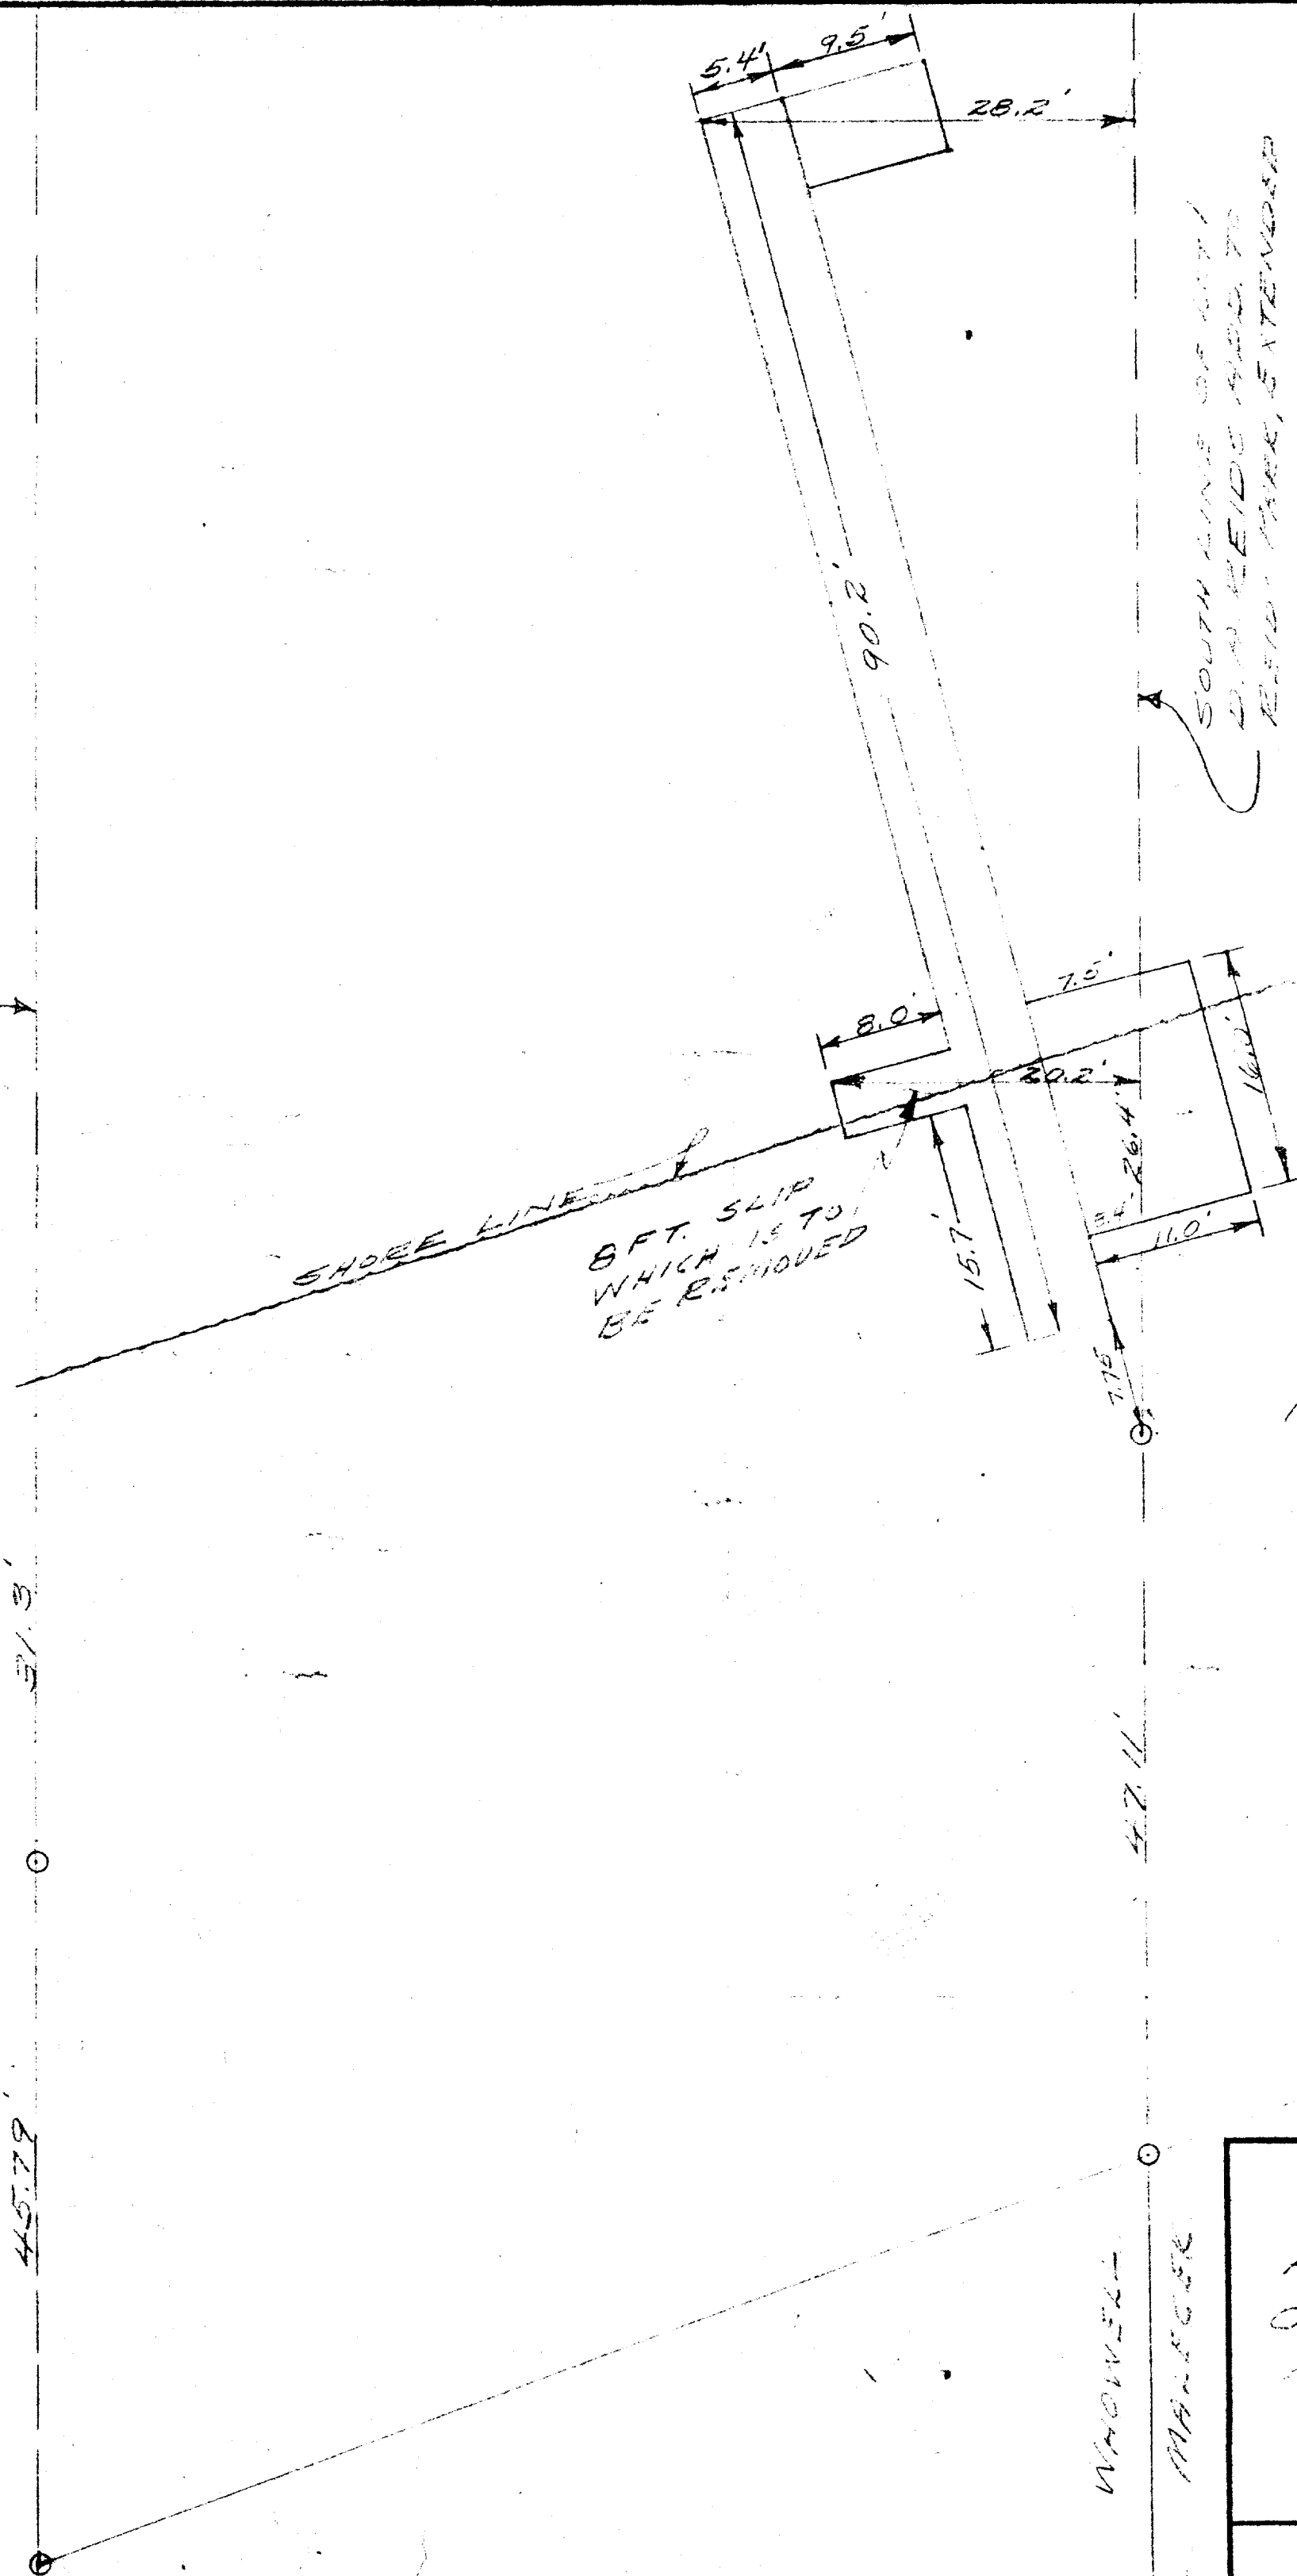

PLAT OF SURVEY OF

PIER LOCATION OF
OTTO WAGNER'S PIER
FONTANA, WISCONSIN

SCALE 1" = 10'

DATE 5-7-56

5-124