


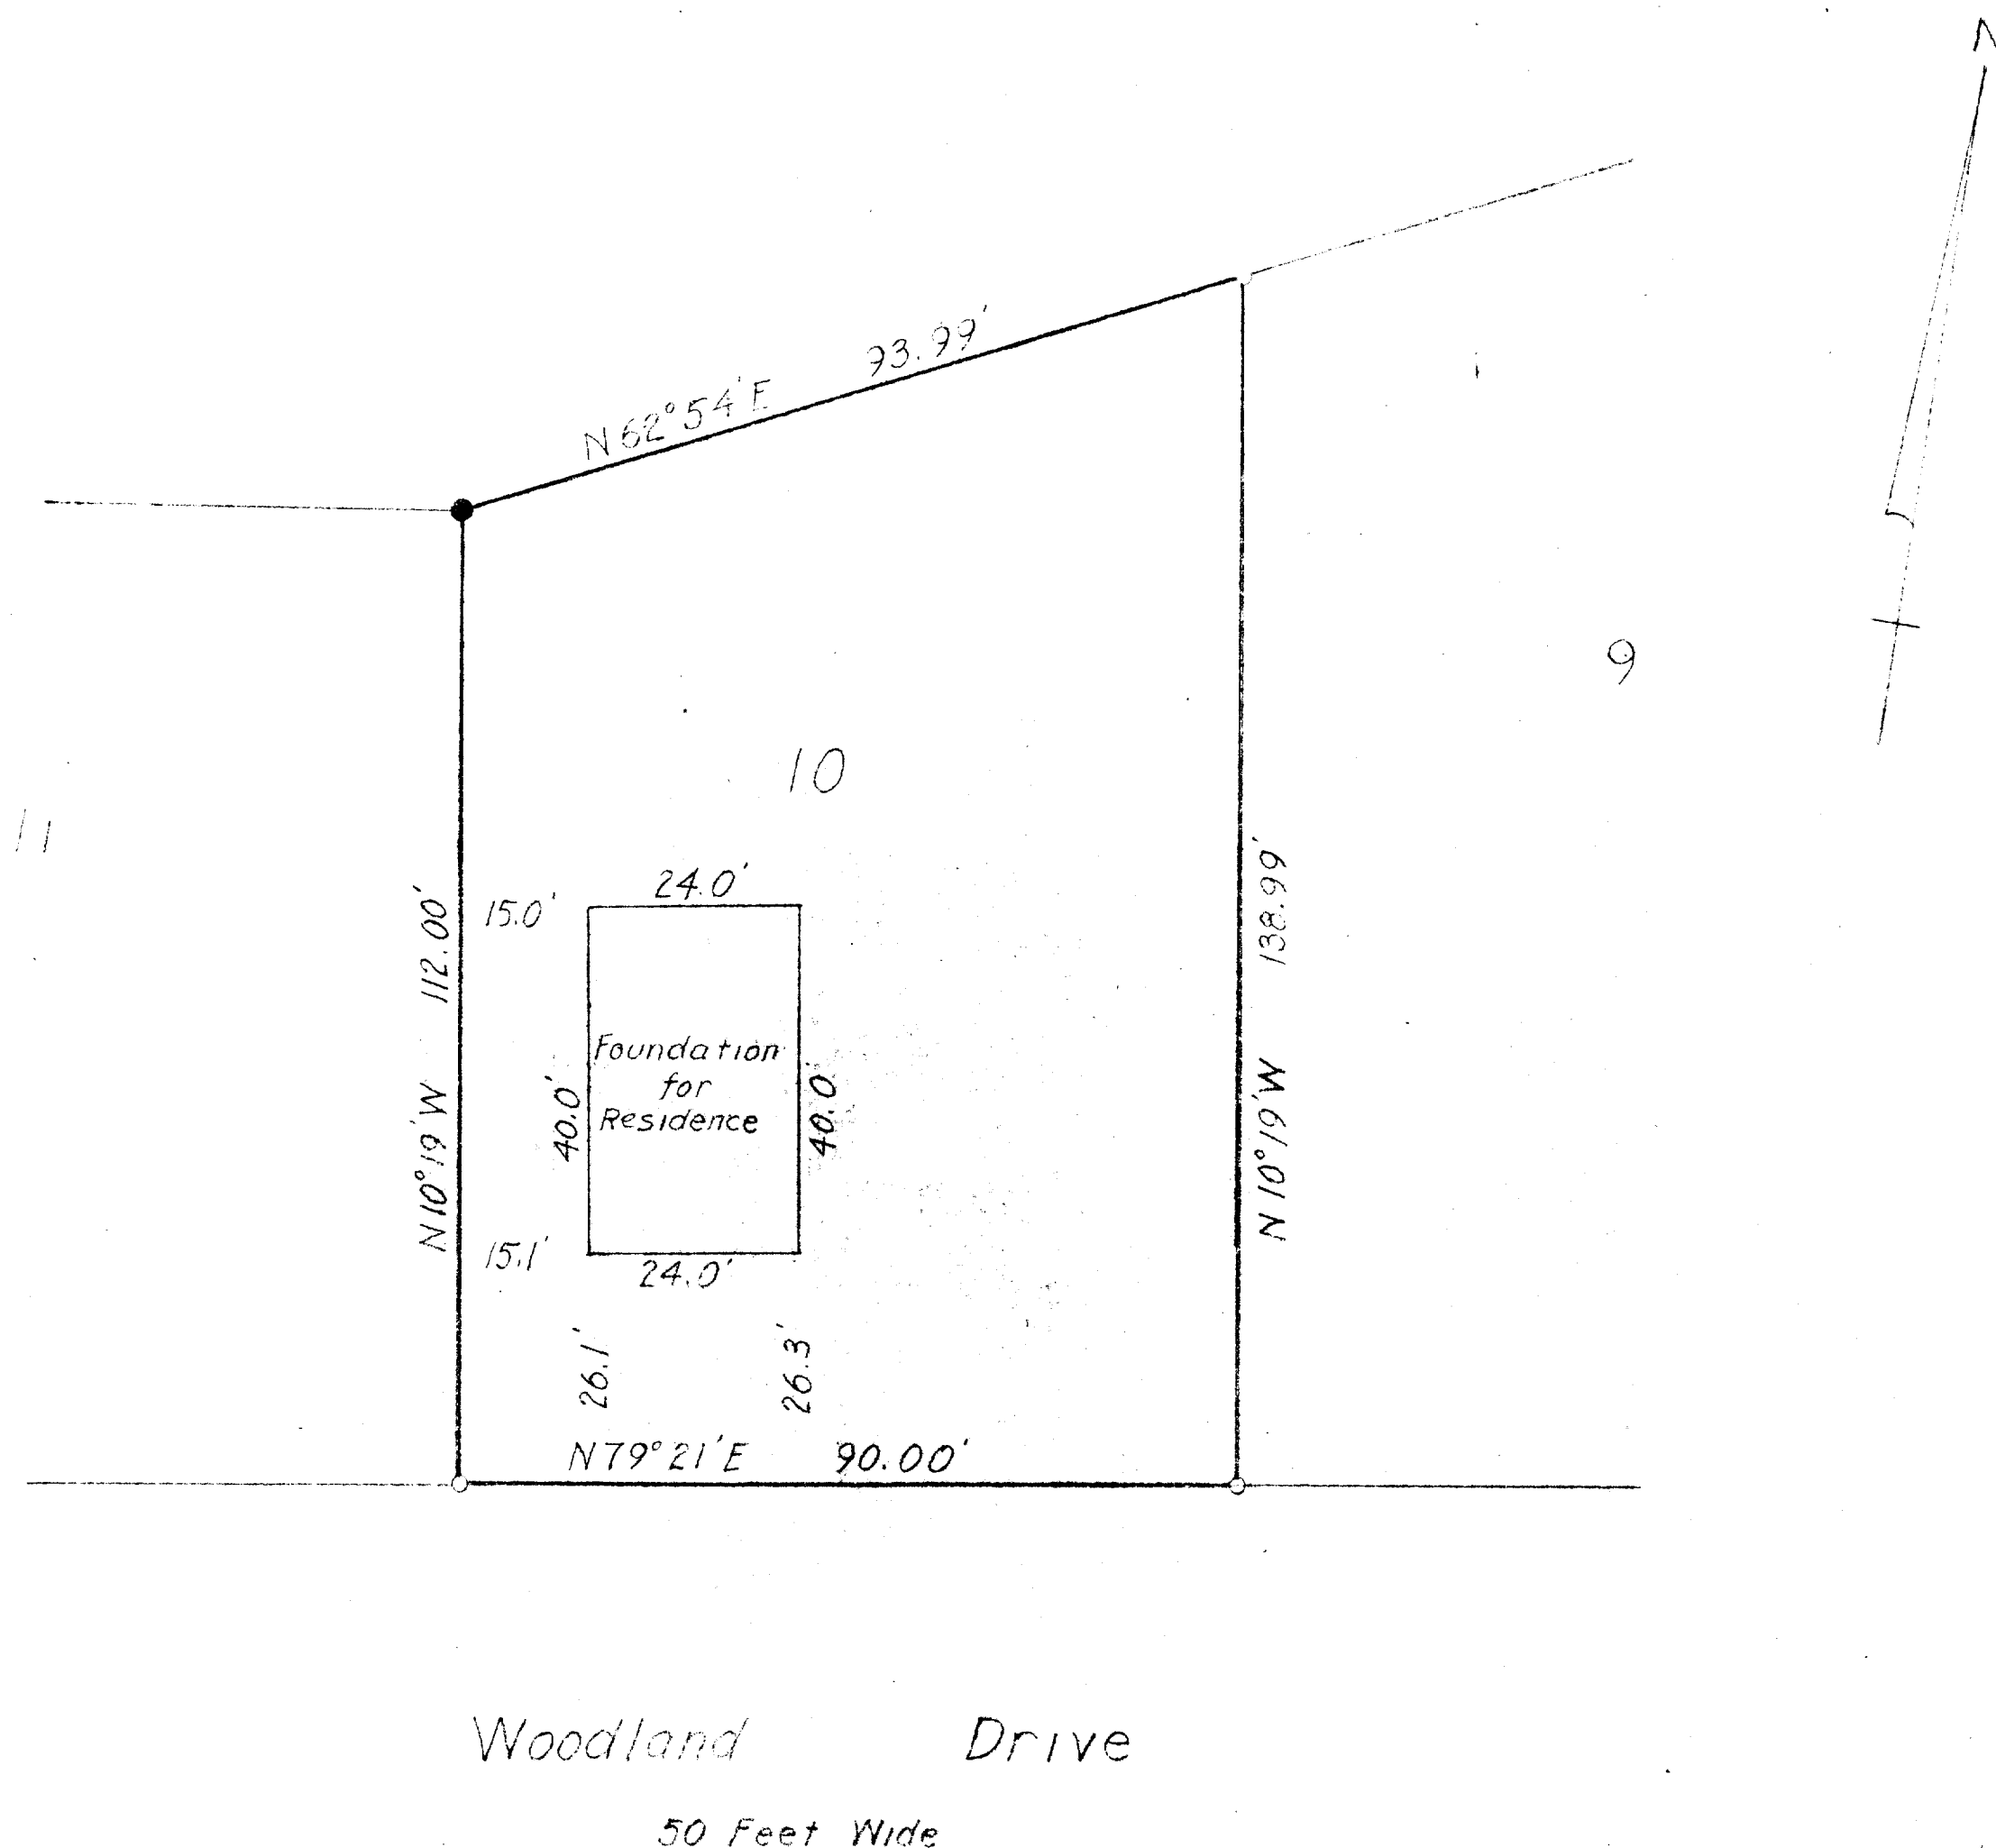

● - Concrete Monument
○ - Iron Pipe

PLAT OF SURVEY OF

Lot 10 of Addition E to the Country Club Estates, in the Village of Fontana - on Geneva Lake, Walworth County, Wisconsin.

State of Wisconsin } ss
County of Walworth }

I, Lloyd L. Jensen, do hereby certify that I have surveyed the property described herein according to the official records, and that the plat above is a correct representation of the Lot lines and principal lines of buildings thereon.

Lloyd L. Jensen
(Lloyd L. Jensen) County Surveyor

Lloyd L. Jensen
SURVEYOR

SCALE 1" = 20'

DATE Dec, 1956