


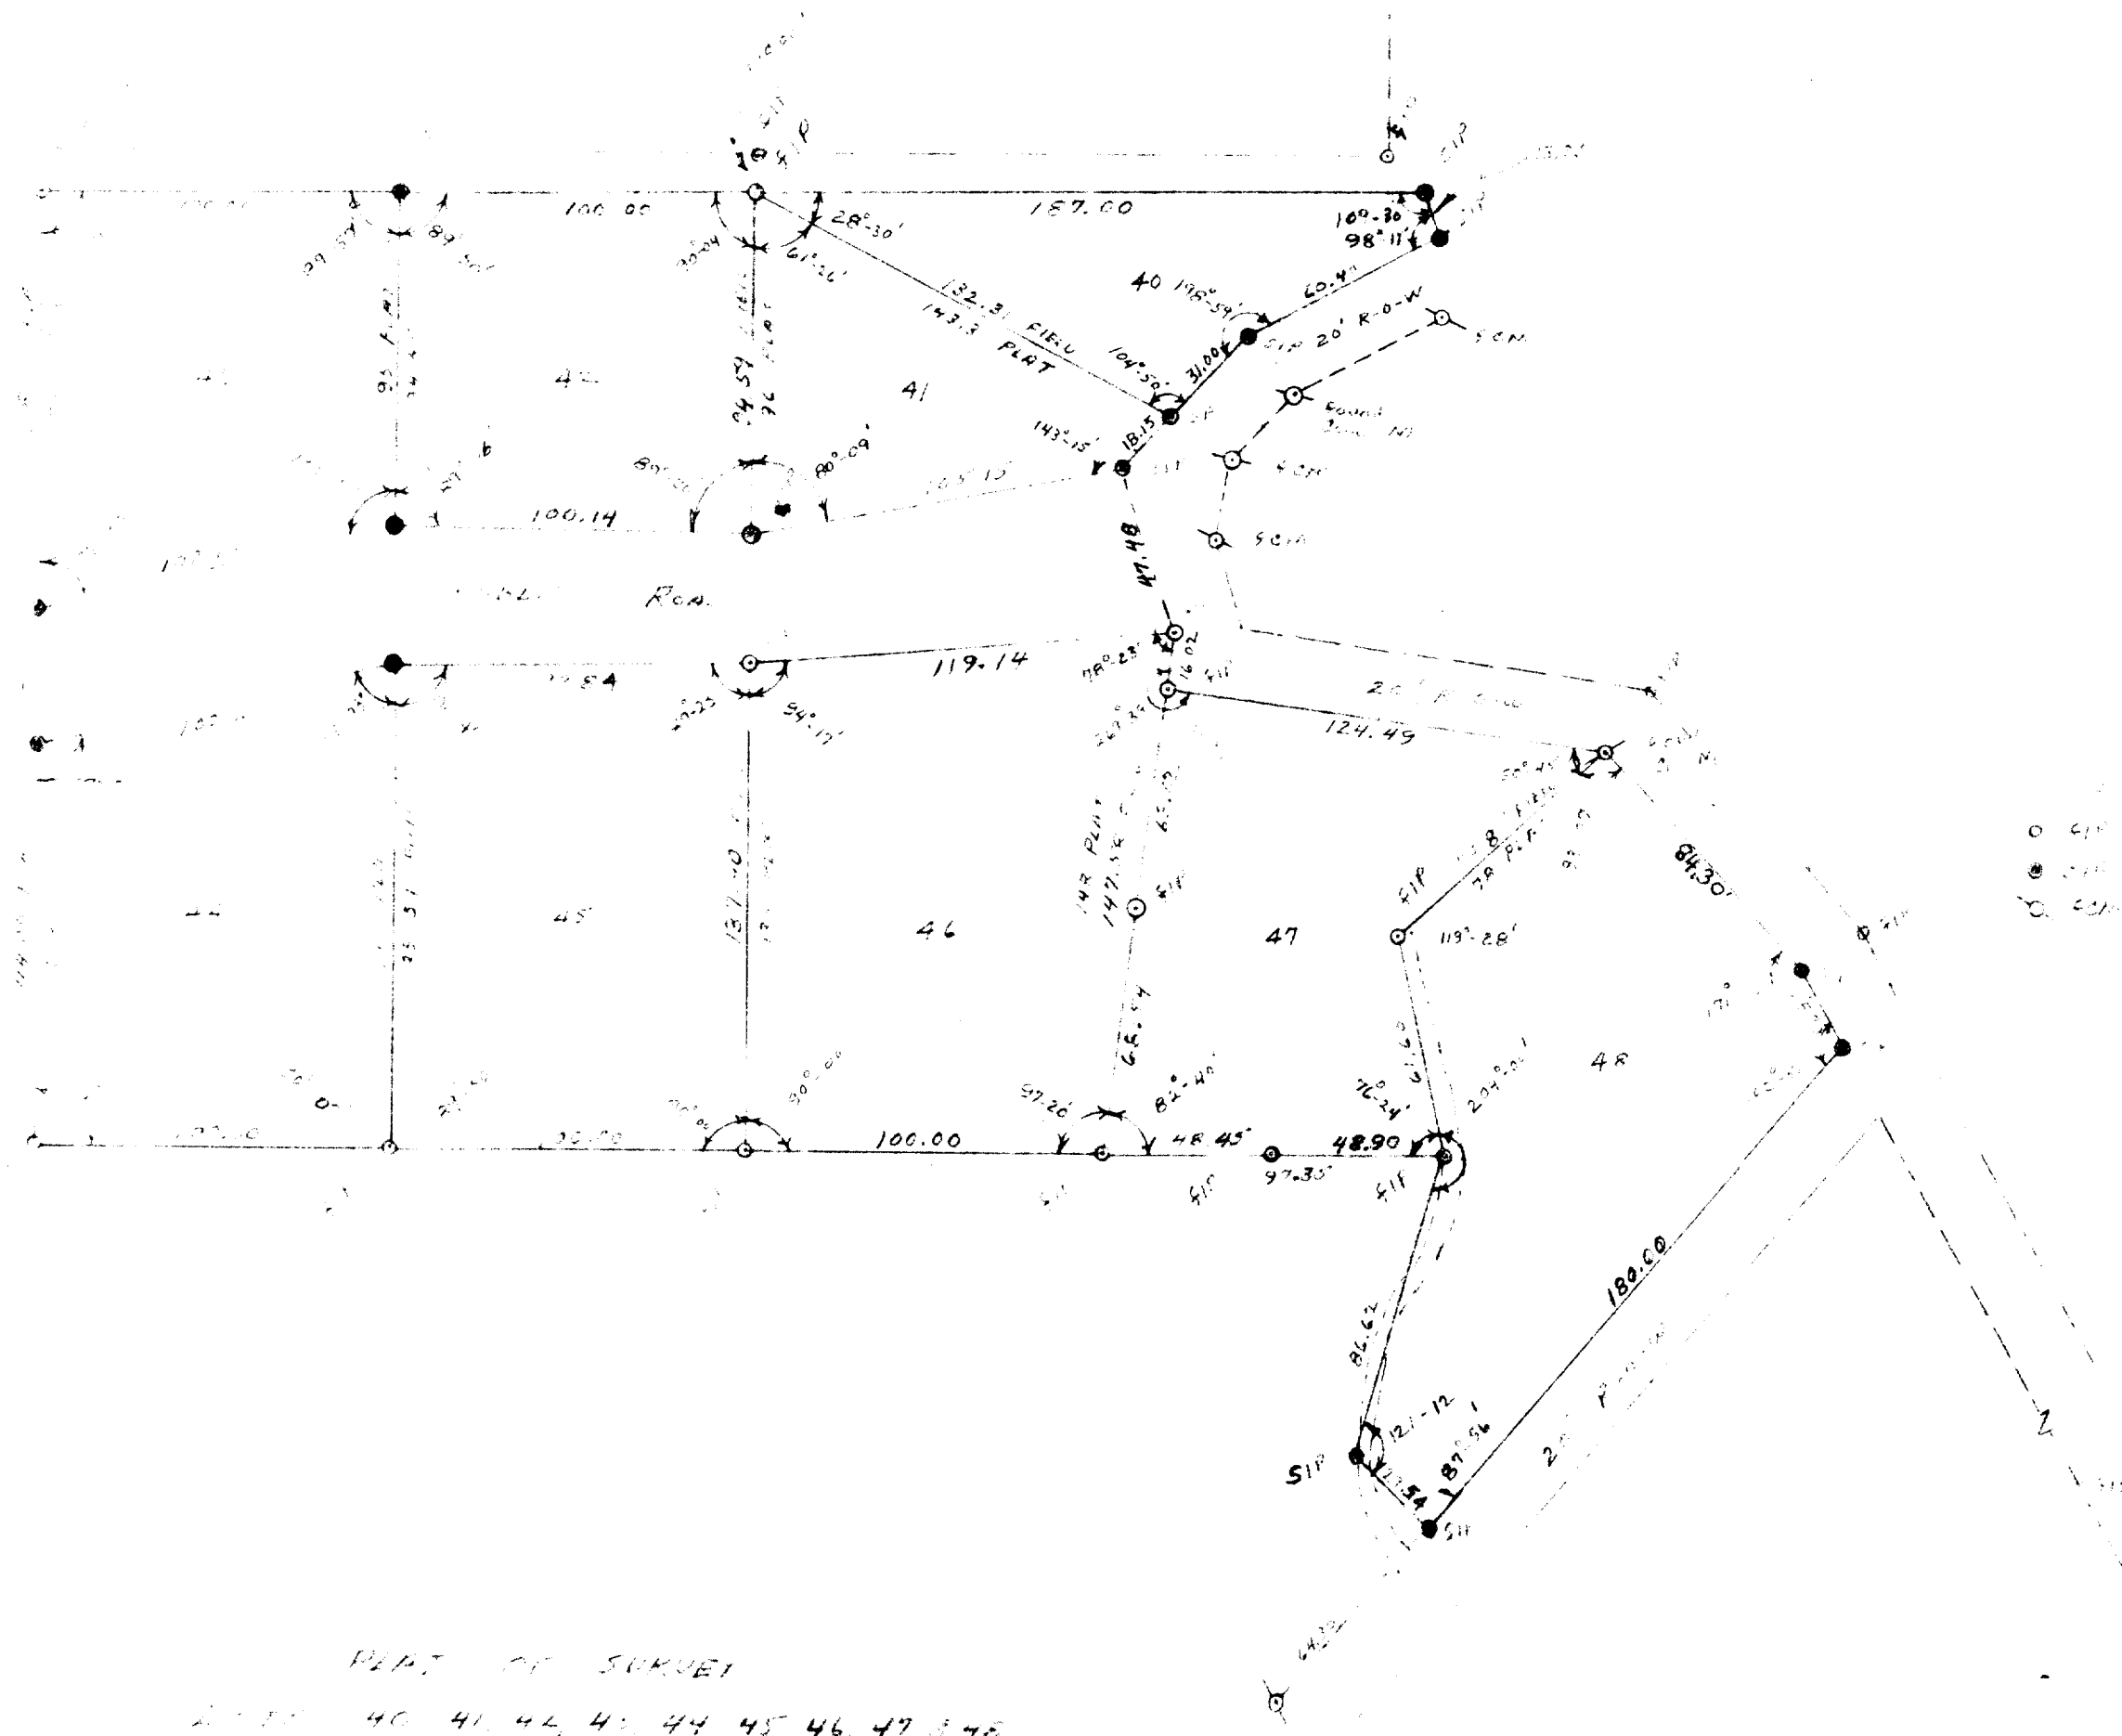

N.P.R. 1/4 50'
 O CIP FOUND 2nd P.M.
 ● CIP 1st IRON PINE
 ○ CCM FOUND CORNER = MAIN

PLAT OF SURVEY
 LOTS 40, 41, 44, 45, 46, 47, 48
 THE GABLES SUBDIVISION
 VILLAGE OF MONTANA-ON GENEVA LAKE
 WISCONSIN

