
## ABELL SURVEYING & MAPPING DELAYAN, WISCONSIN 53115 414-728-6737

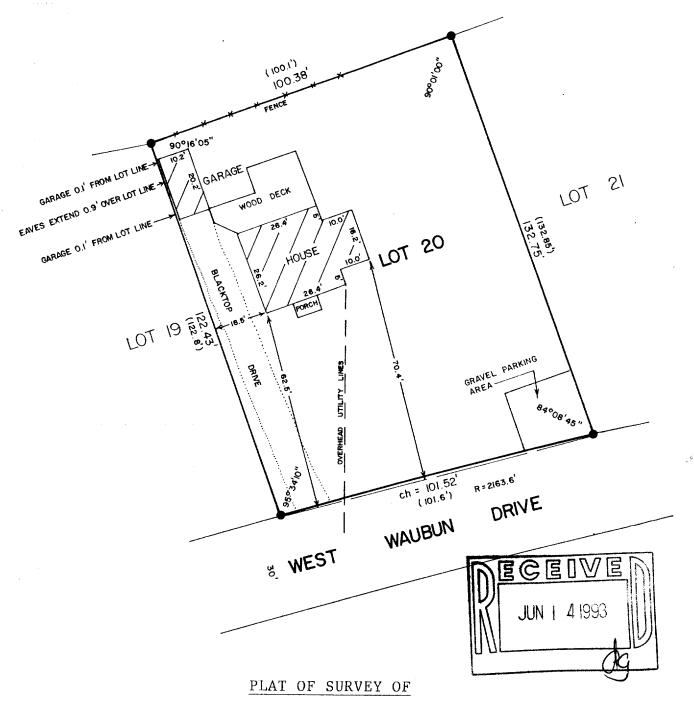

LOT 20 OF COUNTRY CLUB ESTATES UNIT 2, VILLAGE OF FONTANA-ON-GENEVA LAKE, WALWORTH COUNTY, WISCONSIN.

ORDERED BY:

PERL GROUP REAL

**ESTATE** 

P.O. BOX 1183 McHENRY, IL 60050

SCALE - 1"=30"

LEGEND

 CONCRETE MONUMENT FOUND

( )- RECORDED AS

I HERERY CERTIFY THAT I HAVE SURVEYED THE ABOVE DESCRIBED PROPERTY AND THAT THE ABOVE MAP IS A TRUE REPRESENTATION THEREOF AND SHOWS THE SIZE AND LOCATION OF THE PROPERTY, ITS EXTERIOR BOUNDARIES, THE LOCATION OF ALL VISIBLE STRUCTURES AND DIMENSIONS OF ALL PRINCIPAL BUILDINGS THEREON, BOUNDARY FENCES, APPARENT EASEMENTS, ROADWAYS AND VISIBLE ENCROACHMENTS, IF ANY, TO THE BEST OF MY KNOWLEDGE AND BELIEF.

THIS SURVEY IS MADE FOR THE USE OF THE PRESENT OWNERS OF THE PROPERTY, AND ALSO THOSE WHO PURCHASE, MORTGAGE, OR GUARANTEE THE TITLE THERETO WITHIN ONE (1) YEAR FROM DATE HEREOF.

David 7. abell

DAVID F. ABELL WISCONSIN REGISTERED LAND SURVEYOR, S-1596

DATE NOTE: THIS IS NOT A CERTIFIED COPY UNLESS SEALED.

REVISED - 4/16/93

5002-17