

BRICKLEY SUB

STATE OF WISCONSIN
COUNTY OF WALWORTH


I, LLOYD L. JENSEN, DO HEREBY CERTIFY THAT I HAVE
SURVEYED THE PROPERTY SHOWN HEREON ACCORDING
TO THE OFFICIAL RECORDS, AND THAT THE PLAT HEREON
IS A CORRECT REPRESENTATION OF THE LOT LINES AND
PRINCIPAL LINES OF BUILDINGS THEREON.

APRIL 2, 1956

Lloyd L. Jensen
SURVEYOR

CL # 93

- - IRON PIPE
● - CONCRETE MONUMENT

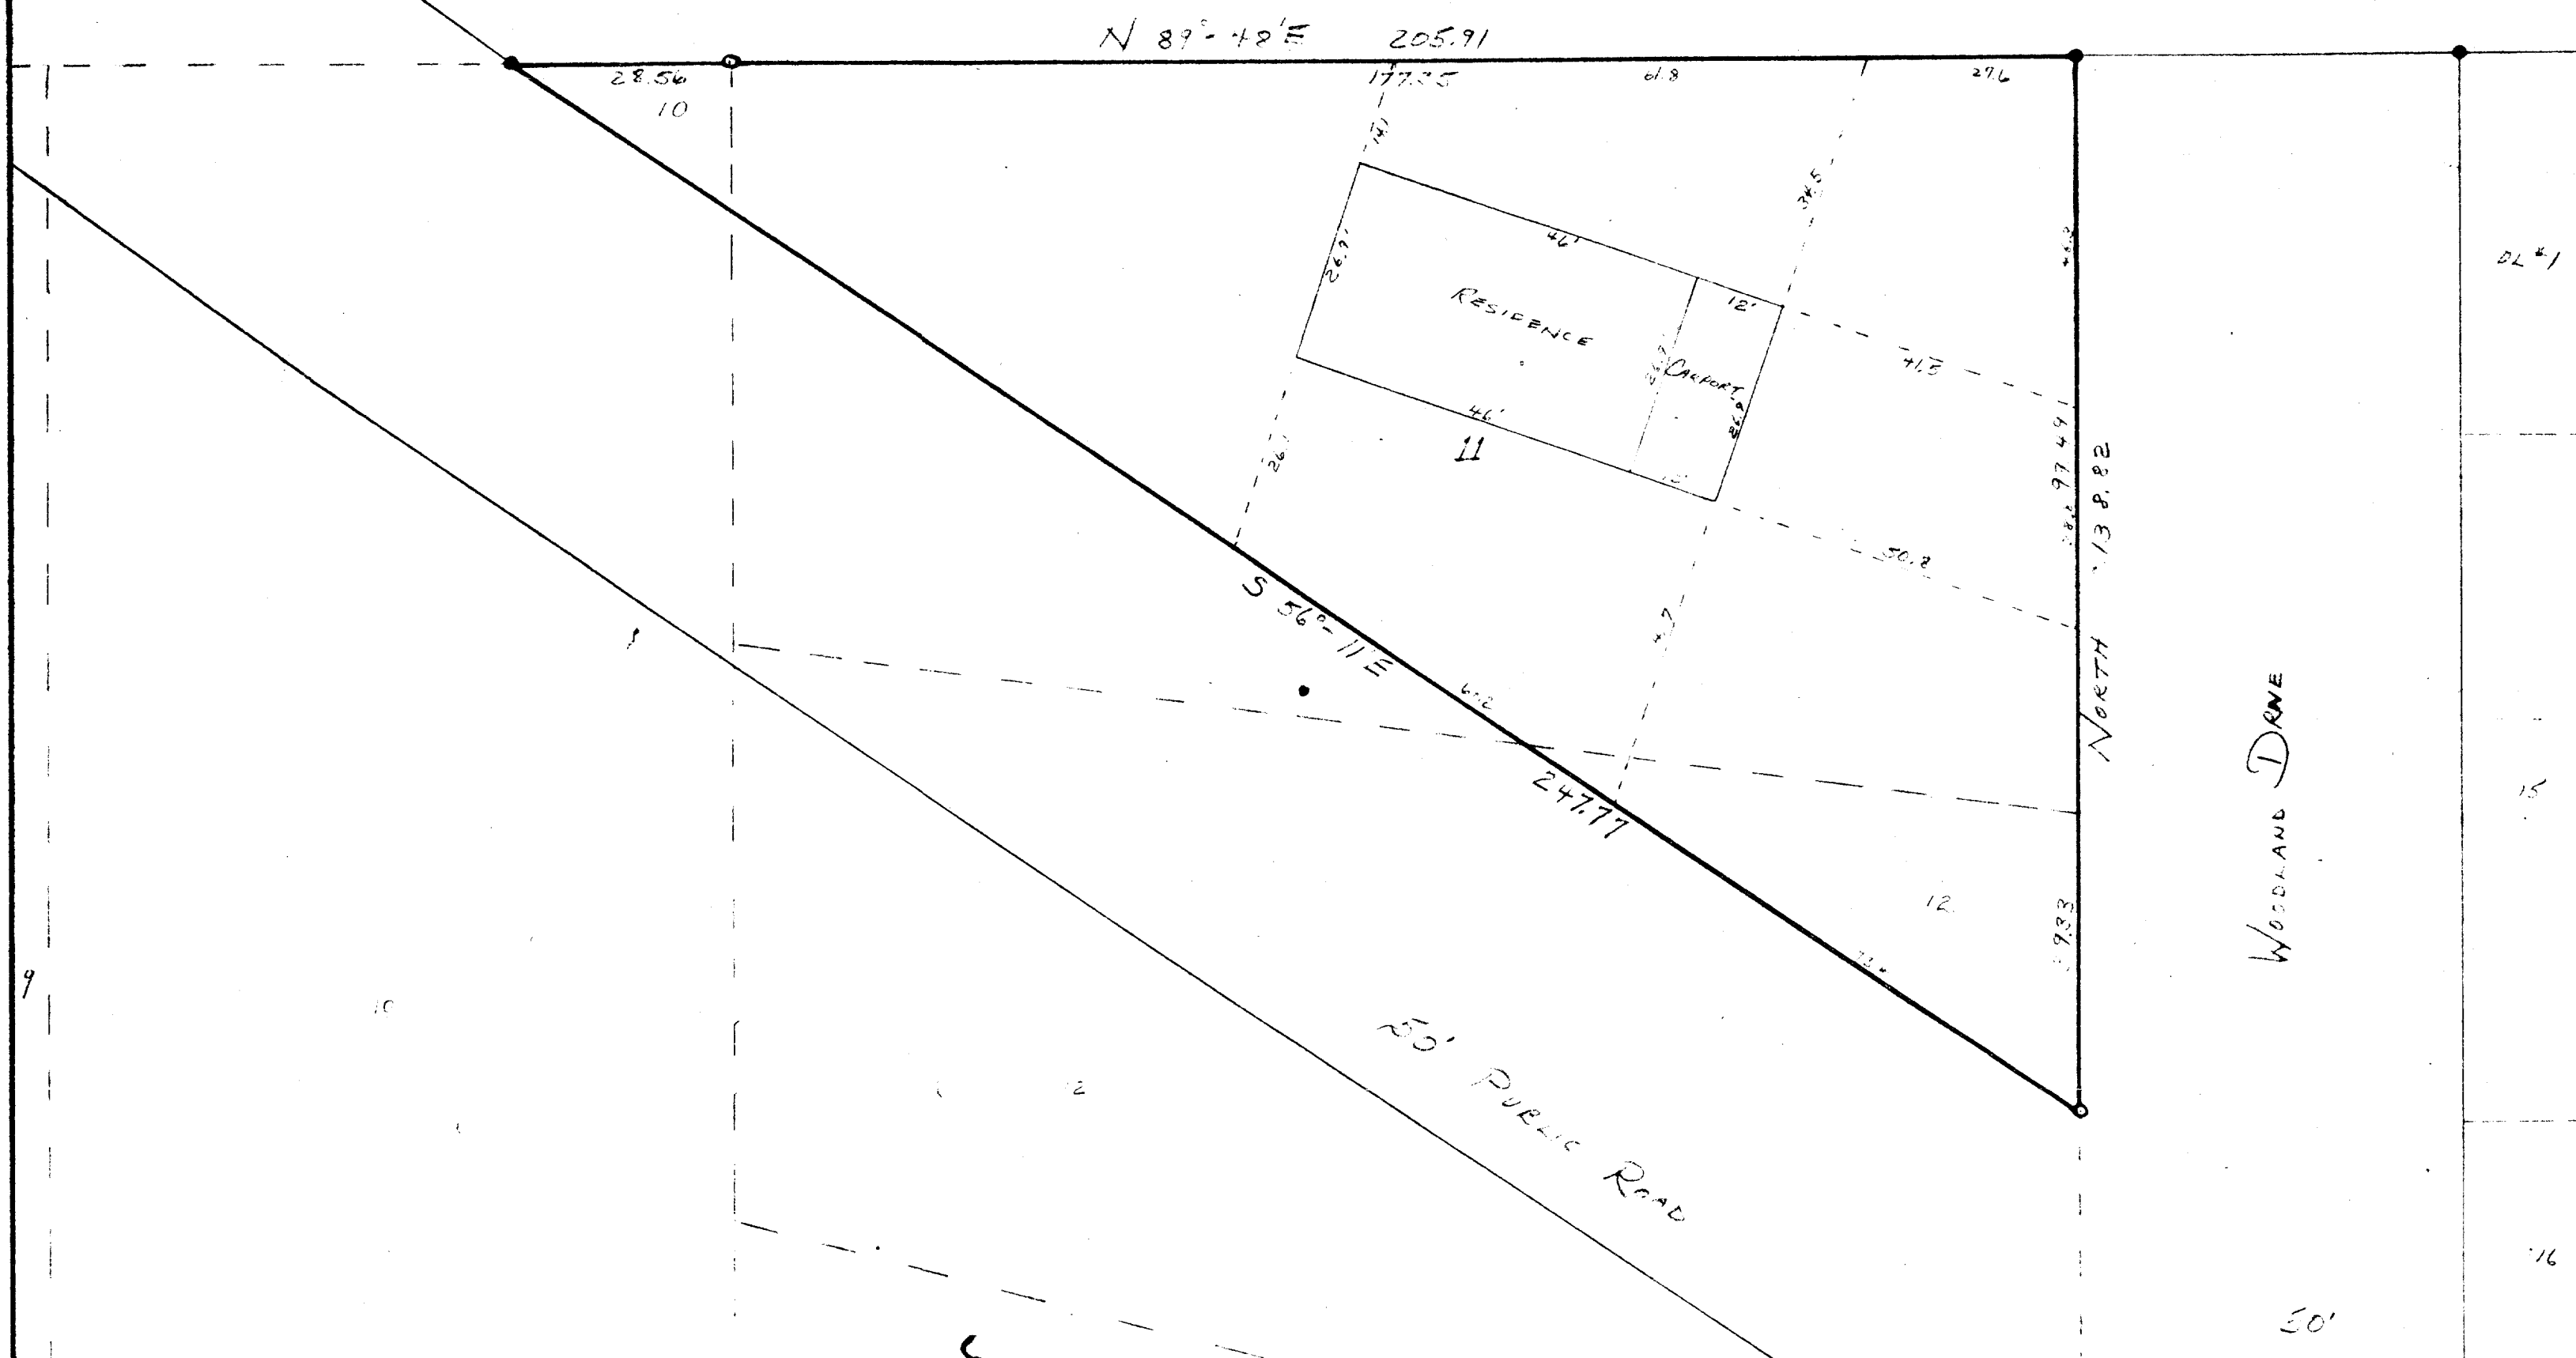

PLAT OF SURVEY
OF

PART OF LOTS 10, 11, & 12
OF ADDITION "D" TO COUNTRY CLUB ESTATES
LOCATED IN THE
VILLAGE OF FONTANAUON-GENEVA LAKE,
WALWORTH COUNTY, WISCONSIN

Lloyd L. Jensen
SURVEYOR

SCALE 1" = 20'

DATE APRIL 2, 1956

SCTD-12