

ROBERS & FISCHER, INC.
CONSULTING ENGINEERS & LAND SURVEYORS


PHONE (414) 763-2652

116 E. CHESTNUT ST.

BURLINGTON, WIS. 53105

Plat of Survey

Part of Lot 1, Unit 1, Country Club Estates Subdivision Fontana-on-Geneva Lake, Walworth County, Wisconsin.

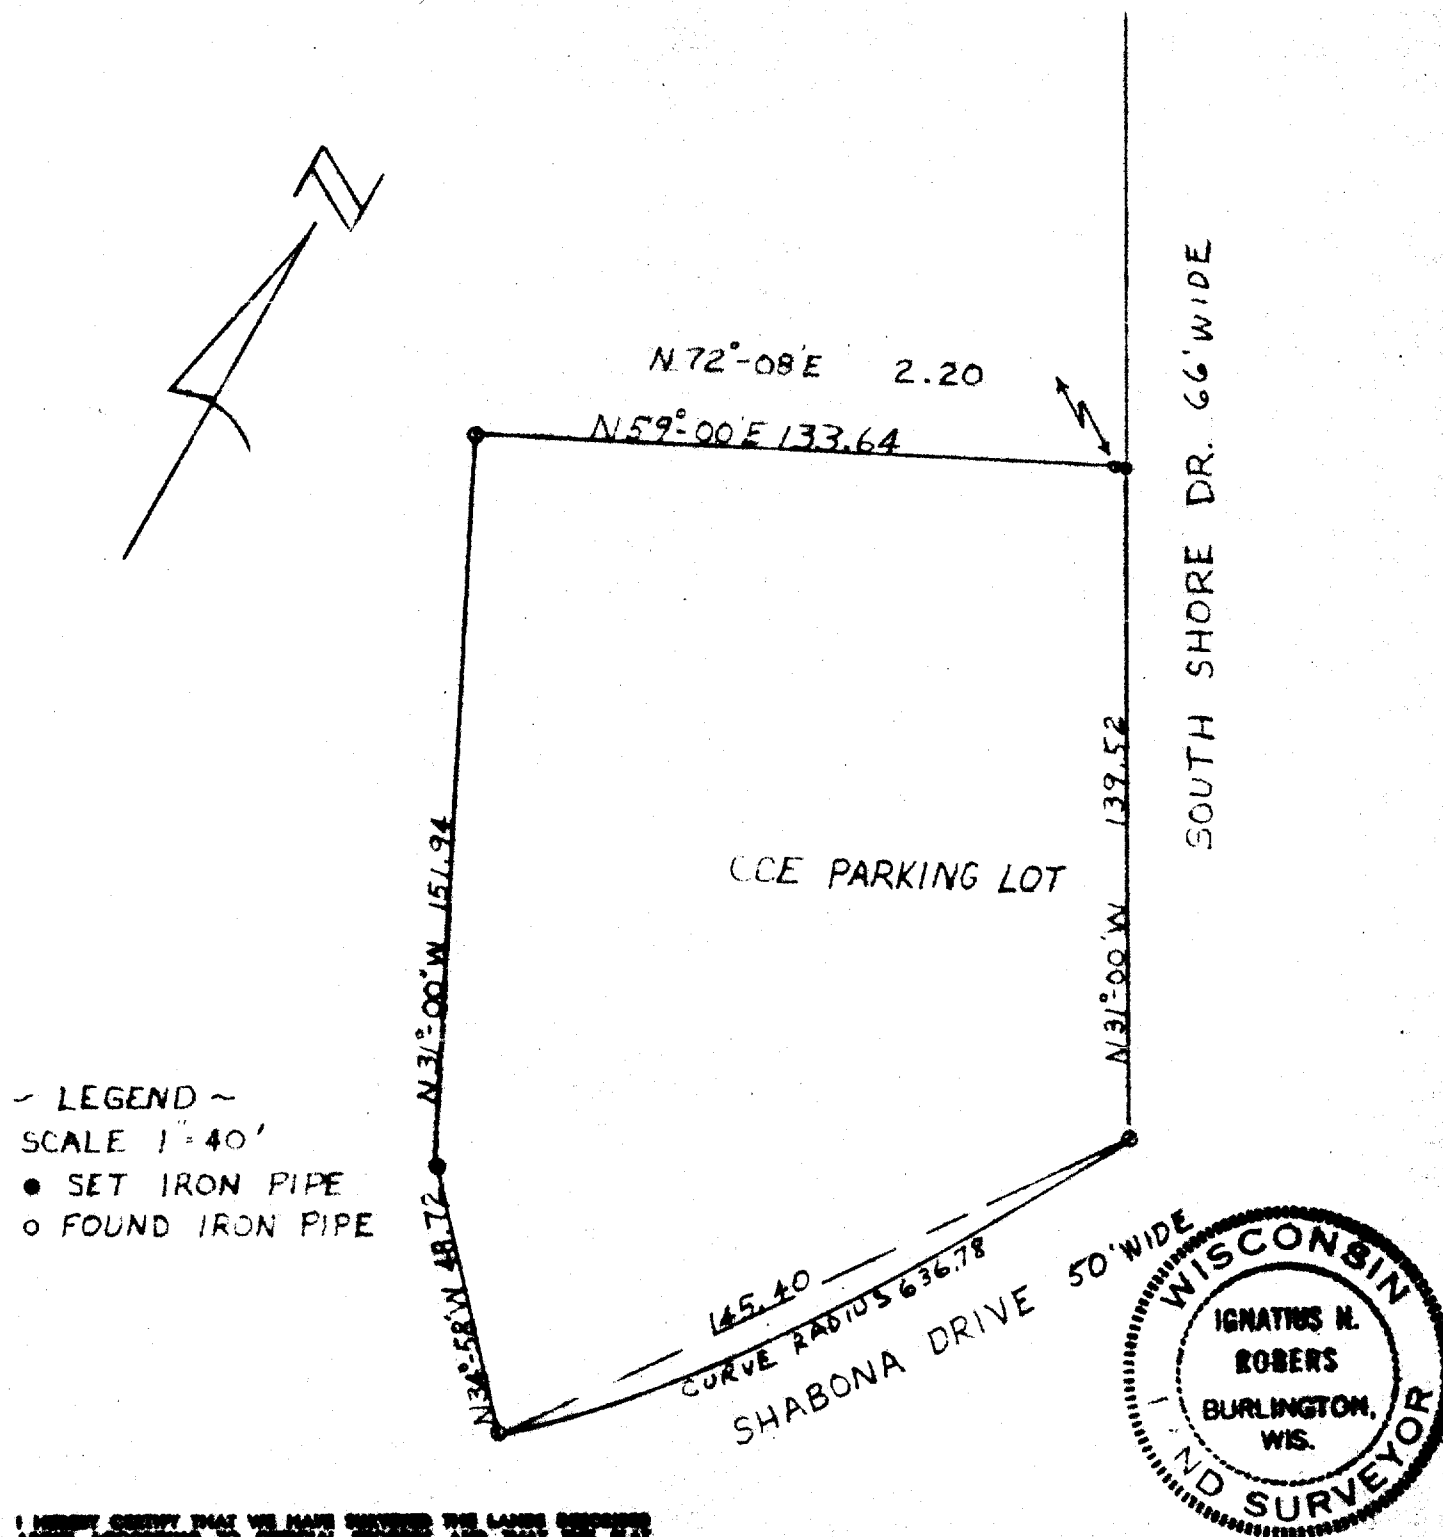

~ LEGEND ~

SCALE 1"=40'

● SET IRON PIPE

○ FOUND IRON PIPE

I HEREBY CERTIFY THAT WE HAVE SURVEYED THE LAND DESCRIBED ABOVE ACCORDING TO GENERAL SURVEYING AND THAT THE PLAT DRAWN HEREON IS A CORRECT REPRESENTATION OF THE SURVEY.

Ignatius H. Rober
 SURVEYOR
 500787

DATE 3-1-71

5-137

JOB NO. 70156