


BROOK STREET

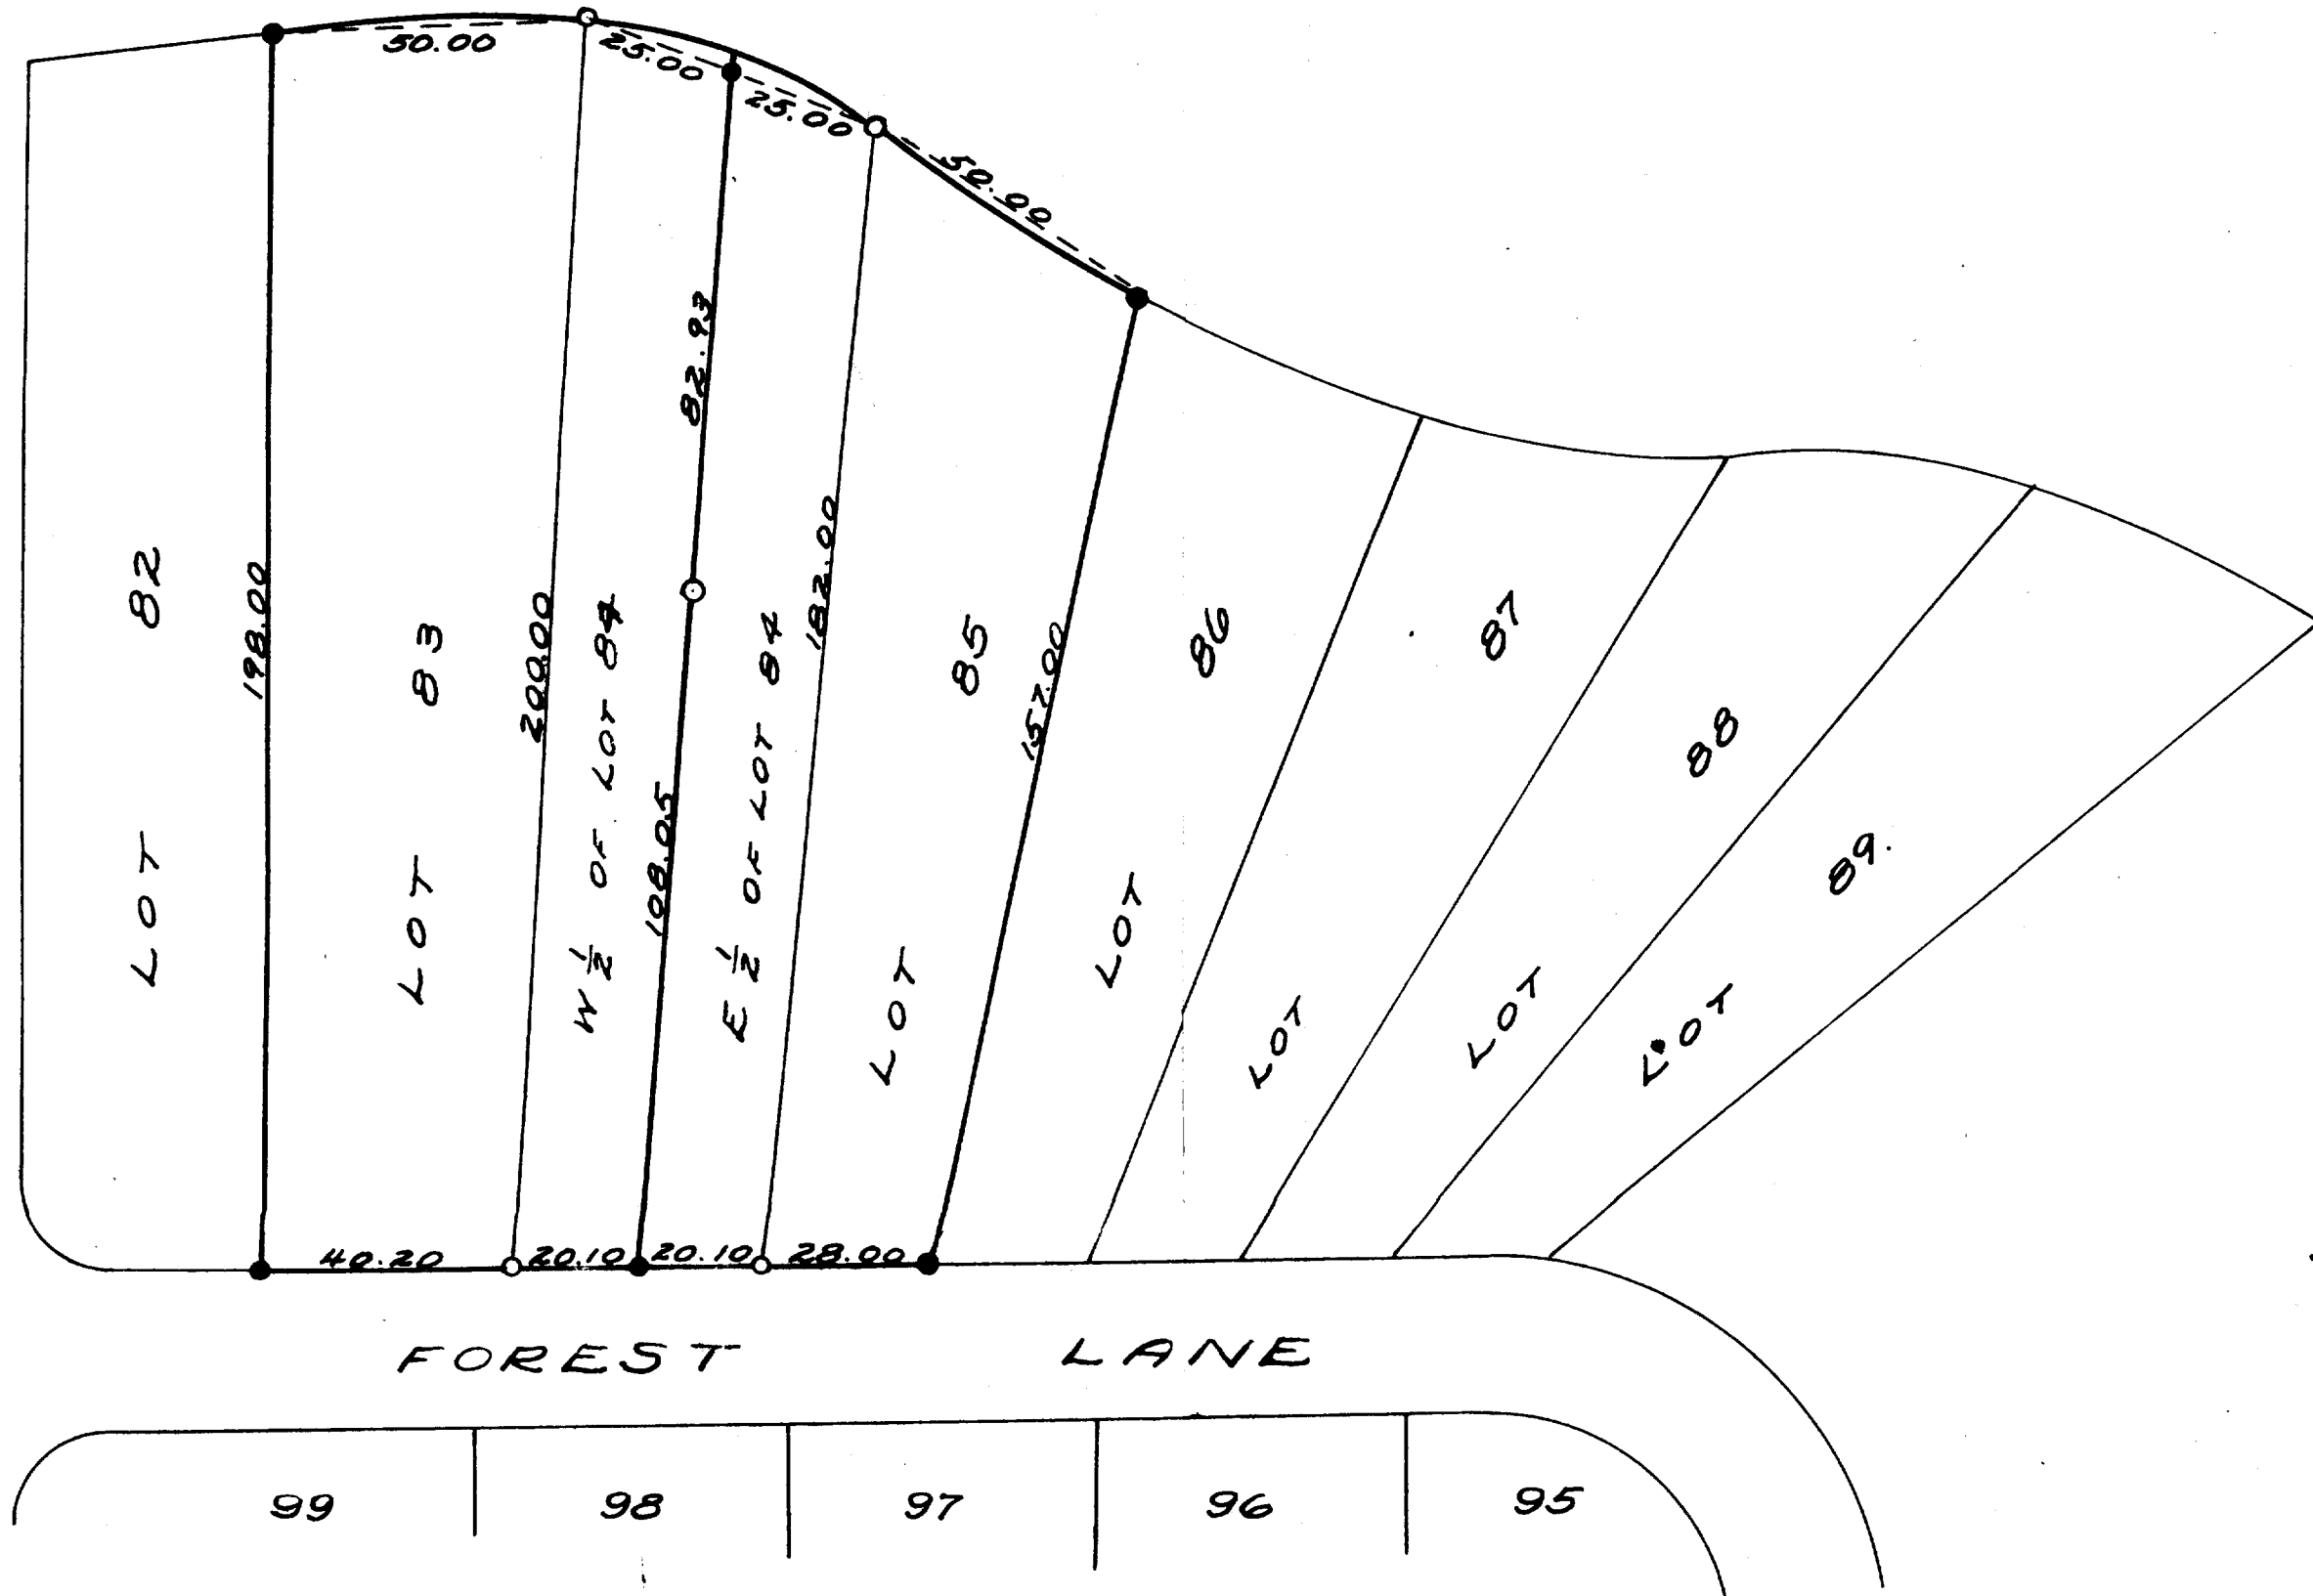

SCALE - 1" = 30'  
O = IRON PIPE  
● = CONC. MON.

PLAT OF SURVEY OF LOTS 83, 84 & 85 OF BUENA VISTA  
SUBD. IN THE VILLAGE OF FONTANA-ON-GENEVA LAKE,  
WALWORTH COUNTY, WISCONSIN.  
MAY 14, 1946

H. E. JOHNSON  
SURVEYOR

5-34 J

SBV-61.62

