


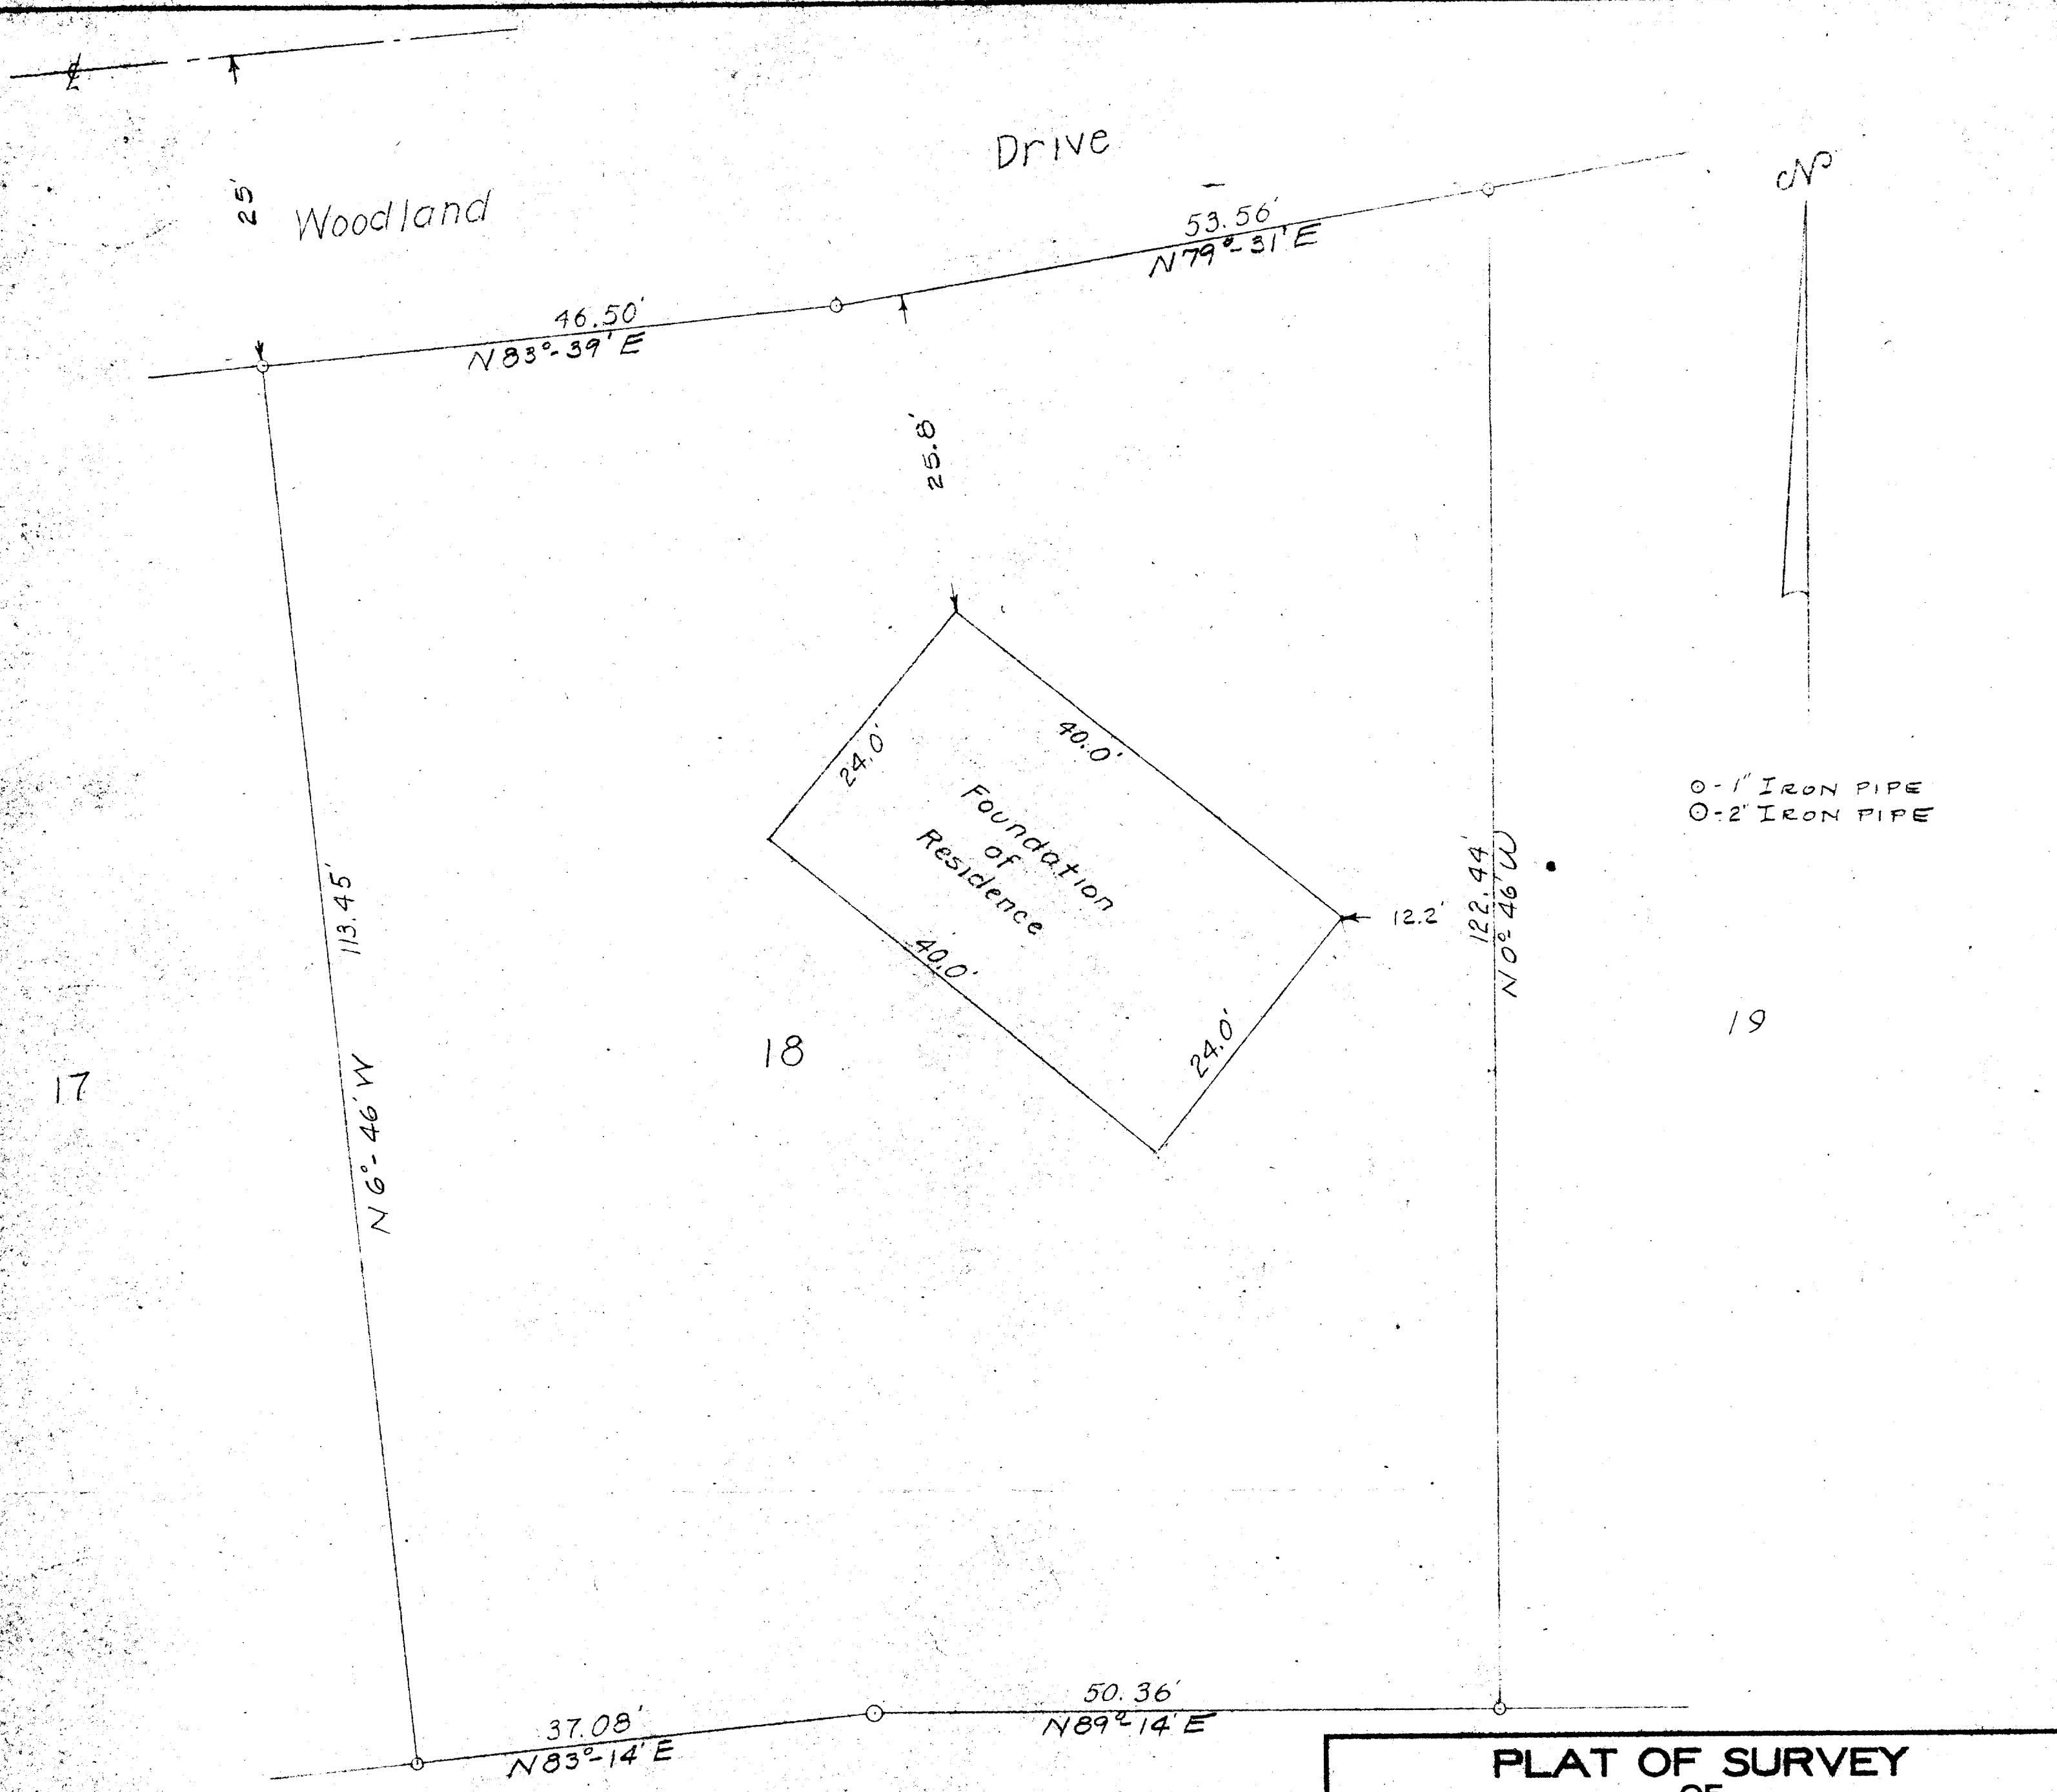

STATE OF WISCONSIN)
COUNTY OF WALWORTH)
I, LLOYD L. JENSEN, DO HEREBY CERTIFY THAT I HAVE SURVEYED
THE PROPERTY HEREON DESCRIBED ACCORDING TO THE OFFICIAL
RECORDS, AND THAT THE PLAT HEREON IS A CORRECT REPRESENTATION
OF THE LOT LINES AND PRINCIPAL LINES OF BUILDINGS
THEREON,
MAY 1957

Lloyd L. Jensen
SURVEYOR

PLAT OF SURVEY OF

Lot 18, Addition "E" to Country Club
Estates, Village of Fontana-on-
Geneva Lake, Walworth County
Wisconsin

Lloyd L. Jensen
SURVEYOR

SCALE 1" = 10'

DATE May, 1957