


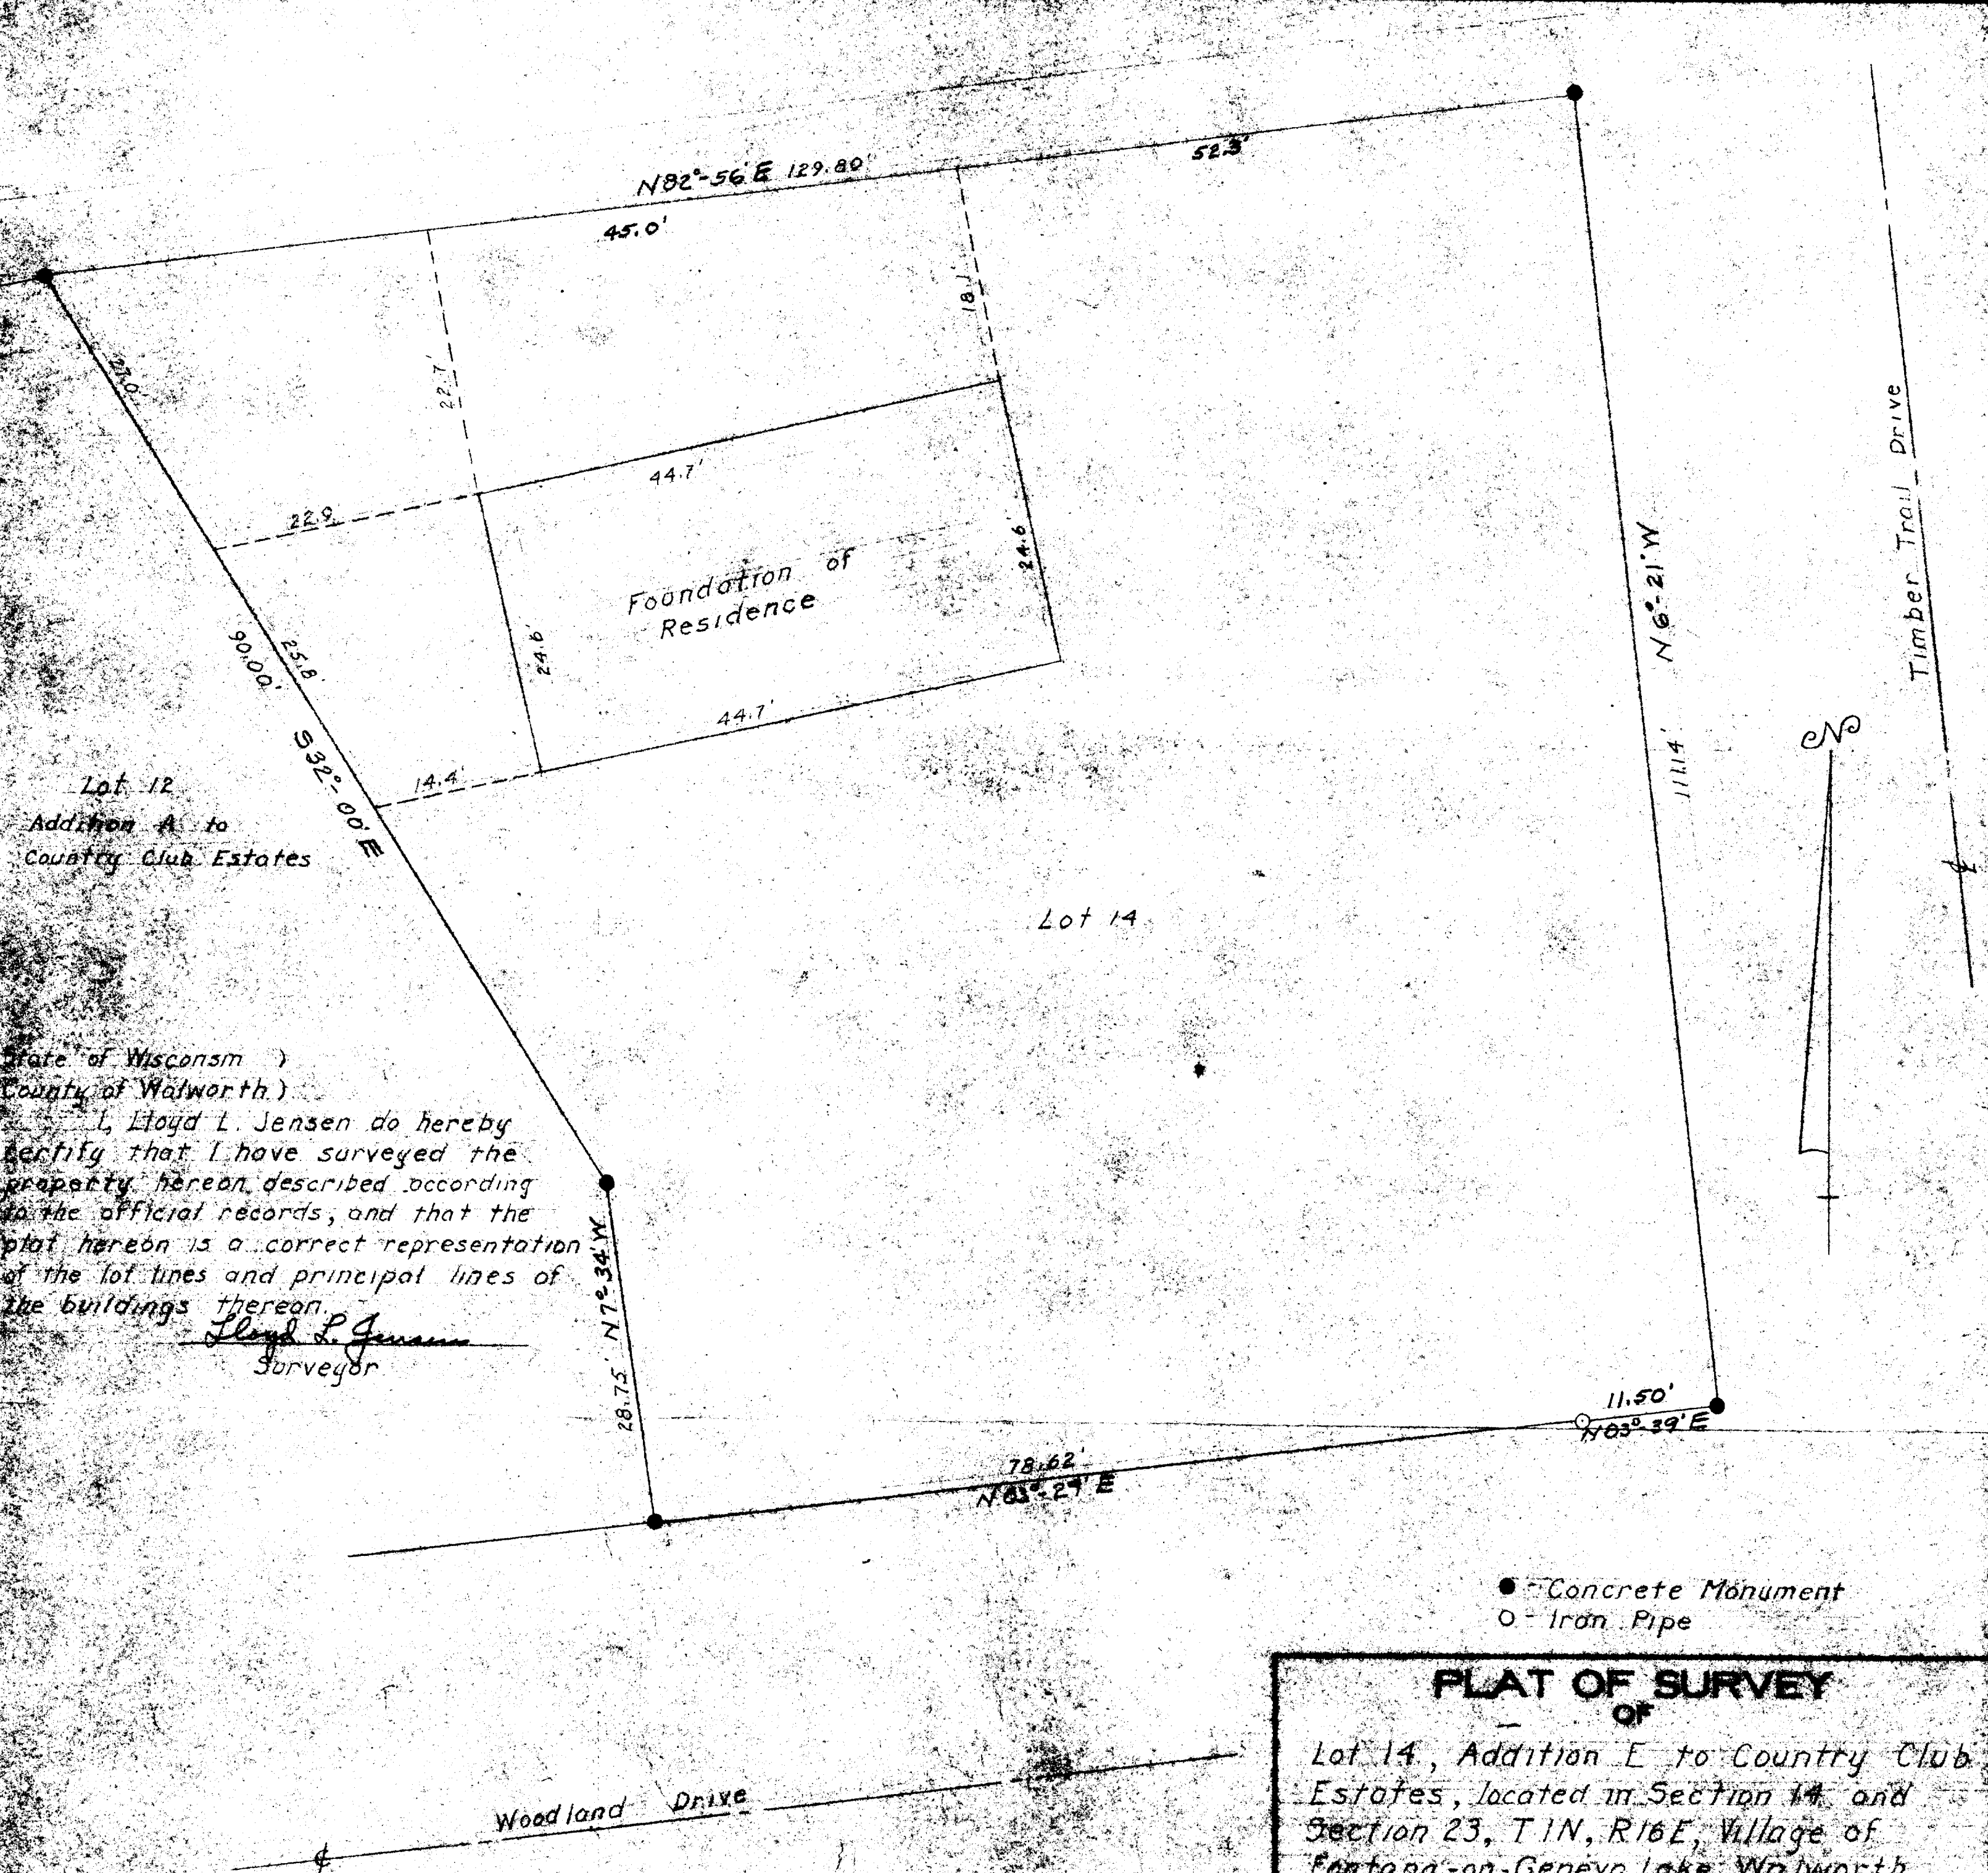

Lot 12
Addition A to
Country Club Estates

State of Wisconsin)
County of Walworth.)
I, Lloyd L. Jensen do hereby
certify that I have surveyed the
property hereon described according
to the official records, and that the
plat hereon is a correct representation
of the lot lines and principal lines of
the buildings thereon.
Lloyd L. Jensen
Surveyor

● - Concrete Monument
○ - Iron Pipe

PLAT OF SURVEY
OF
Lot 14, Addition E to Country Club
Estates, located in Section 14 and
Section 23, T1N, R16E, Village of
Fontana-on-Geneva Lake, Walworth
County, Wisconsin.
Lloyd L. Jensen
Surveyor

SCALE 1" = 10'
DATE NOV. 1957