

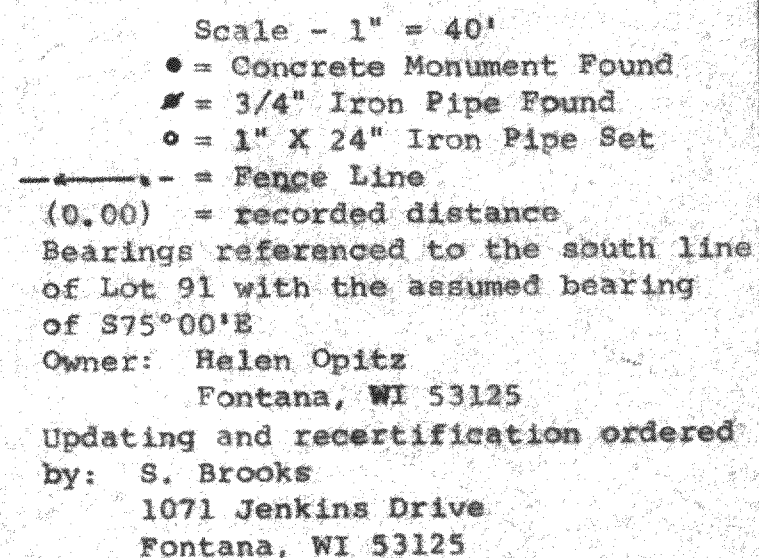


**SURVEYING & SUBDIVIDING
DELAN, WISCONSIN 53115**

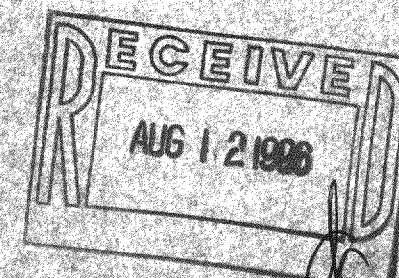

George T. Dunham
George T. Dunham, Surveyor

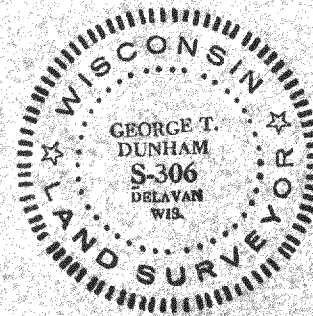

SC02-78
dps-1540