


BURLINGTON, WIS. 53105

LOT 18, BLOCK "E", COUNTRY CLUB ESTATES
SUB. UNIT 3, VILLAGE OF FONTANA,
WALWORTH COUNTY, WISCONSIN.

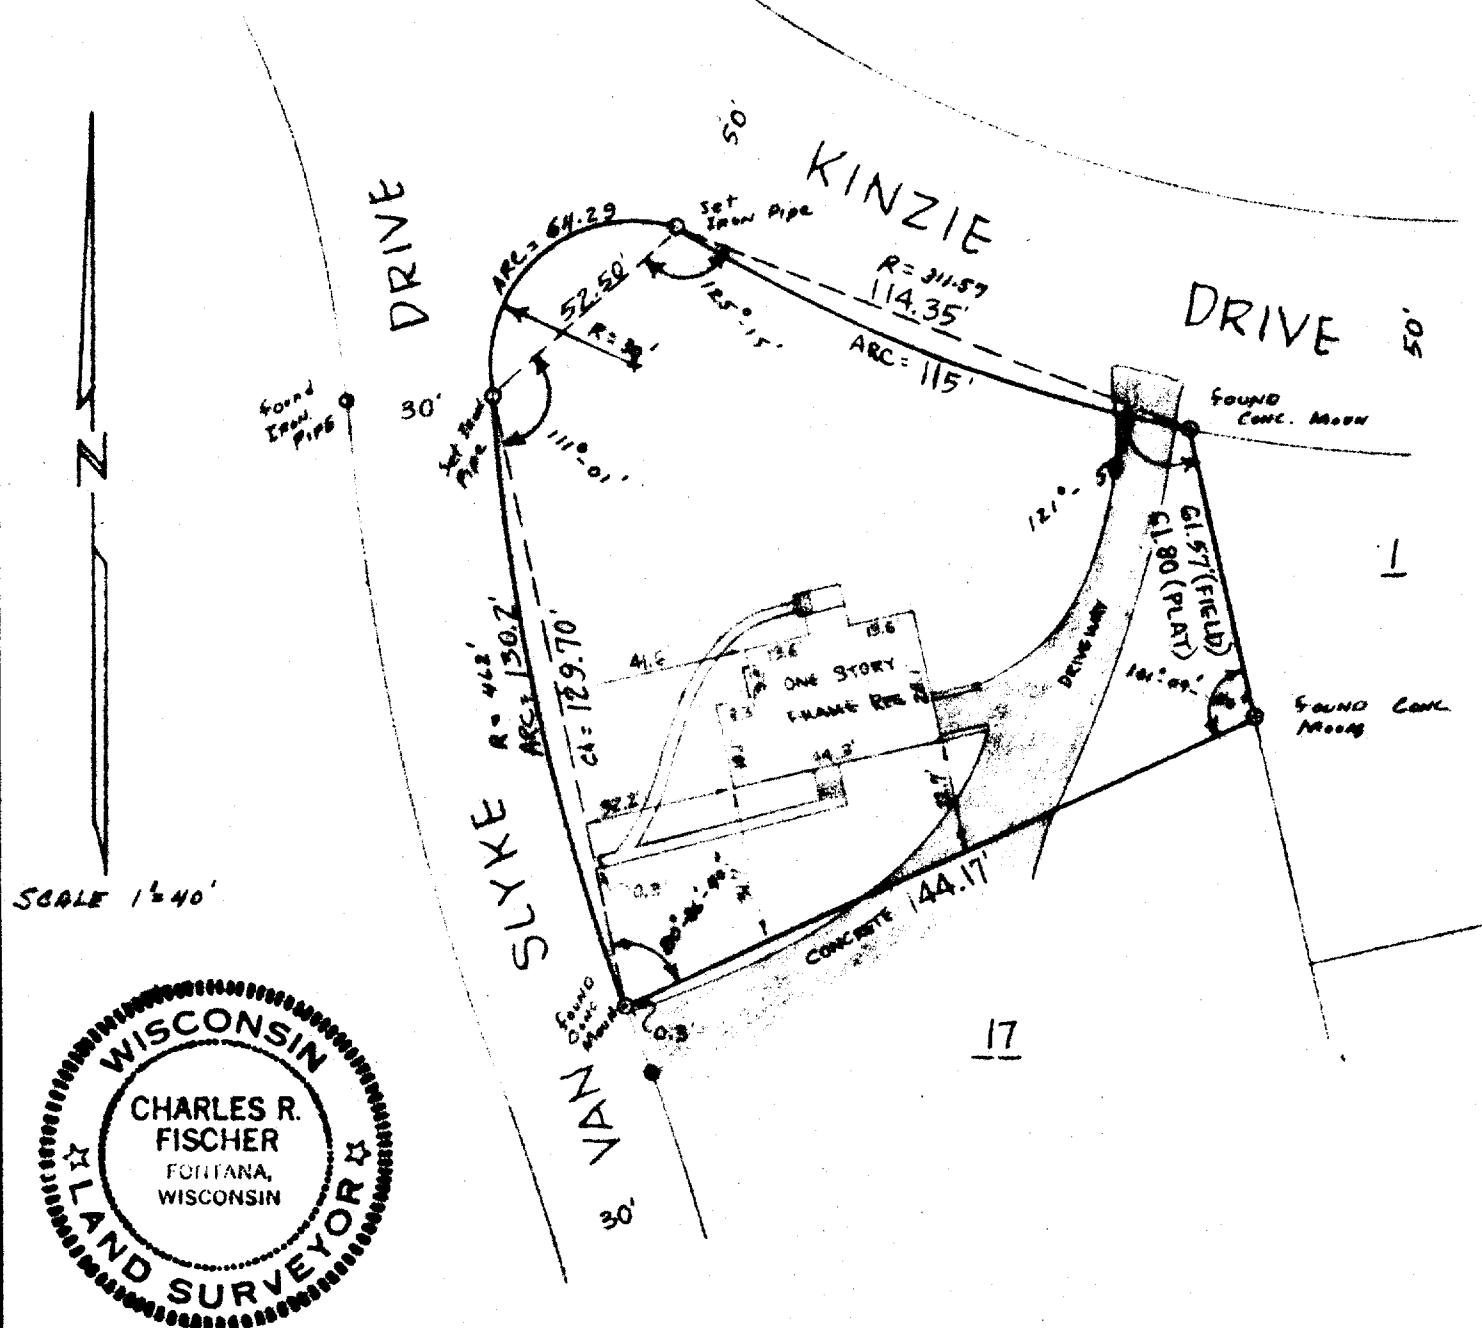

I HEREBY CERTIFY THAT WE HAVE SURVEYED THE LANDS DESCRIBED ABOVE ACCORDING TO OFFICIAL RECORDS AND THAT THE PLAT DRAWN HEREON IS A CORRECT REPRESENTATION OF SAID SURVEY.

WIS. REG. LAND SURVEYOR

DATE July 13, 1970 5-151A JOB NO. 70093

JOB NO. 70093

5C03-9.5