

CONSULTING ENGINEERS & LAND SURVEYORS


PHONE (414) 763-2652

116 E. CHESTNUT ST.

BURLINGTON, WIS. 53105

Plat of Survey of

lots 1, 2, and 3, block 10 Glenwood Springs Subdivision, Village
of Geneva Lake further described as follows to wit: Beginning
at the South line of lot 3, 21.00 feet $S 87^{\circ}-43'E$ of the South-
west corner; thence $S 30^{\circ}-08'E$ 105.74 feet to an iron pipe on the South
line of Myrtle Avenue; thence $S 56^{\circ}-33'E$ 23.00 feet to an iron pipe;
thence $S 43^{\circ}-15'E$ 54.56 feet to an iron pipe; thence $S 32^{\circ}-06'E$ 44.80
feet to an iron pipe; thence $N 8^{\circ}-43'W$ 134.47 feet to the point of
beginning.

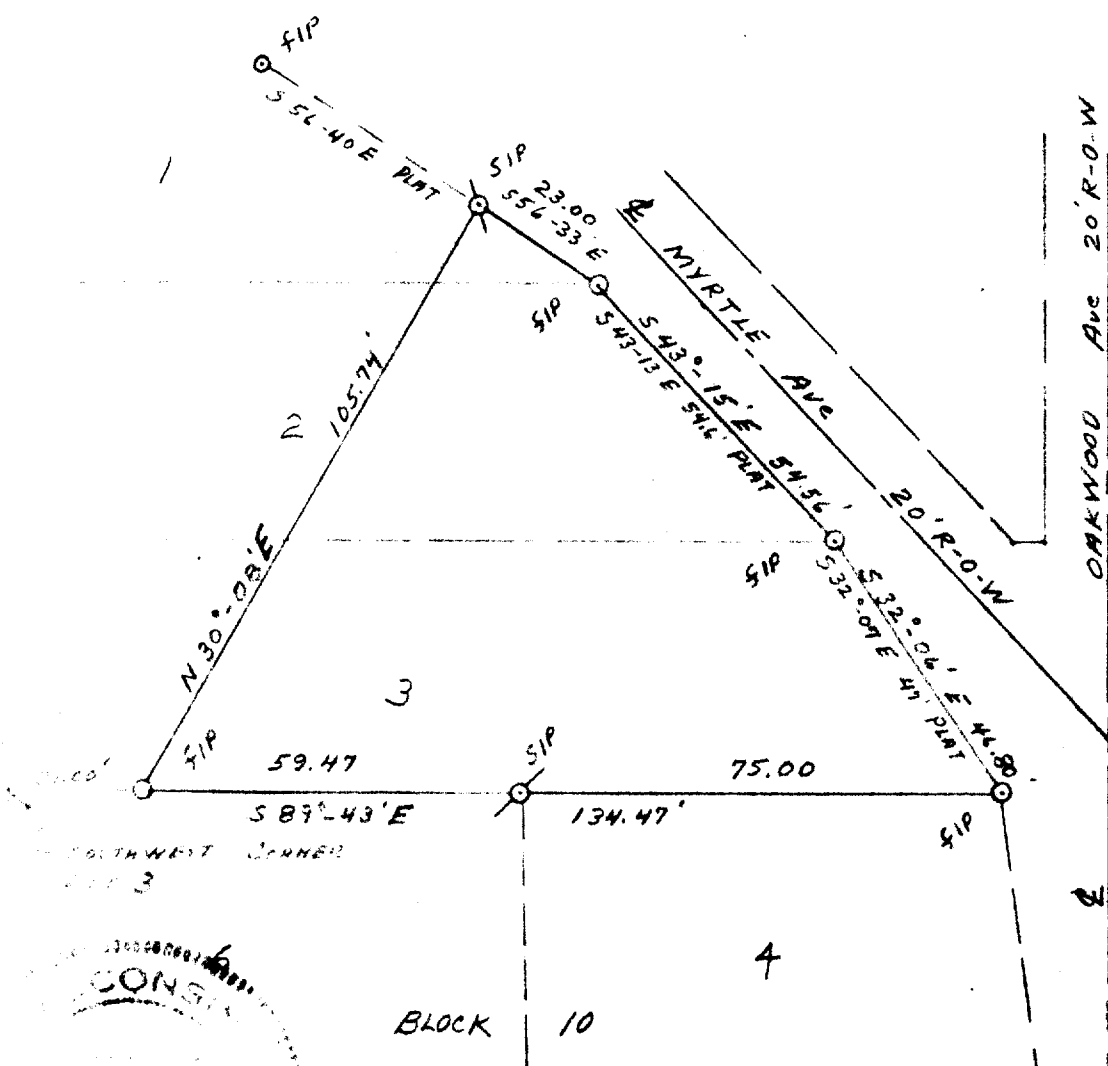

SCALE 1" = 30'

FIP Found IRON PIPE

SIP Set IRON PIPE

I HEREBY CERTIFY THAT I HAVE SURVEYED THE LANDS DESCRIBED
ABOVE ACCORDING TO OFFICIAL RECORDS AND THAT THE PLAT
DRAWN HEREON IS A CORRECT REPRESENTATION OF SAID SURVEY.

WISCONSIN REGISTERED LAND SURVEYOR

DATE June 19, 1970

5-153

JOB NO. 70039

305-37