

ROBERTS & FISCHER
CONSULTING ENGINEERS & LAND SURVEYORS



PHONE (414) 763-2652

116 E. CHESTNUT ST.

BURLINGTON, WIS. 53108

Plat of Survey

Lots 23 & 24 County Club Estates Addition "D", Village of Fontana
 on Geneva Lake, Walworth County, Wisconsin.

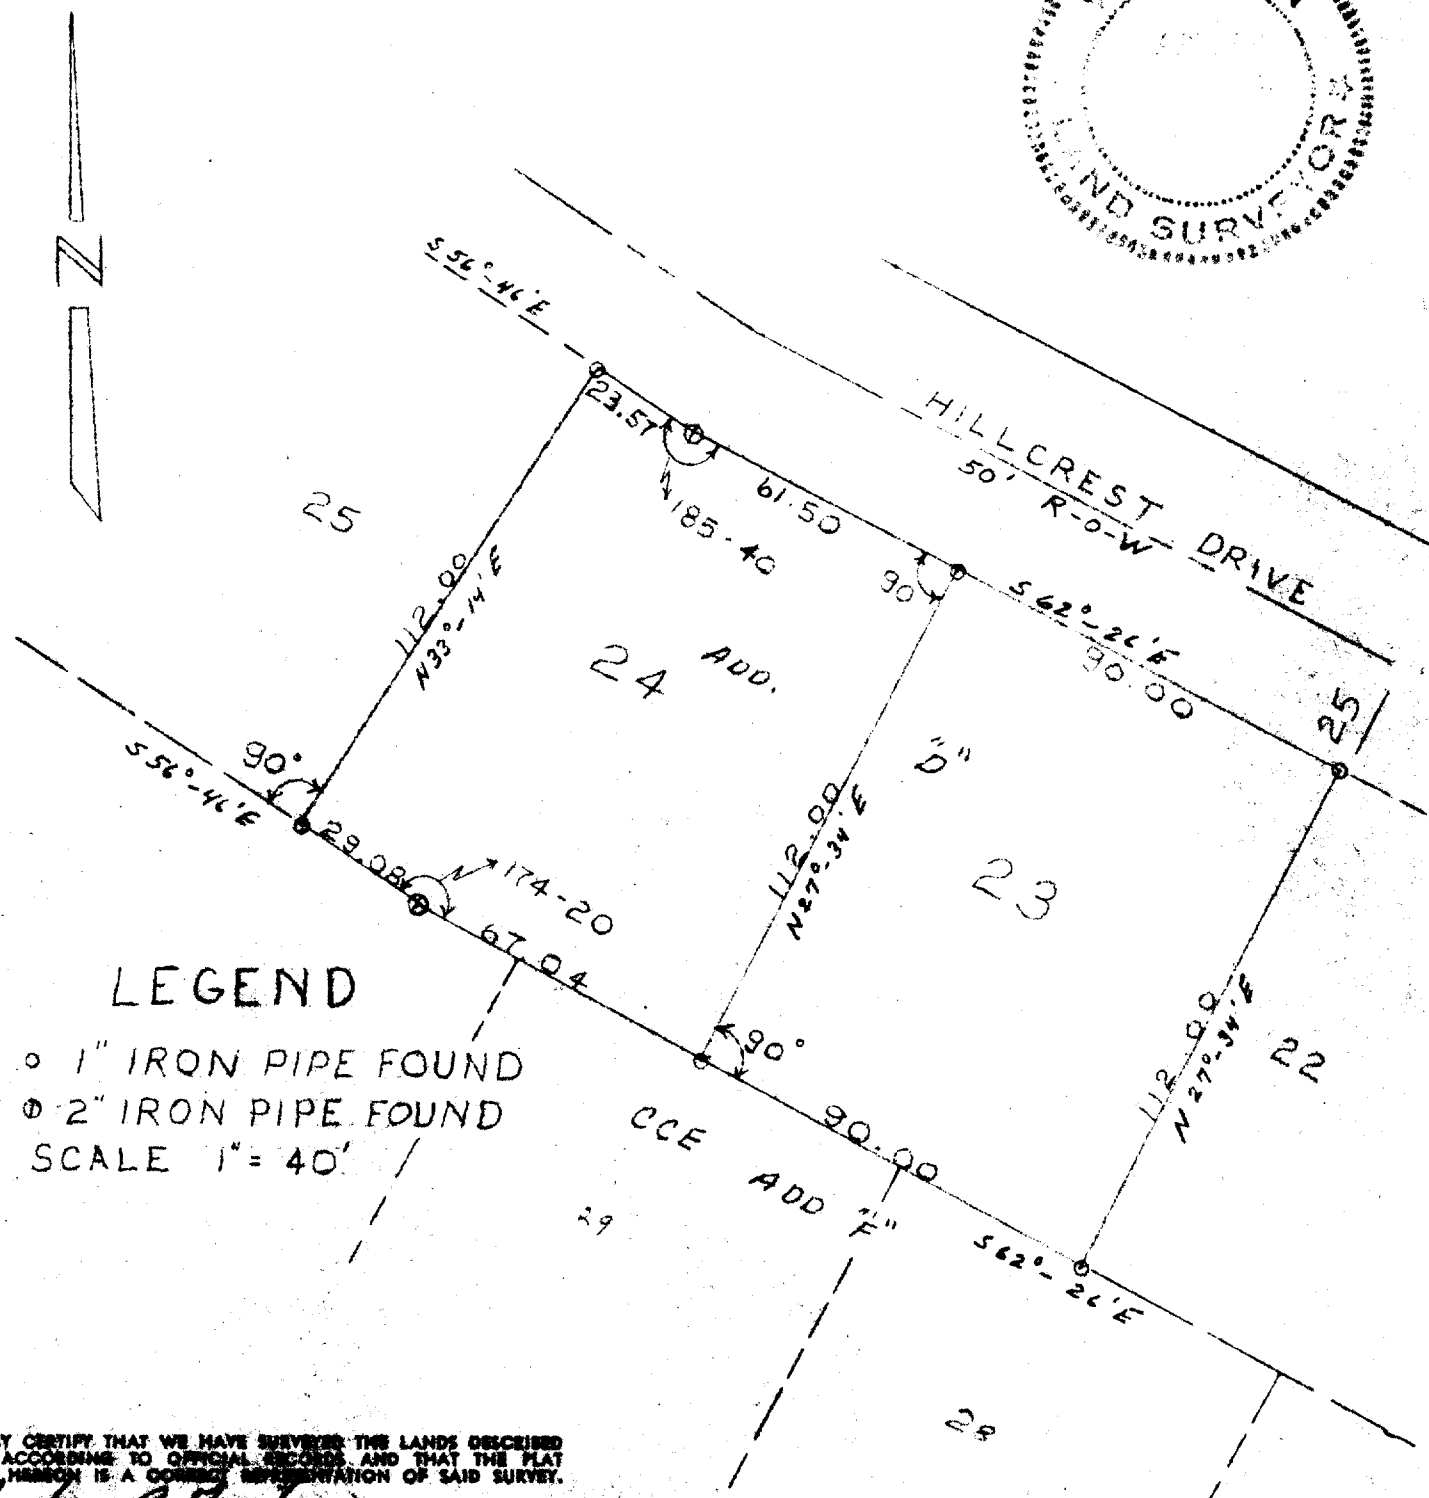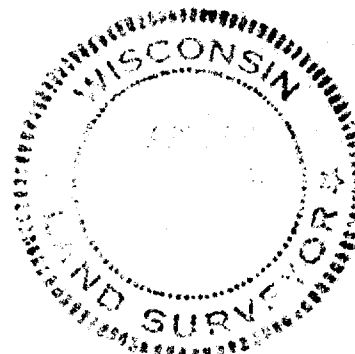

I HEREBY CERTIFY THAT WE HAVE SURVEYED THE LANDS DESCRIBED ABOVE ACCORDING TO OFFICIAL RECORDS AND THAT THE PLAT DRAWN HEREON IS A CORRECT REPRESENTATION OF SAID SURVEY.

Charles R. Fischer
 WIS. REG. LAND SURVEYOR 5070-24, 25

DATE June 1970

5-157

JOB NO. 10077