


HAROLD H. KOLB

REGISTERED PROFESSIONAL LAND SURVEYOR
LAKE GENEVA, WISCONSIN



N

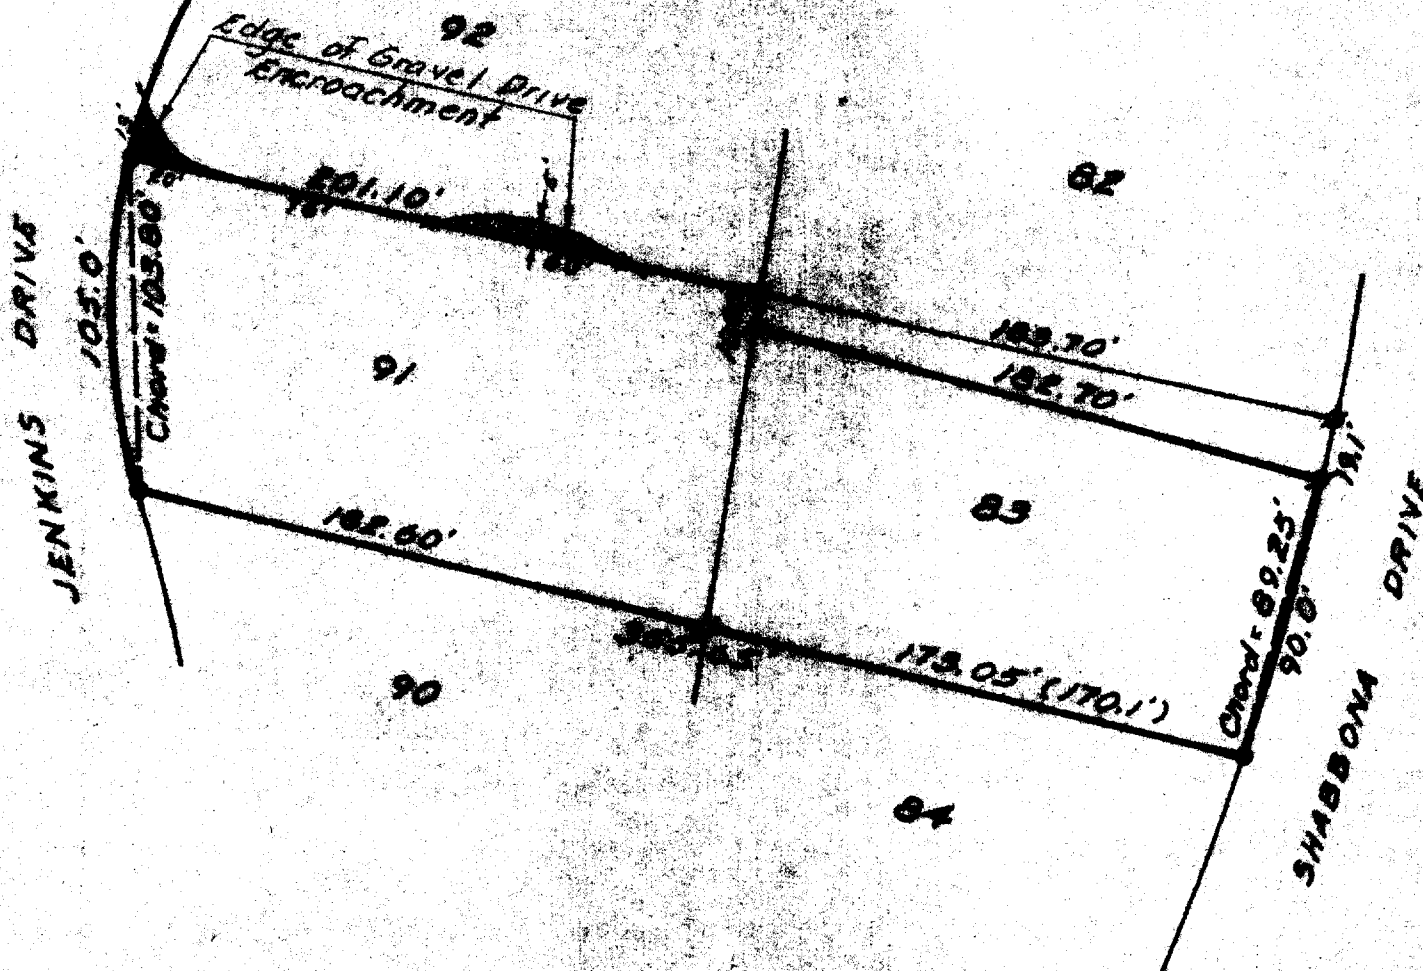

SCALE: 1" = 60'

LEGEND

- # - IRON PIPE MARK
- # - Conc. Monument found
- - CONCRETE MONUMENT SET
- x - SPK
- () - Recorded distance



PLAT OF SURVEY OF

Lot 91 and part of Lot 83, Unit 2, Country Club Estates, Village of Fontana-on-Geneva Lake, Walworth County, Wisconsin.

I, HAROLD H. KOLB, DO HEREBY CERTIFY THAT I HAVE SURVEYED THE PROPERTY HEREIN DESCRIBED ACCORDING TO THE OFFICIAL RECORDS, AND THAT THE PLAT HEREIN IS A CORRECT REPRESENTATION OF THE LOT LINES.

Harold H. Kolb

REGISTERED LAND SURVEYOR, S-187
DATE: 11-1-70

5-16-0A

For 59

5-002-78 4 86