


PLAT OF SURVEY

LOT 1 OF BLOCK 2 OF INDIAN HILLS 1ST
ADDITION, LOCATED IN SECTION 14, TOWN 1
NORTH, RANGE 16 EAST, VILLAGE OF FONTANA,
WALWORTH COUNTY, WISCONSIN.

LOT 17 BLOCK 6 INDIAN HILLS SUBD.

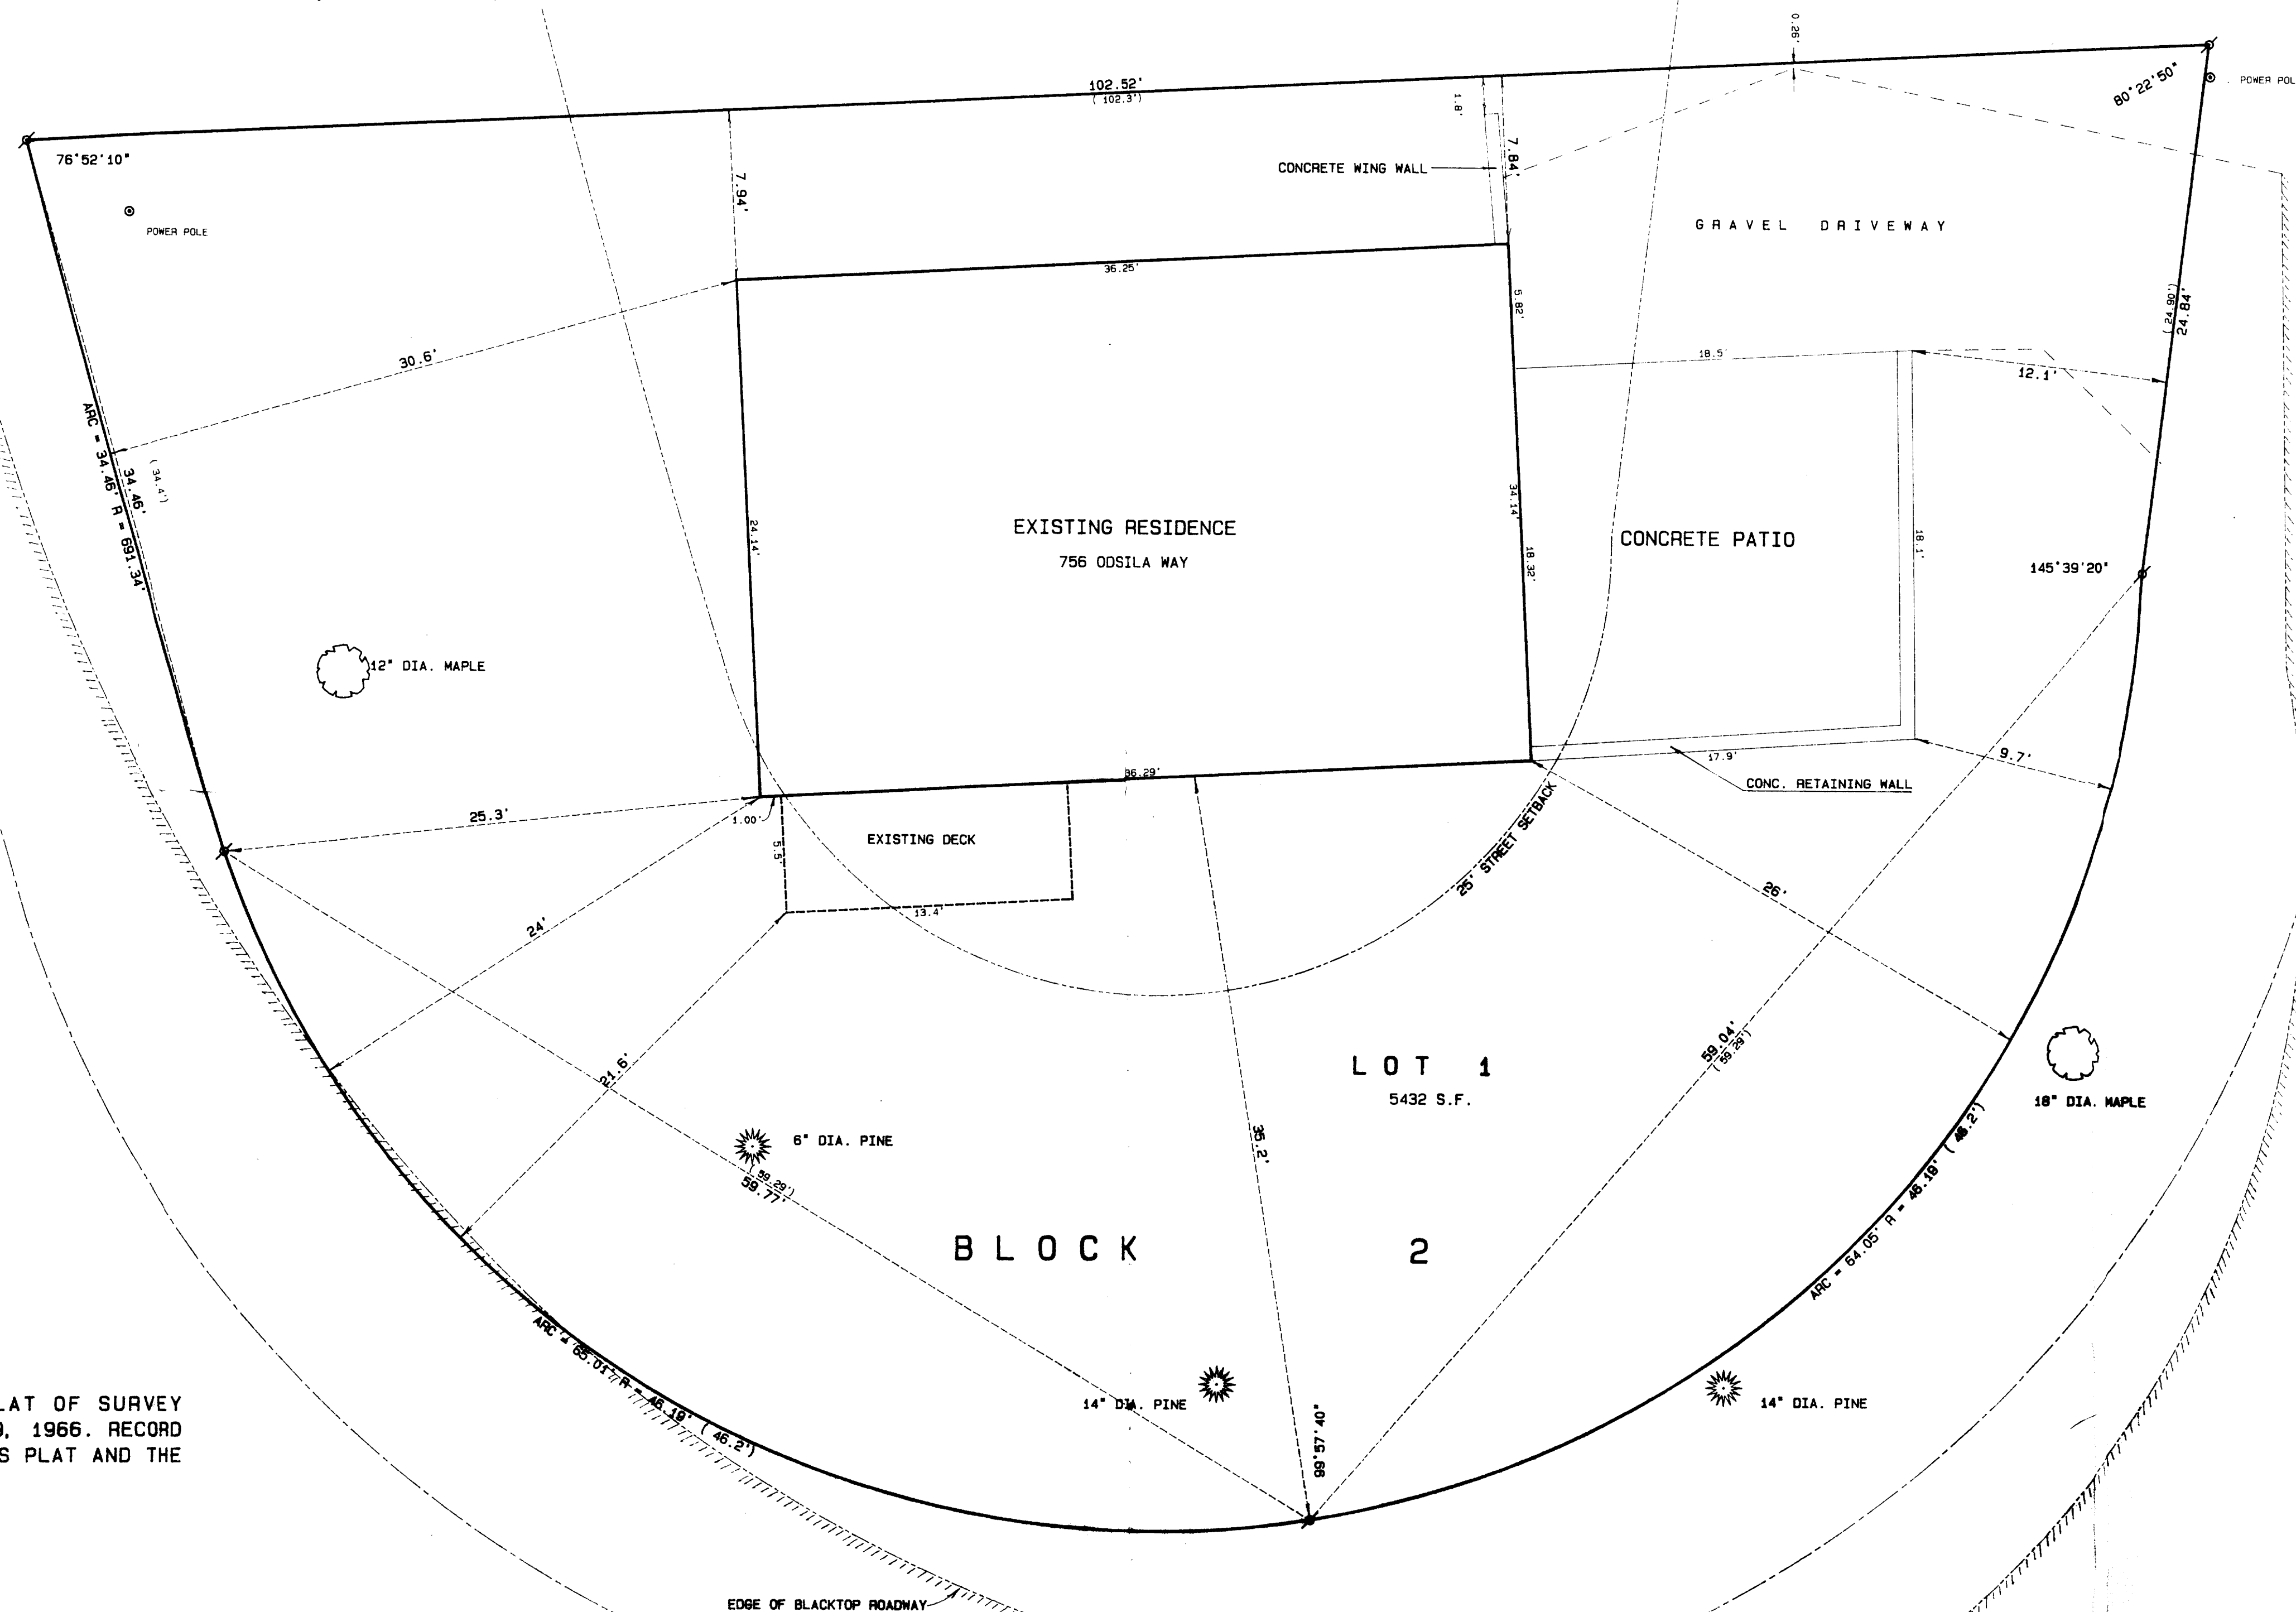

OWNER: DOROTHY JOYCE
2745 W. 99th ST.
CHICAGO, IL. 60655

ORDERED BY: BILL KLEWIN

NOTE:


THIS SURVEY RETRACES A PREVIOUS PLAT OF SURVEY
PREPARED BY GEORGE DUNHAM DATED MARCH 9, 1966. RECORD
DIMENSIONS ARE REFERENCED TO BOTH THIS PLAT AND THE
RECORDED SUBDIVISION.

Legend

- ✂ FOUND IRON PIPE
 - ✂ FOUND IRON ROD
 - FOUND BRASS CAPPED MONUMENT
 - FOUND CONCRETE MONUMENT
 - + CHISEL CUT IN CONCRETE
 - SET IRON ROD, 28" LONG, WEIGHING 1.5 LBS./LINEAL FT., 3/8" DIA.
 - SET IRON ROD, 30" LONG, WEIGHING 4.3 LBS./LINEAL FT., 1-11/16" DIA.
- RECORDED AS DIMENSION
 (xx) EXISTING FENCE



SCALE: 1"= 5 FEET

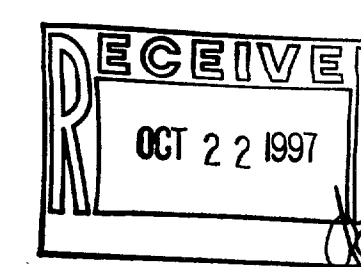

"I hereby certify that the above described property has been surveyed by me or under my direction and that the above map is a true representation thereof and shows the size and location of the property, its exterior boundaries, the location of all visible structures and dimensions of all principal buildings thereon, boundary fences, apparent easements, roadways and visible encroachments, if any."

"This survey is made for the use of the present owners of the property and also those who purchase, mortgage, or guarantee the title thereof within one year from date hereof."

KENNETH B. ABERNATHY JR.
WISCONSIN REGISTERED LAND SURVEYOR,
S-1594
Date: 8-22-97 Job No. 97.802