


Wisconsin Registered Land Surveyor S-1594

Rt. 3, Box 273
Elkhorn, Wisconsin 53121
Phone: (414) 723 4260 (office)
(414) 723 7209 (FAX)

LOT 36 AND 37 OF GLENWOOD TERRACE
SUBDIVISION, LOCATED IN THE NORTH
1/2 OF THE NORTHEAST 1/4 OF THE
NORTHEAST 1/4 OF SECTION 23, TOWN
1 NORTH, RANGE 16 EAST, VILLAGE
OF FONTANA, WALWORTH COUNTY,
WISCONSIN.

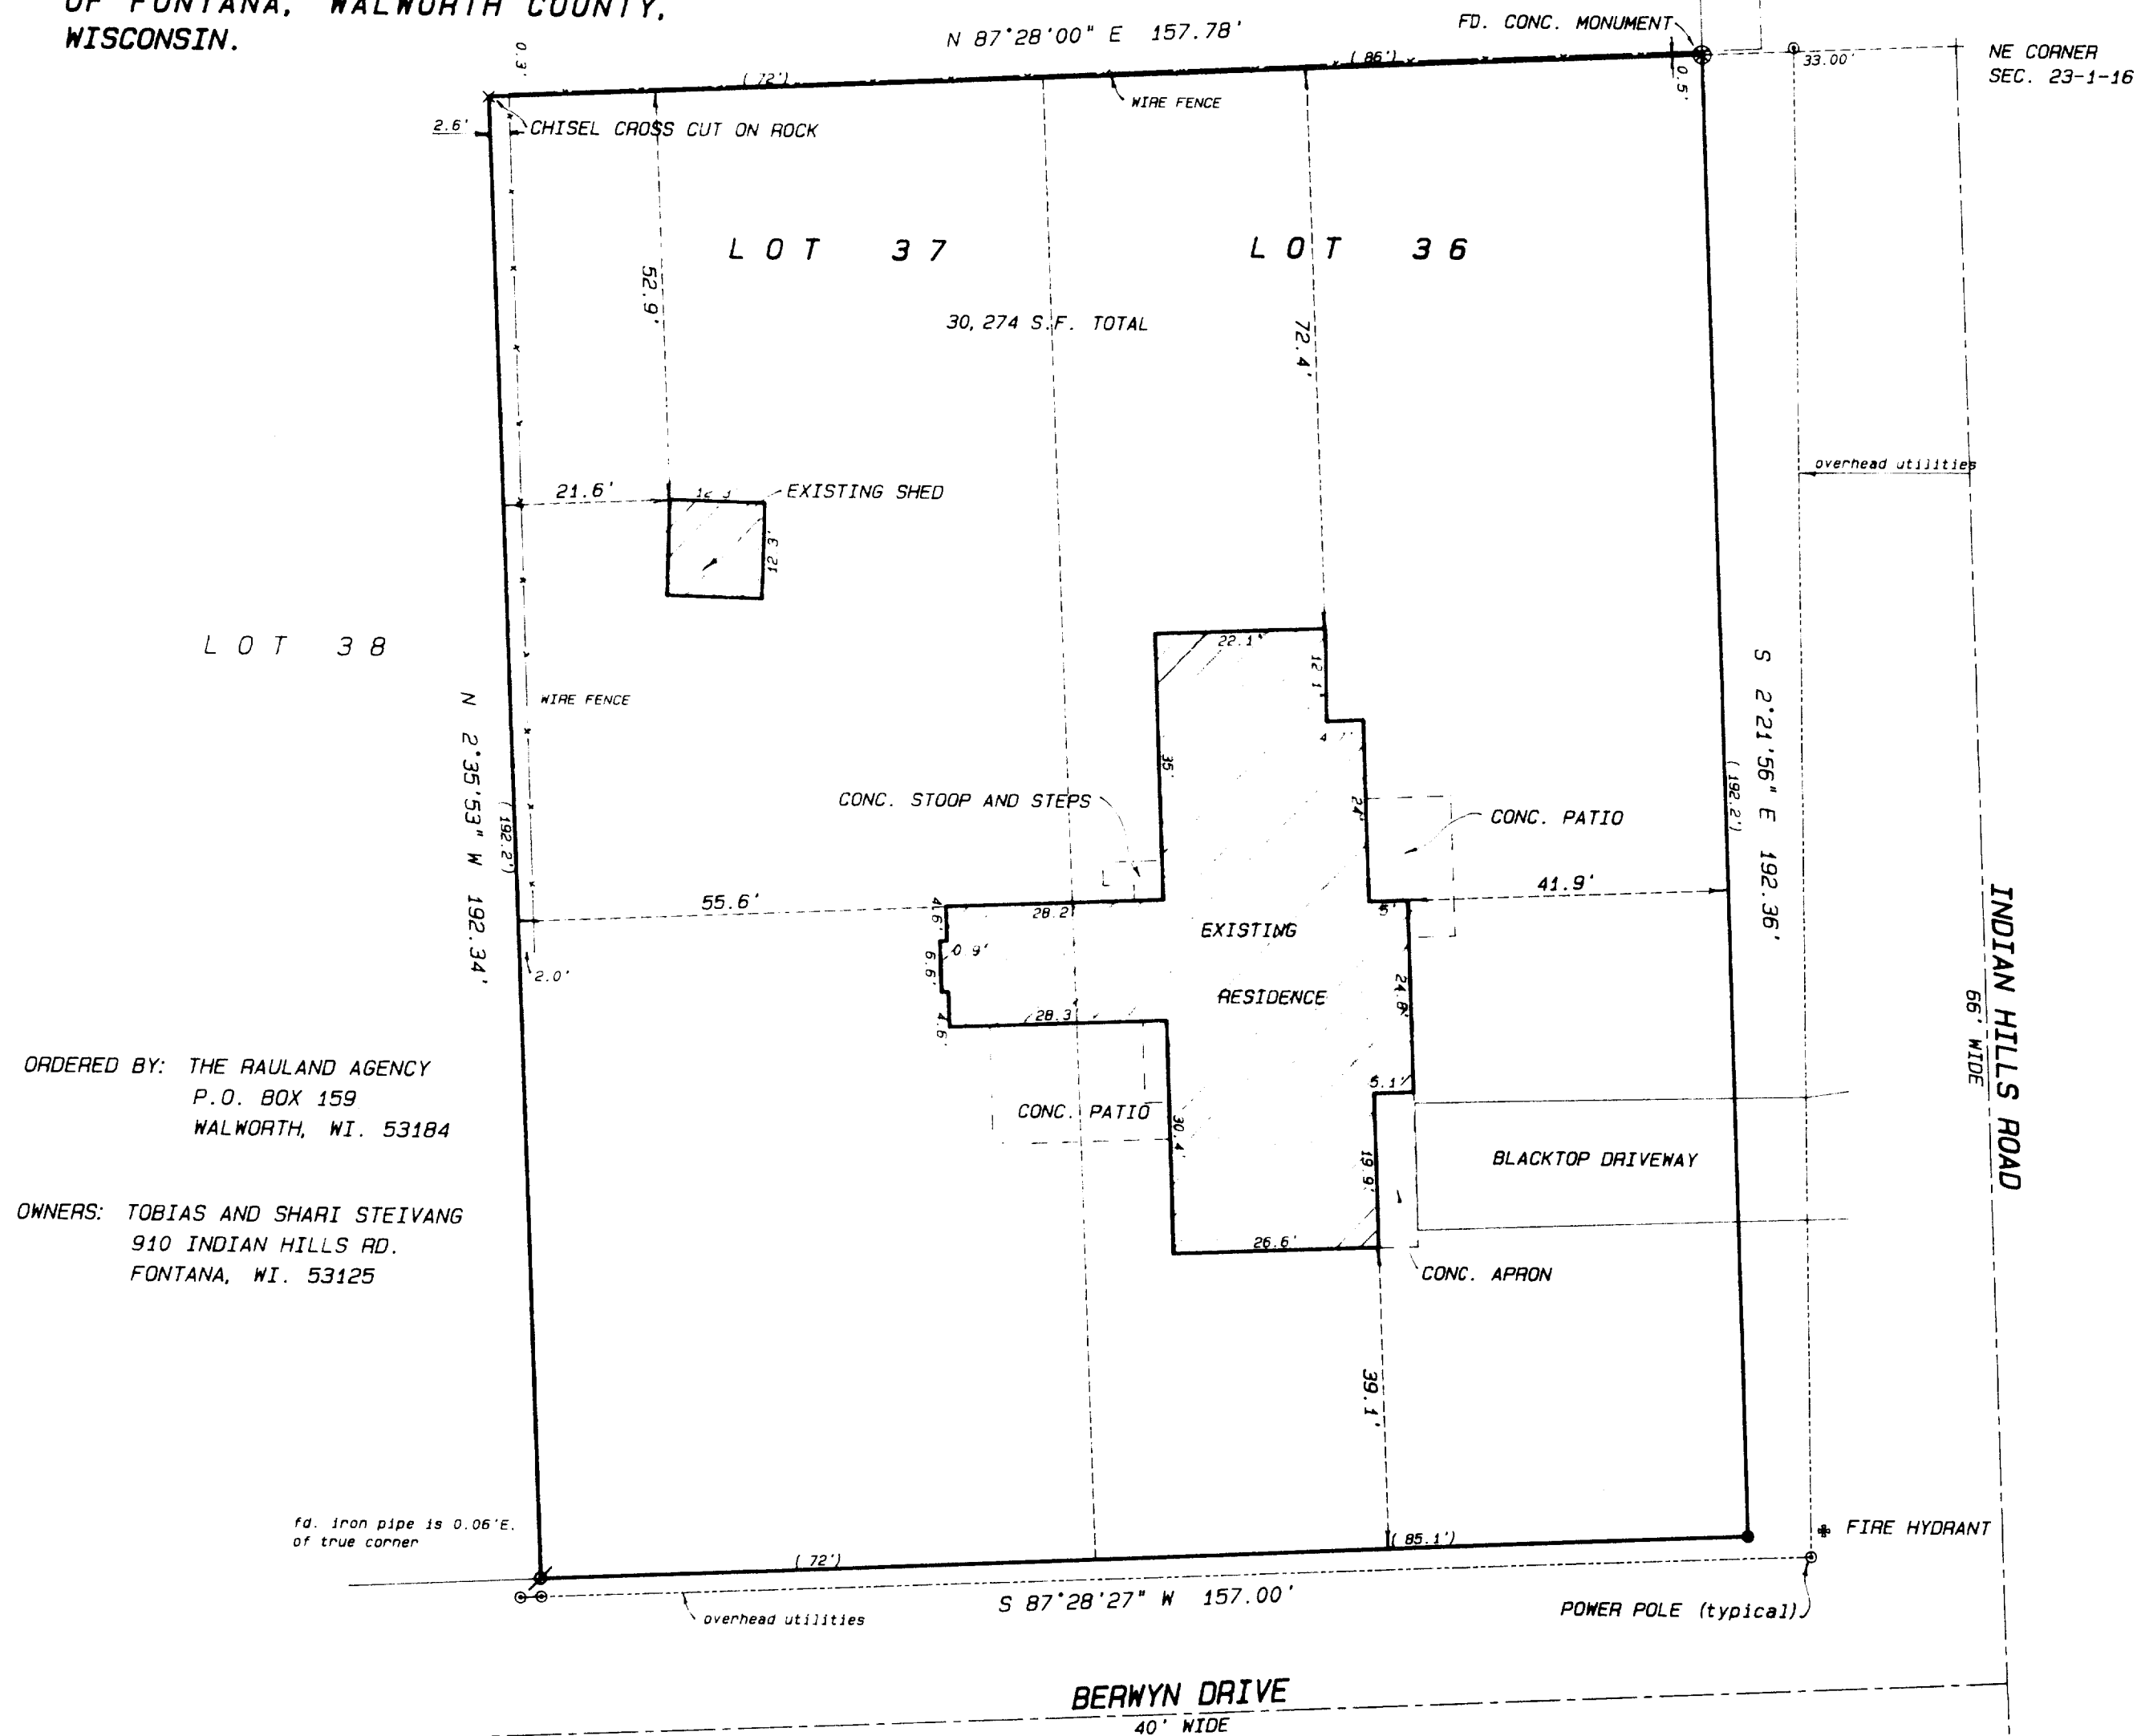


ORDERED BY: THE RAULAND AGENCY
P.O. BOX 159
WALWORTH, WI. 53184


OWNERS: TOBIAS AND SHARI STEIVANG
910 INDIAN HILLS RD.
FONTANA, WI. 53125

Legend

- FOUND IRON PIPE
 - FOUND IRON ROD
 - FOUND BRASS CAPPED MONUMENT
 - ✱ FOUND CONCRETE MONUMENT
 - ✱ CHISEL CUT IN CONCRETE
 - SET IRON ROD, 24" LONG, WEIGHING 3.5 LBS. LINEAL FT., 3 3/4" DIA.
 - SET IRON ROD, 30" LONG, WEIGHING 4.5 LBS. LINEAL FT., 1 1/2 16" DIA.
- (1XX)
- - - - -
RECORDED AS DIMENSION
EXISTING FENCE

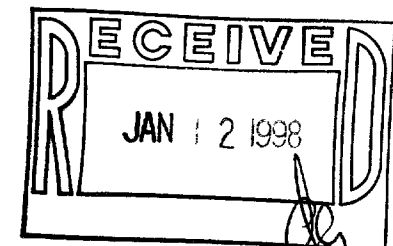

SCALE: 1" = 20 FEET

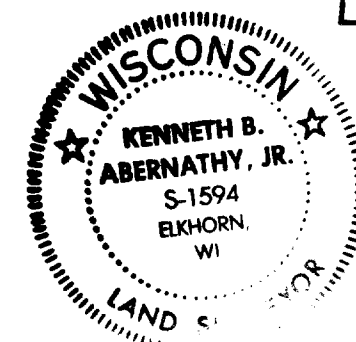

"I hereby certify that the above described property has been surveyed by me in accordance with the direction and that the above map is a true representation thereof and shows the size and location of the property, its exterior boundaries, the location of all visible structures and dimensions of all principal buildings thereon, boundary fences, apparent easements, roadways and visible encroachments, if any."

"I have surveyed the above property for the use of the present owners of the property and also those who purchase, mortgage or guarantee the title thereto within one year from date hereof."

Kennel, B. Smith.

KENNETH B. ABERNATHY, JR.
WISCONSIN REGISTERED LAND SURVEYOR,

Date: 12-10-97 Job No. 97.1206 S-1594

005-1635
SGT-12