

ABELL  
SURVEYING & MAPPING  
1140 SEQUOIA STREET • DELAVAN, WISCONSIN 53115  
414-728-6737

N



SCALE 1"=10'

LEGEND

- ⊙ - IRON PIPE FOUND
- ⊙ - IRON PIPE IN CONCRETE FOUND
- - IRON PIN FOUND
- - IRON ROD FOUND
- \* - WOOD FENCE
- - OVERHEAD UTILITY LINES
- ( ) - RECORDED AS

ORDERED BY: KEEFE REAL ESTATE  
P.O. BOX 460  
LAKE GENEVA, WI 53147

NOTE: THE BEARING OF THE WEST  
LINE OF REID STREET IS  
ASSUMED NORTH-SOUTH.

I HEREBY CERTIFY THAT I HAVE SURVEYED THE ABOVE DESCRIBED PROPERTY AND THAT THE ABOVE MAP IS A TRUE REPRESENTATION THEREOF AND SHOWS THE SIZE AND LOCATION OF THE PROPERTY, ITS EXTERIOR BOUNDARIES, THE LOCATION OF ALL VISIBLE STRUCTURES AND DIMENSIONS OF ALL PRINCIPAL BUILDINGS THEREON, BOUNDARY FENCES, APPARENT EASEMENTS, ROADWAYS AND VISIBLE ENCROACHMENTS, IF ANY, TO THE BEST OF MY KNOWLEDGE AND BELIEF.

THIS SURVEY IS MADE FOR THE USE OF THE PRESENT OWNERS OF THE PROPERTY, AND ALSO THOSE WHO PURCHASE, MORTGAGE, OR GUARANTEE THE TITLE THERETO WITHIN ONE (1) YEAR FROM DATE HEREON.


*David F. Abell*

DAVID F. ABELL  
WISCONSIN REGISTERED LAND SURVEYOR, S-1596

December 15, 1997

DATE: December 15, 1997 JOB NUMBER - 97226  
NOTE: THIS IS NOT A CERTIFIED COPY UNLESS SEALED.

BLOCK

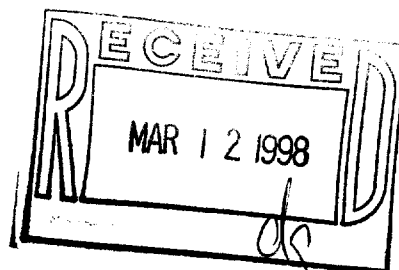

PLAT OF SURVEY OF  
The South 1/2 of Lot 6 in Block 4; Lot 7 in Block 4 excluding the South 2 feet of the East 54.63 feet; the North 3 feet of the West 52.95 feet of Lot 8 in Block 4 of D. A. Reids Addition to Reids Park, in the Village of Fontana, Walworth County, Wisconsin.

Tax Key No. SRA 00025

SRA-25

005-1641