

~~MOONANSON & ROBERTS, INC.~~

CONSULTING ENGINEERS & LAND SURVEYORS

PHONE (414) 763-2652

116 E. CHESTNUT ST.


BURLINGTON, WIS. 53105

RE: Survey

Lot 56 The Gardens (revised plat)

Adjacent to Fortina-on-Geneva Lake

Waukesha County, Wisconsin

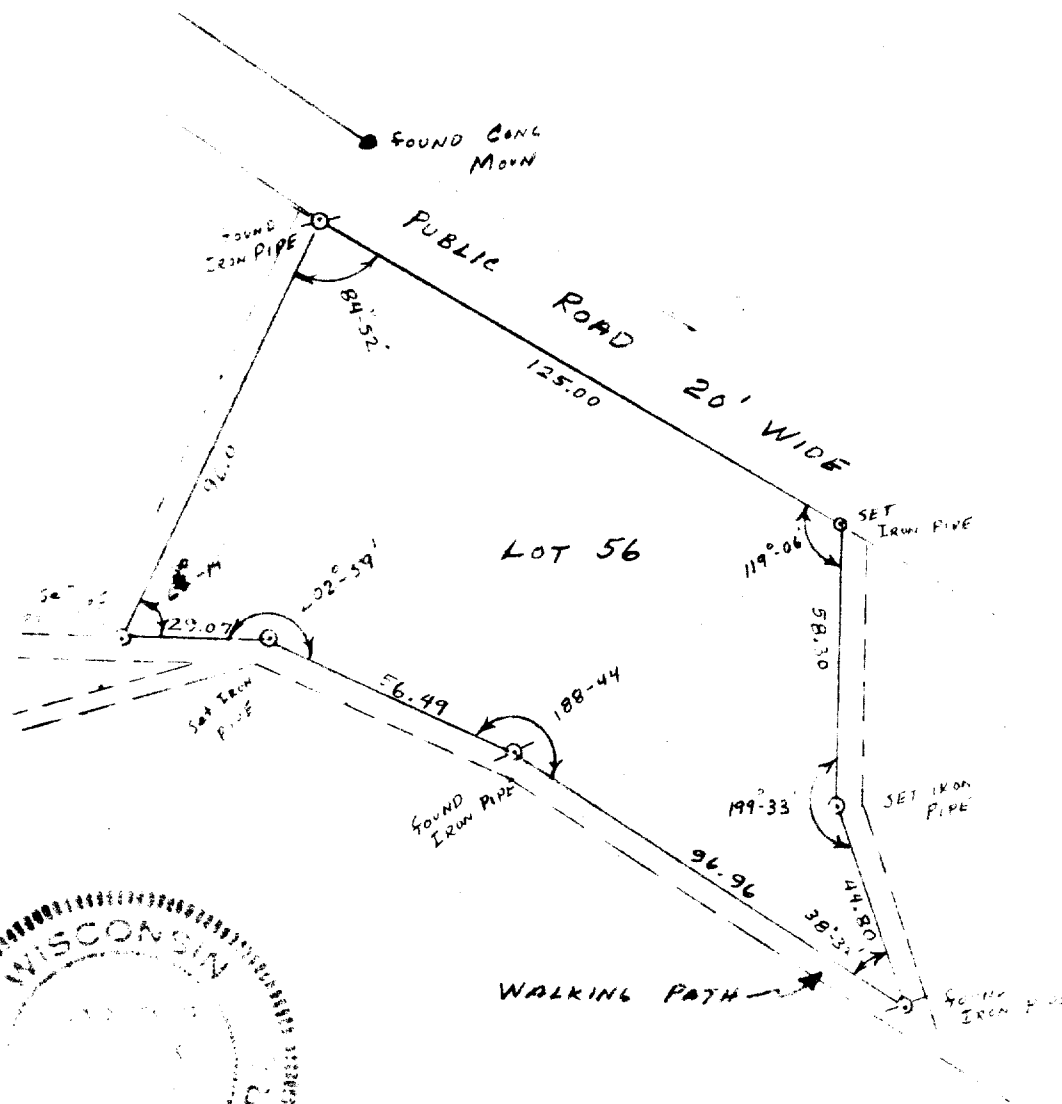

NOTE: PLAT CALLS OUT
WALKING PATH AL-
LOT LINE. SHOWN
SHOWN LOT LINES
AS PATH LINE
THIS PLAT

I HEREBY CERTIFY THAT WE HAVE SURVEYED THE LANDS DESCRIBED
ABOVE ACCORDING TO OFFICIAL RECORDS AND THAT THE PLAT
DRAWN HEREON IS A CORRECT REPRESENTATION OF SAID SURVEY.

WIS. REG. LAND SURVEYOR

DATE

4/15/70

5-166

JOB NO.

10000

56-55