

HOGANSON & ROBERS, INC.
CONSULTING ENGINEERS & LAND SURVEYORS

PHONE (414) 763-2652


116 E. CHESTNUT ST.

BURLINGTON, WIS. 53105

PLAT OF SURVEY

of


Lot 25 of Block 4, Indian Hills First Addition to the Village of Fontana-on-Geneva Lake
 Walworth County, Wisconsin.

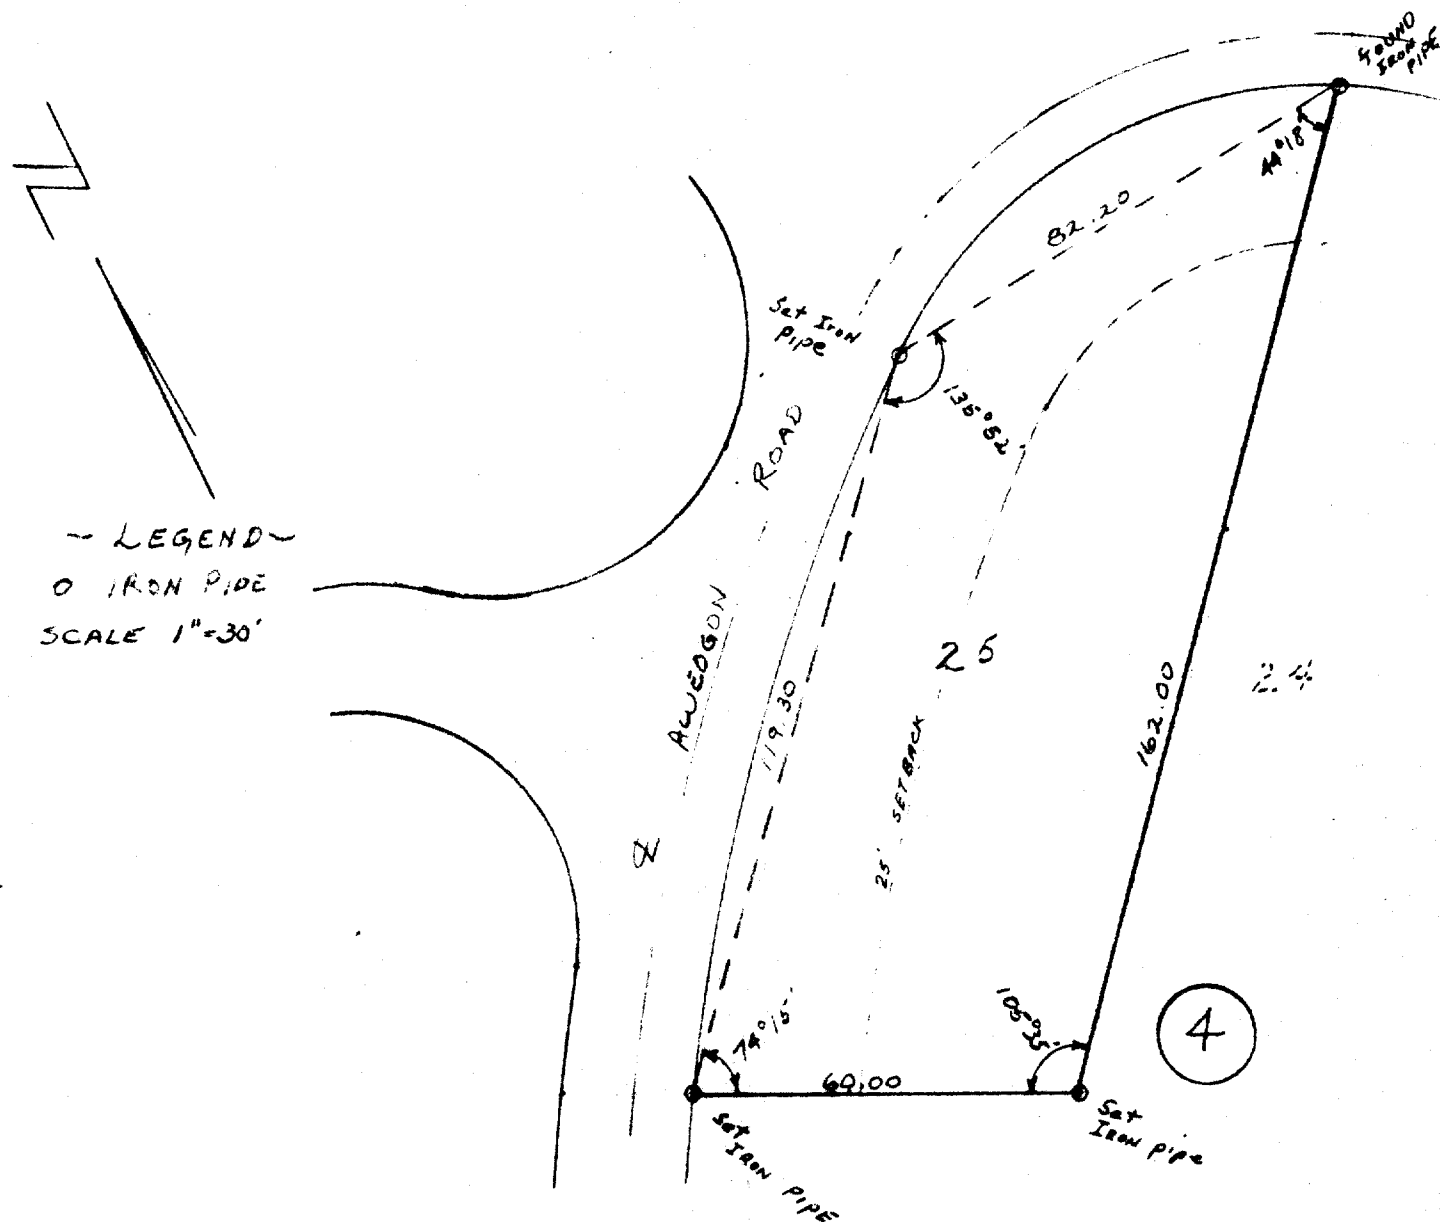

I HEREBY CERTIFY THAT WE HAVE SURVEYED THE LANDS DESCRIBED
 ABOVE ACCORDING TO OFFICIAL RECORDS AND THAT THE PLAT
 DRAWN HEREON IS A CORRECT REPRESENTATION OF SAID SURVEY.

Charles E. Fisher
 WIS. REG. LAND SURVEYOR

DATE 3-13-70

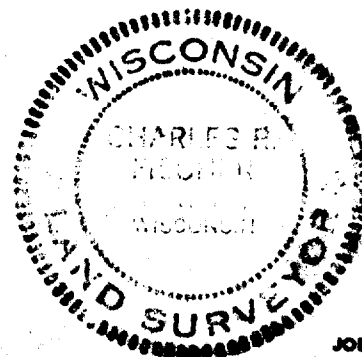

JOB NO. 5-171
70019-B