


1140 SEQUOIA STREET • DELAVAN, WISCONSIN 53115
414-728-6737


ST. ANDREWS TRAIL

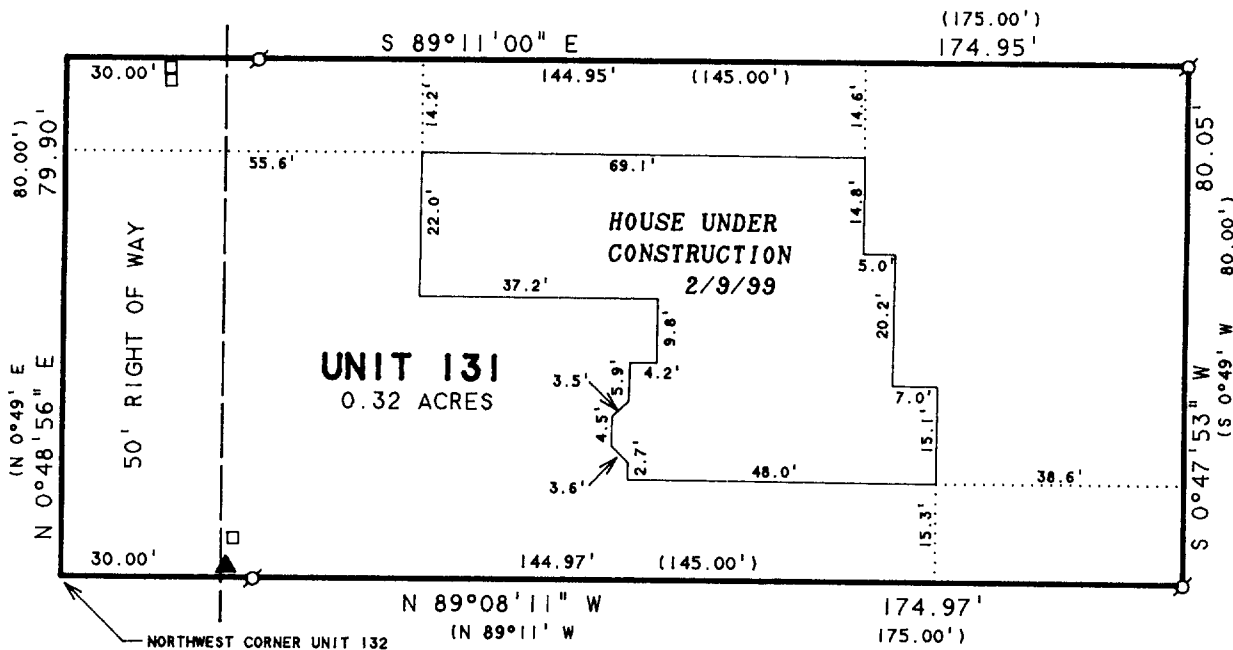

UNIT 131 OF ABBEY SPRINGS

Beginning at the North-West corner of Unit 132 of Abbey Springs; thence N0°-49'E, 80.00 feet; thence S89°-11'E, 175.00 feet; thence S0°-49'W, 80.00 feet; thence N89°-11'W, 175.00 feet to the point of beginning, containing 0.3214 acres more or less.

NOTE: BEARINGS ARE REFERENCED TO THE
RECORDED CONDOMINIUM PLAT.

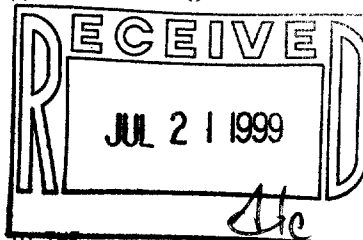

LEGEND

- Ø - IRON PIPE FOUND
 () - RECORDED AS
 □ - UTILITY PED
 ▲ - HYDRANT

THIS SURVEY IS MADE FOR THE USE OF THE PRESENT OWNERS OF THE PROPERTY, AND ALSO THOSE WHO PURCHASE, MORTGAGE, OR GUARANTEE THE TITLE THERETO WITHIN ONE (1) YEAR FROM DATE HEREON.

DAVID F. ABELL
WISCONSIN REGISTERED LAND SURVEYOR, S-1596

February 12, 1999

DATE _____ JOB NUMBER - 99011
NOTE: THIS IS NOT A CERTIFIED COPY UNLESS SEALED.

SCDB 4-131

005-1716