


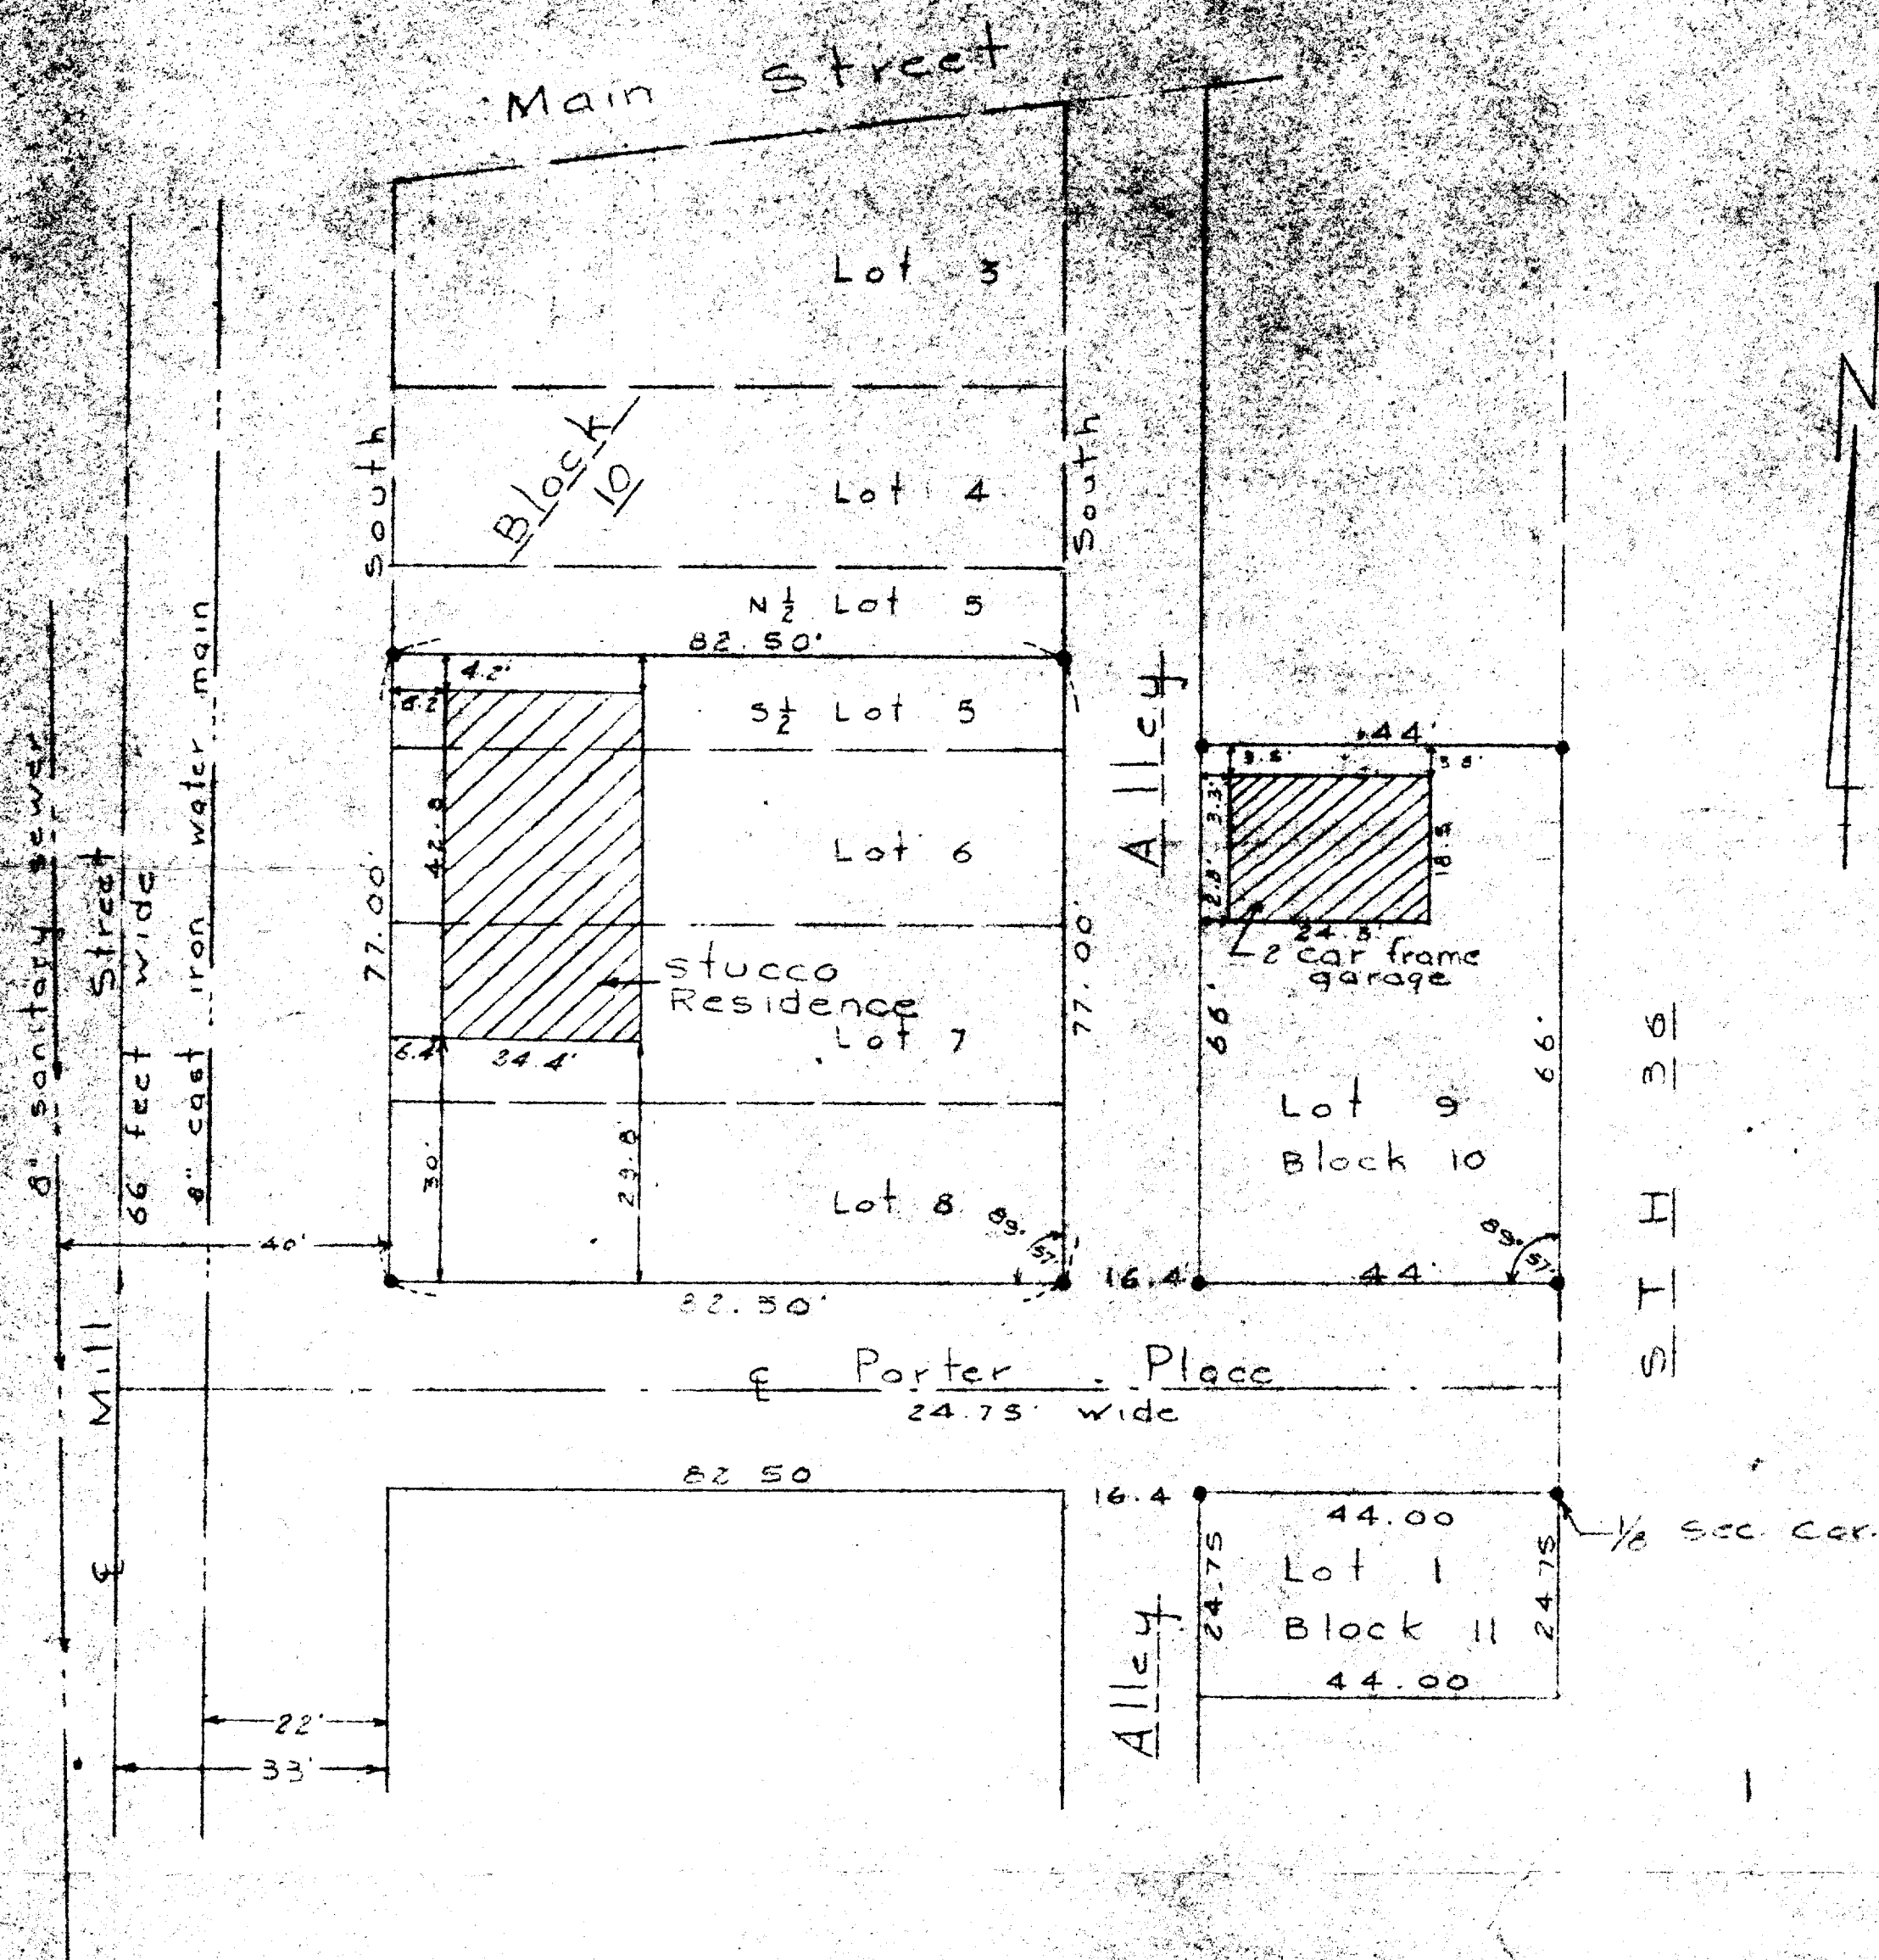

S
T
R
E
E
T

LEGEND

- = concrete monument

PLAT OF SURVEY OF

5 1/2 Lot 5, all of Lots 6, 7, 8, 9,
Block 10 and Lot 1 Block
11 of the Original Plat
of Fontana, T. 1 N. R. 16 E.
of North County, Wis. *[Signature]*