

ABERNATHY and ASSOCIATES

Kenneth B. Abernathy Jr.

Wisconsin Registered Land Surveyor S-1594

Rt. 3, Box 273
Elkhorn, Wisconsin 53121
Phone: (414) 723 4260 (office)
(414) 723 7209 (FAX)

PLAT OF SURVEY


LOTS 1 AND 2 OF CERTIFIED SURVEY MAP NO. 2950 AS RECORDED IN VOL. 15 OF CERTIFIED SURVEY MAPS AS PAGES 241 and 242 AS DOCUMENT NO. 376035.

OWNERS: THOMAS AND MELVA BREITENSTEIN
297 N. BAY CT.
BARRINGTON, IL. 50010

NOTE:

ALL EXTERIOR CORNERS WERE FOUND AND MARKED ON 8/20/99.

DETAIL OF EXISTING RESIDENCE

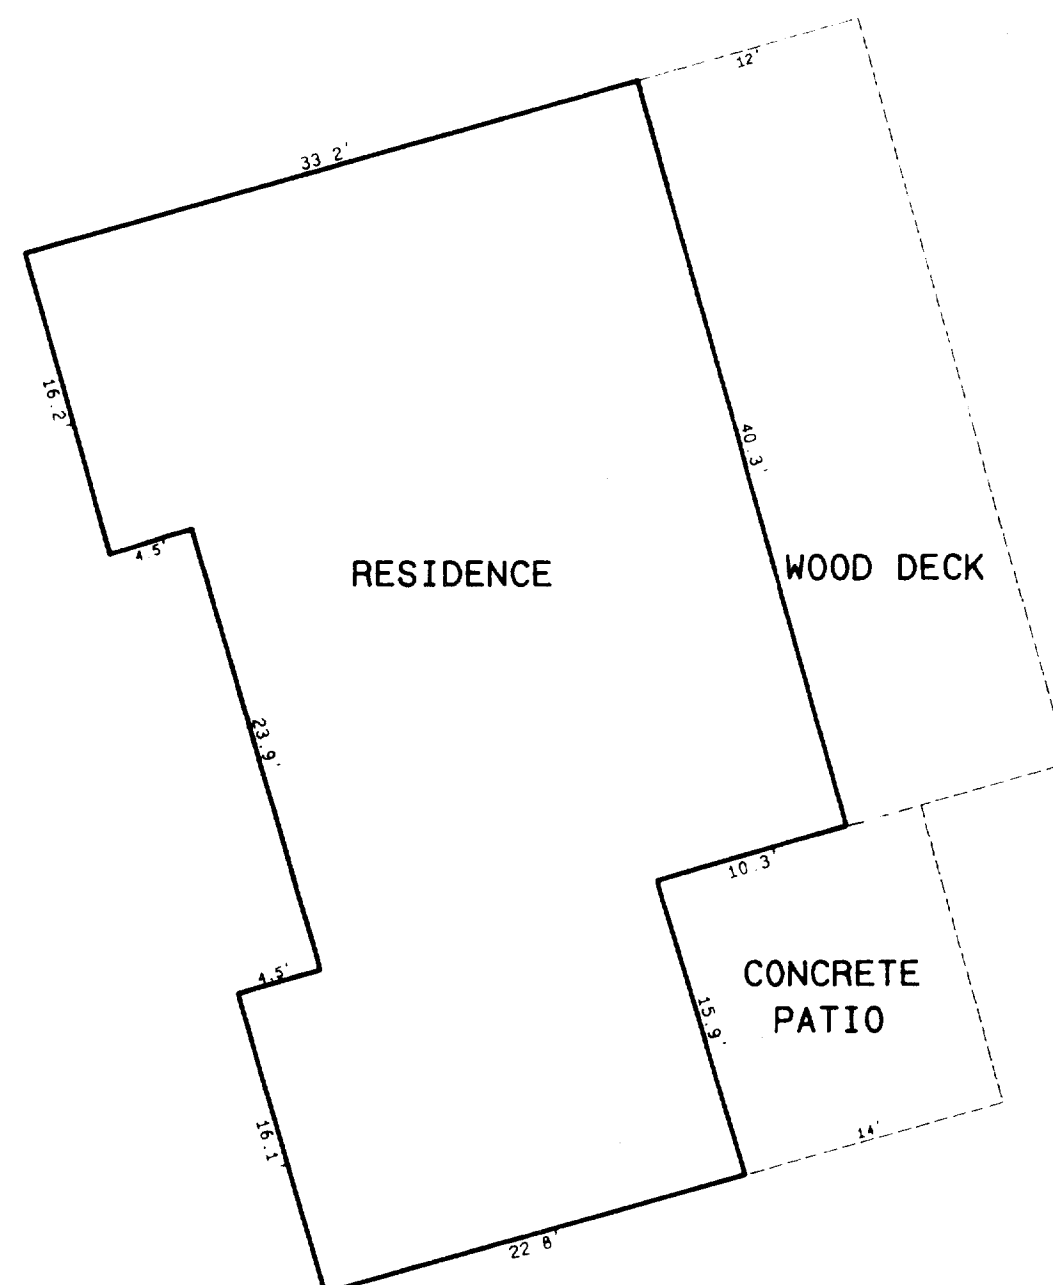


376035

CERTIFIED SURVEY MAP NO. 2950 VOL. 15
PAGES 241, 242


BEING A DIVISION OF LOT 19 OF CLUB UNIQUE, A SUBDIVISION LOCATED IN THE NORTHEAST 1/4 OF THE SOUTHEAST 1/4 OF SECTION 14 TOWN 1 NORTH, RANGE 16 EAST, VILLAGE OF FONTANA-ON GENEVA LAKE, WALWORTH COUNTY, WISCONSIN.

OWNERS: TOM AND MELVA BREITENSTEIN
RFD BOX 3275
LONG GROVE, IL. 60047

SURVEYOR: KENNETH B. ABERNATHY JR.
R/S NO. S 1594
W4056 BRAY RD.
ELKHORN, WI 53121
414-723-4260

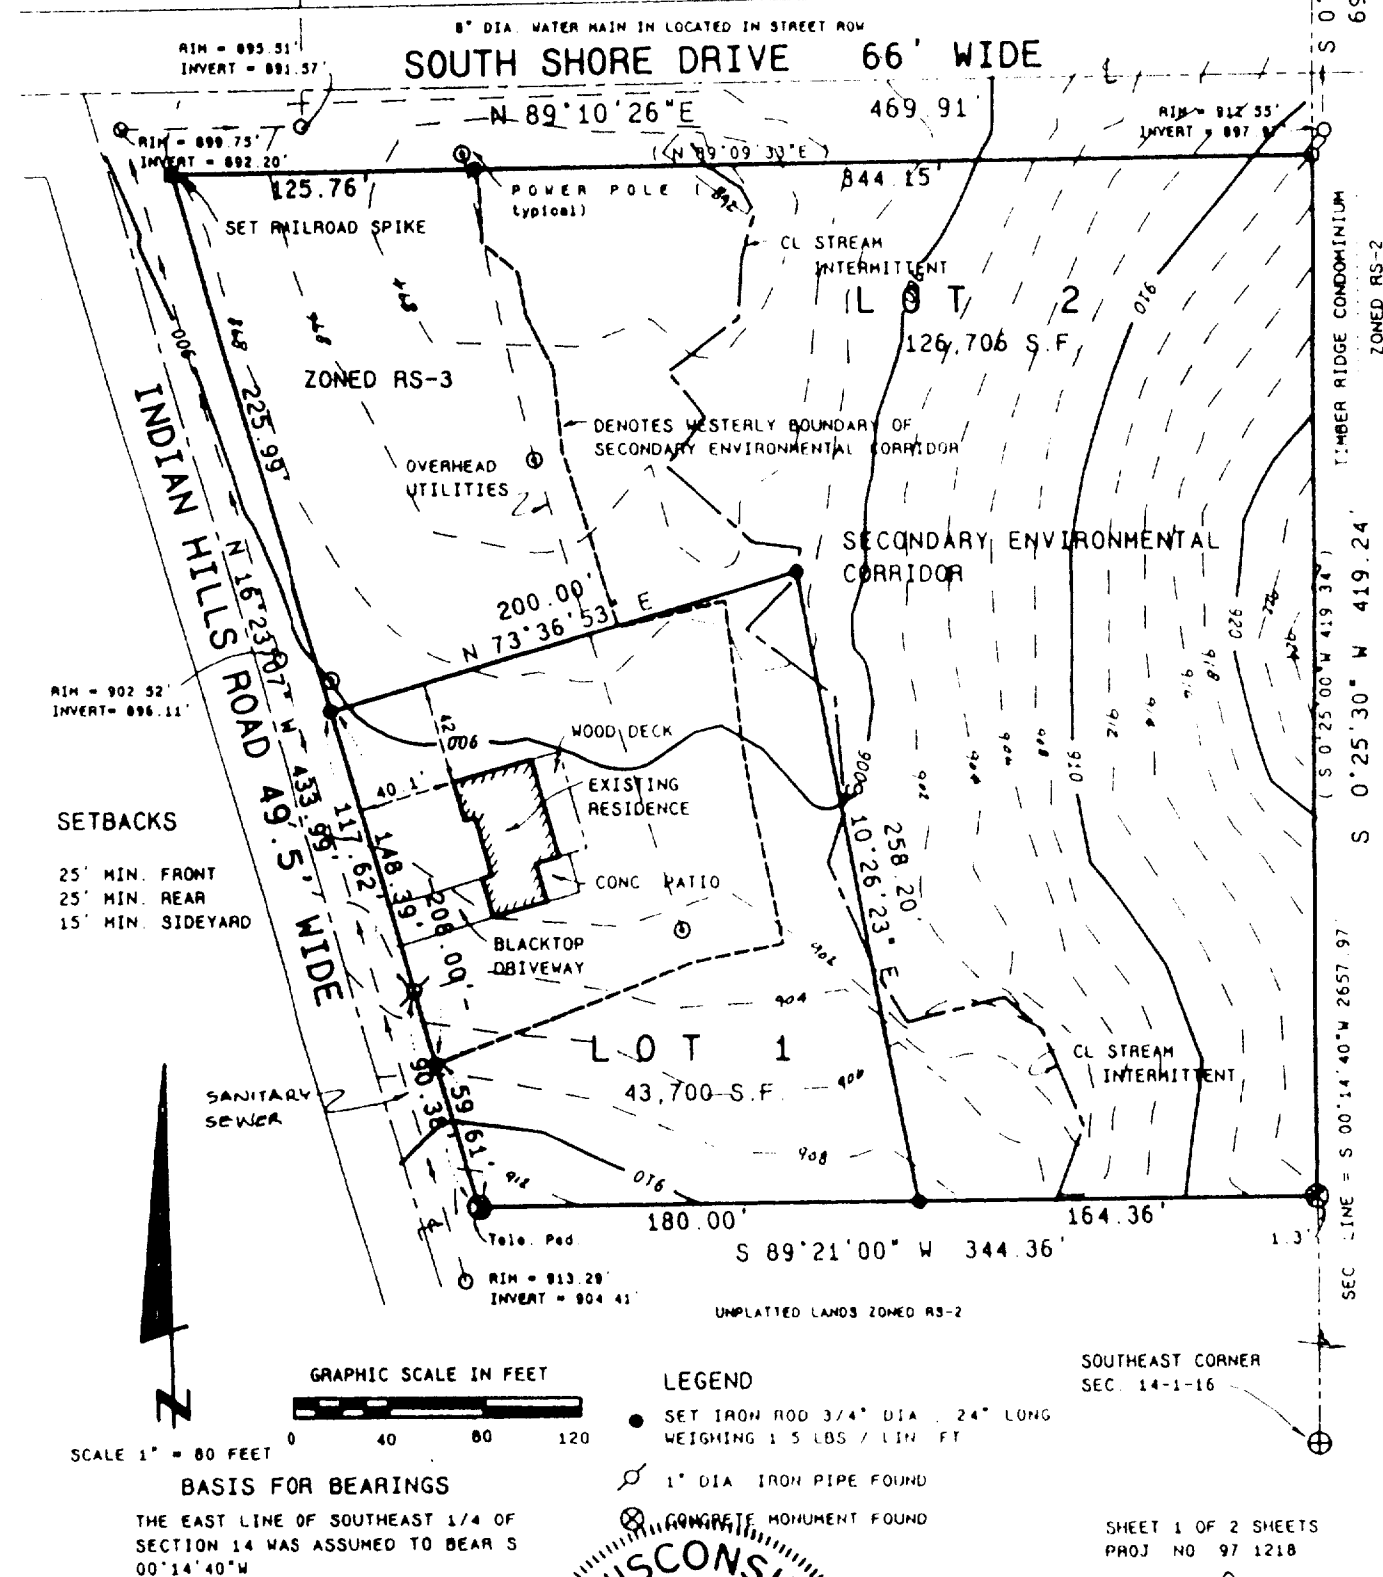


C. S. #2950

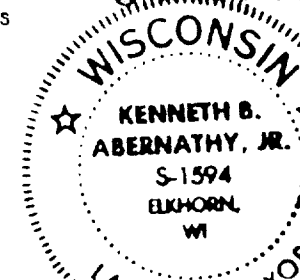


RECEIVED
FEB 7 1998
REVISED FEB 9 1998

VOLUME 15 PAGE 241

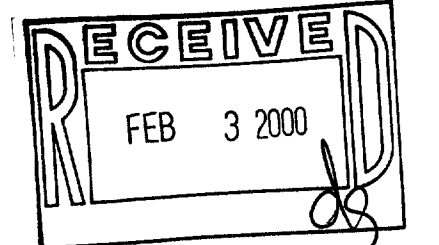

Legend

- FOUND IRON PIPE
- FOUND IRON ROD
- FOUND BRASS CAPPED MONUMENT
- FOUND CONCRETE MONUMENT
- CHISEL CUT IN CONCRETE
- SET IRON ROD 24" LONG WEIGHING 1.5 LBS. LINEAL FT. 1/4" DIA.
- SET IRON ROD 40" LONG WEIGHING 4.5 LBS. LINEAL FT. 1/4" DIA.
- RECORDED AS DIMENSION
- EXISTING FENCE

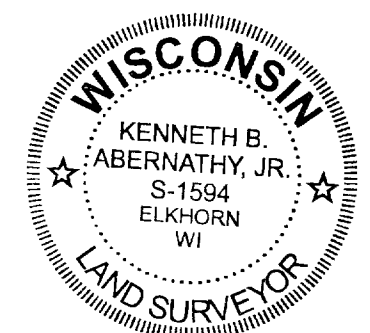

SCALE 1" = 80 FEET

Keneth B. Abernathy, Jr.
KENNETH B. ABERNATHY, JR.
WISCONSIN REGISTERED LAND SURVEYOR,
S-1594

SA-2950-2 9/22/99 Job No. 97.1218

SA-2950-1

005-1780