


Kenneth B. Abernathy Jr.

Wisconsin Registered Land Surveyor S-1594

Rt. 3, Box 273
Elkhorn, Wisconsin 53121
Phone: (414) 723 4260 (office)
(414) 723 7209 (FAX)

PLAT OF SURVEY

LOT 36 AND 37 OF GLENWOOD TERRACE
SUBDIVISION, LOCATED IN THE NORTH
1/2 OF THE NORTHEAST 1/4 OF THE
NORTHEAST 1/4 OF SECTION 23, TOWN
1 NORTH, RANGE 16 EAST, VILLAGE
OF FONTANA, WALWORTH COUNTY,
WISCONSIN.

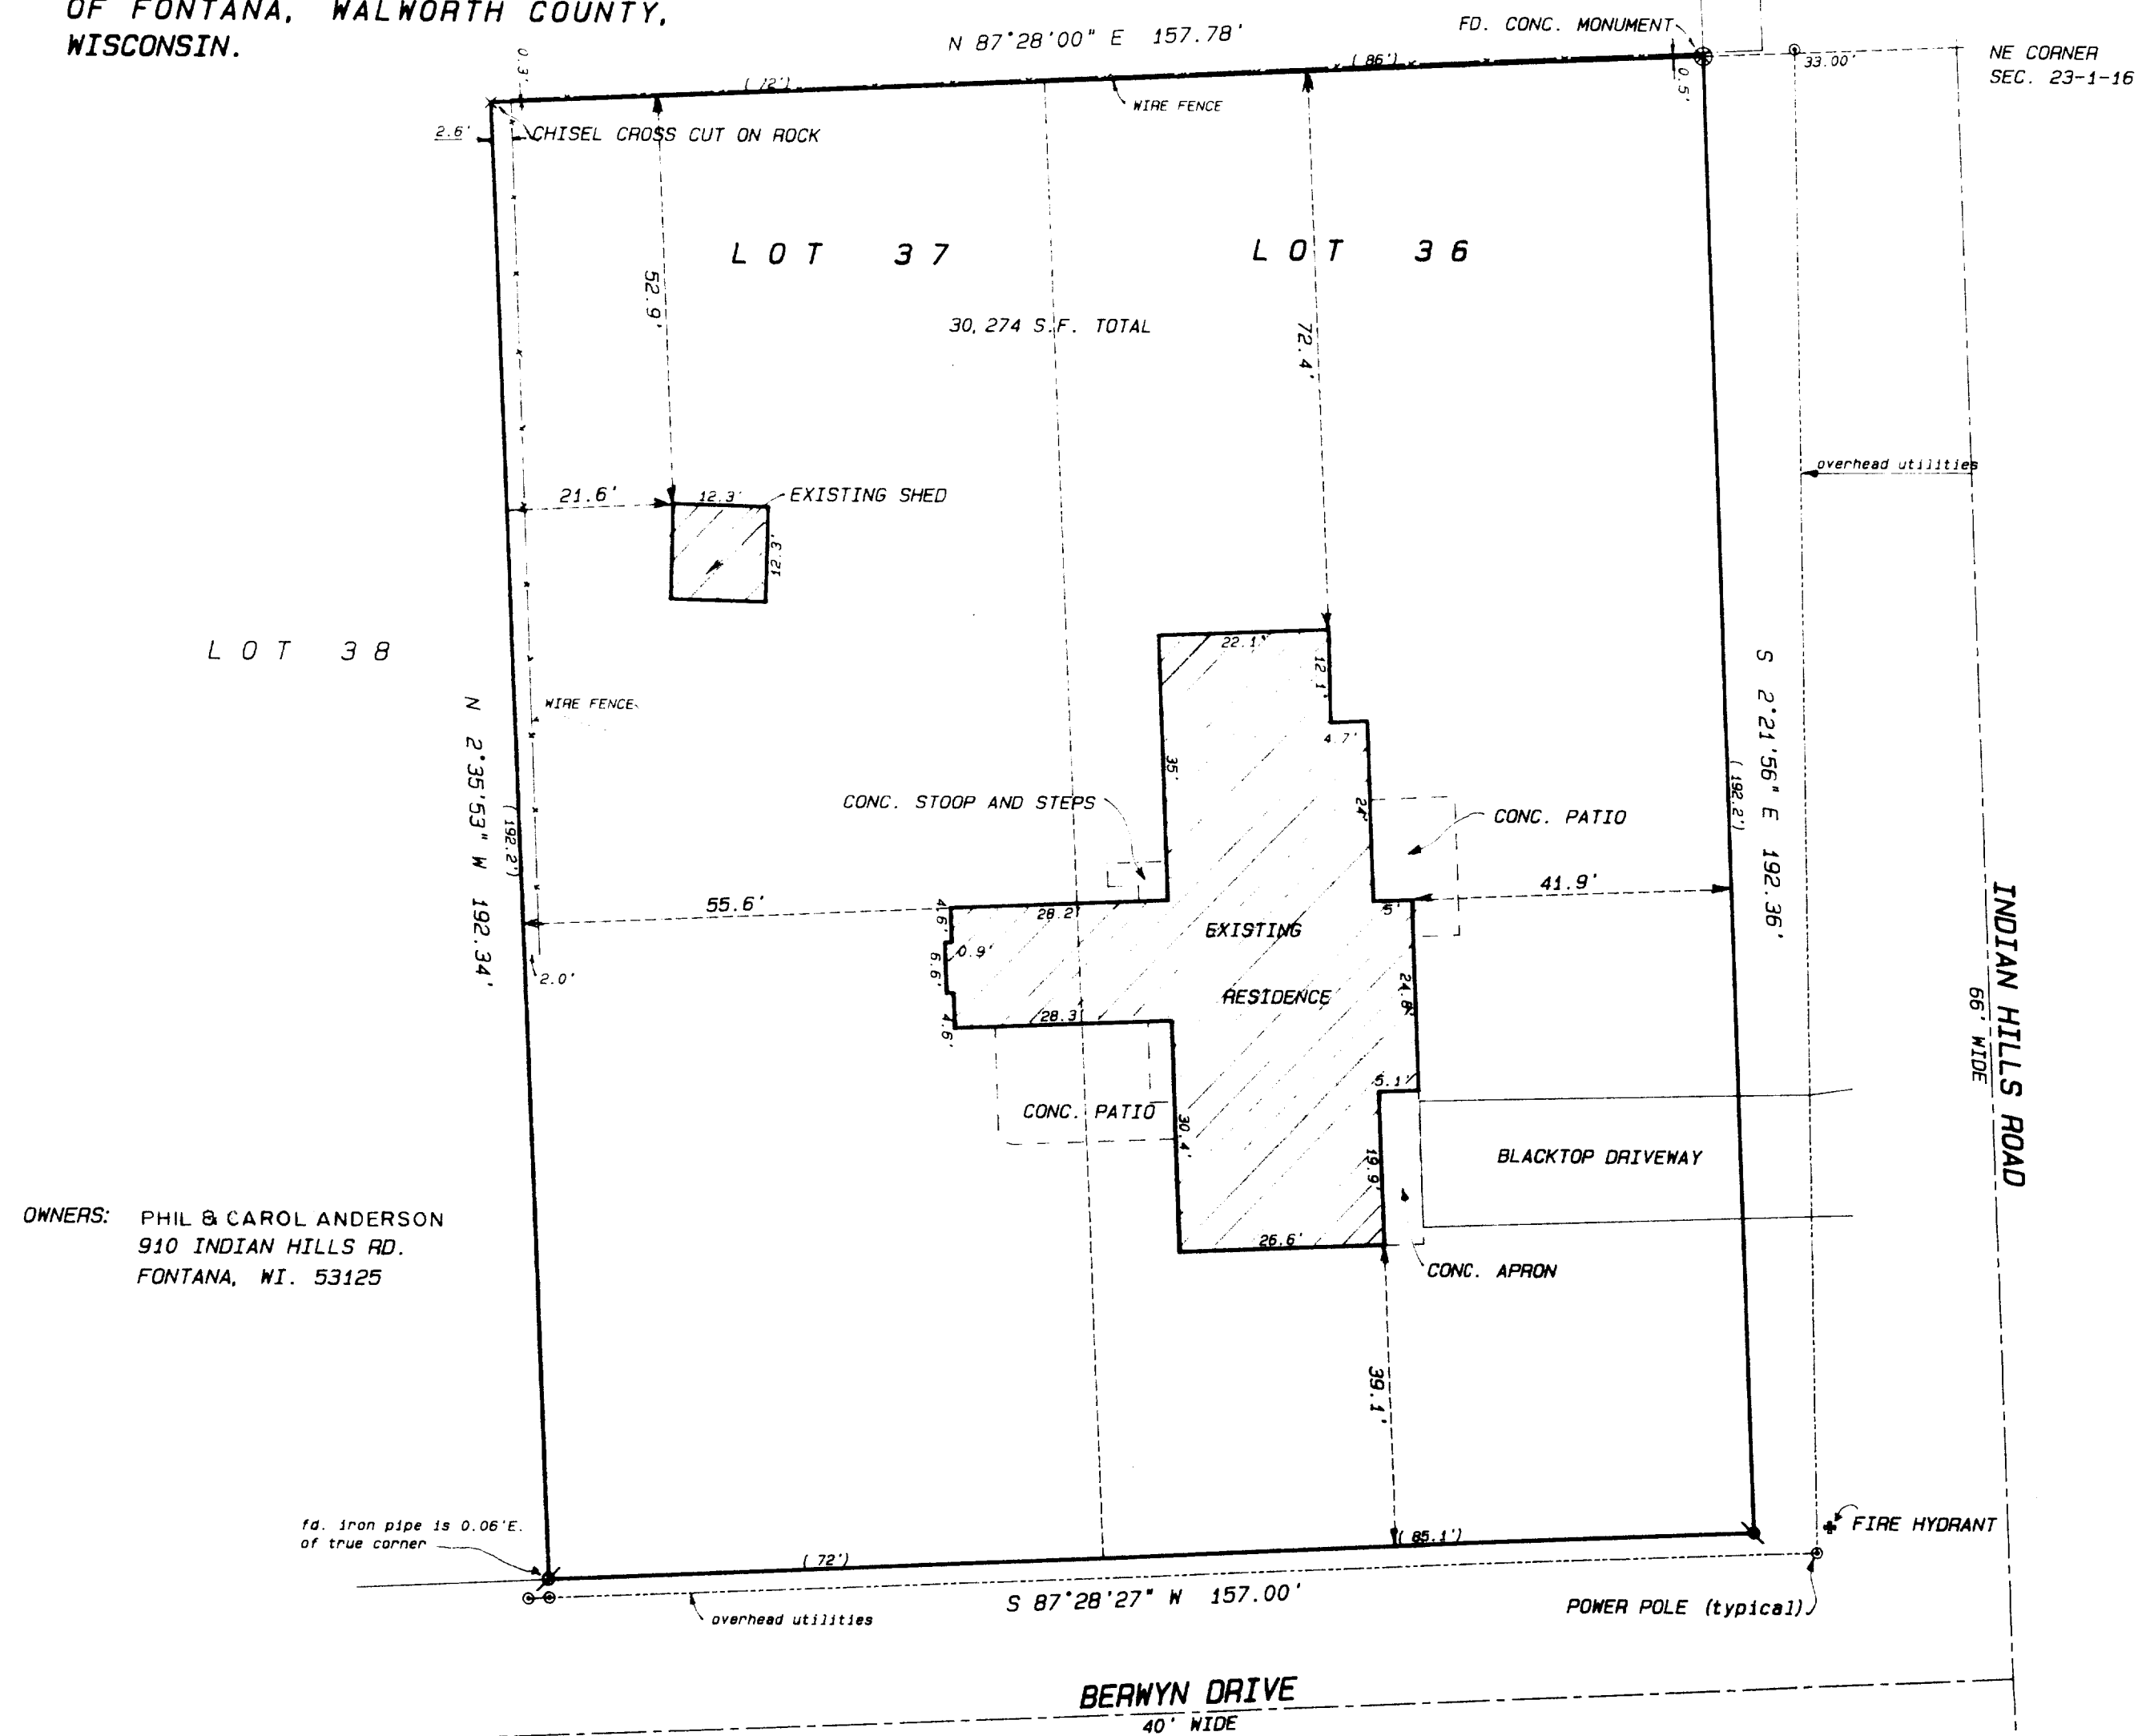


OWNERS: PHIL & CAROL ANDERSON
910 INDIAN HILLS RD.
FONTANA, WI. 53125

SCALE 1" = 20 FEET

Legend

- ✓ FOUND IRON PIPE
 - FOUND IRON ROD
 - FOUND BRASS CAPPED MONUMENT
 - * FOUND CONCRETE MONUMENT
 - + CHISEL CUT IN CONCRETE
 - SET IRON ROD, 24" LONG, WEIGHING 1.5 LBS./LINEAL FT., 3/4" DIA.
 - SET IRON ROD, 30" LONG, WEIGHING 4.5 LBS./LINEAL FT., 1-11/16" DIA.
- (xx) RECORDED AS DIMENSION
- x— EXISTING FENCE

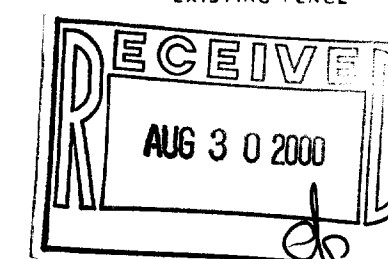

SCALE: 1" = 20 FEET



"I hereby certify that the above described property has been surveyed by me or under my direction and that the above map is a true and correct representation of the size and location of the property, its exterior boundaries, the location of all visible structures and dimensions of all principal buildings thereon, boundary fences, apparent easements, roadways and visible encroachments, if any."

one year from date hereof."

Kenneth B. Smith.

KENNETH B. ABERNATHY, JR.
WISCONSIN REGISTERED LAND SURVEYOR.
S-1594
Date: 12-10-97 Job No. 97.120

REVISÉD 7/10/'00

SCT-12 005-1841