


WORK ORDERED BY:
TOM GLOWSKI & JOHN RYAN
590 S. LAKESHORE DRIVE
LAKE GENEVA, WI. 53147

FARRIS, HANSEN & ASSOCIATES, INC.
ENGINEERING — ARCHITECTURE — SURVEYING
7 RIDGWAY COURT P.O. BOX 437
ELKHORN, WISCONSIN 53121
OFFICE: (262) 723-2098 FAX: (262) 723-5886

REVISIONS

PROJECT NO.	5388
DATE	02-21-01
SHEET NO.	1 OF 1

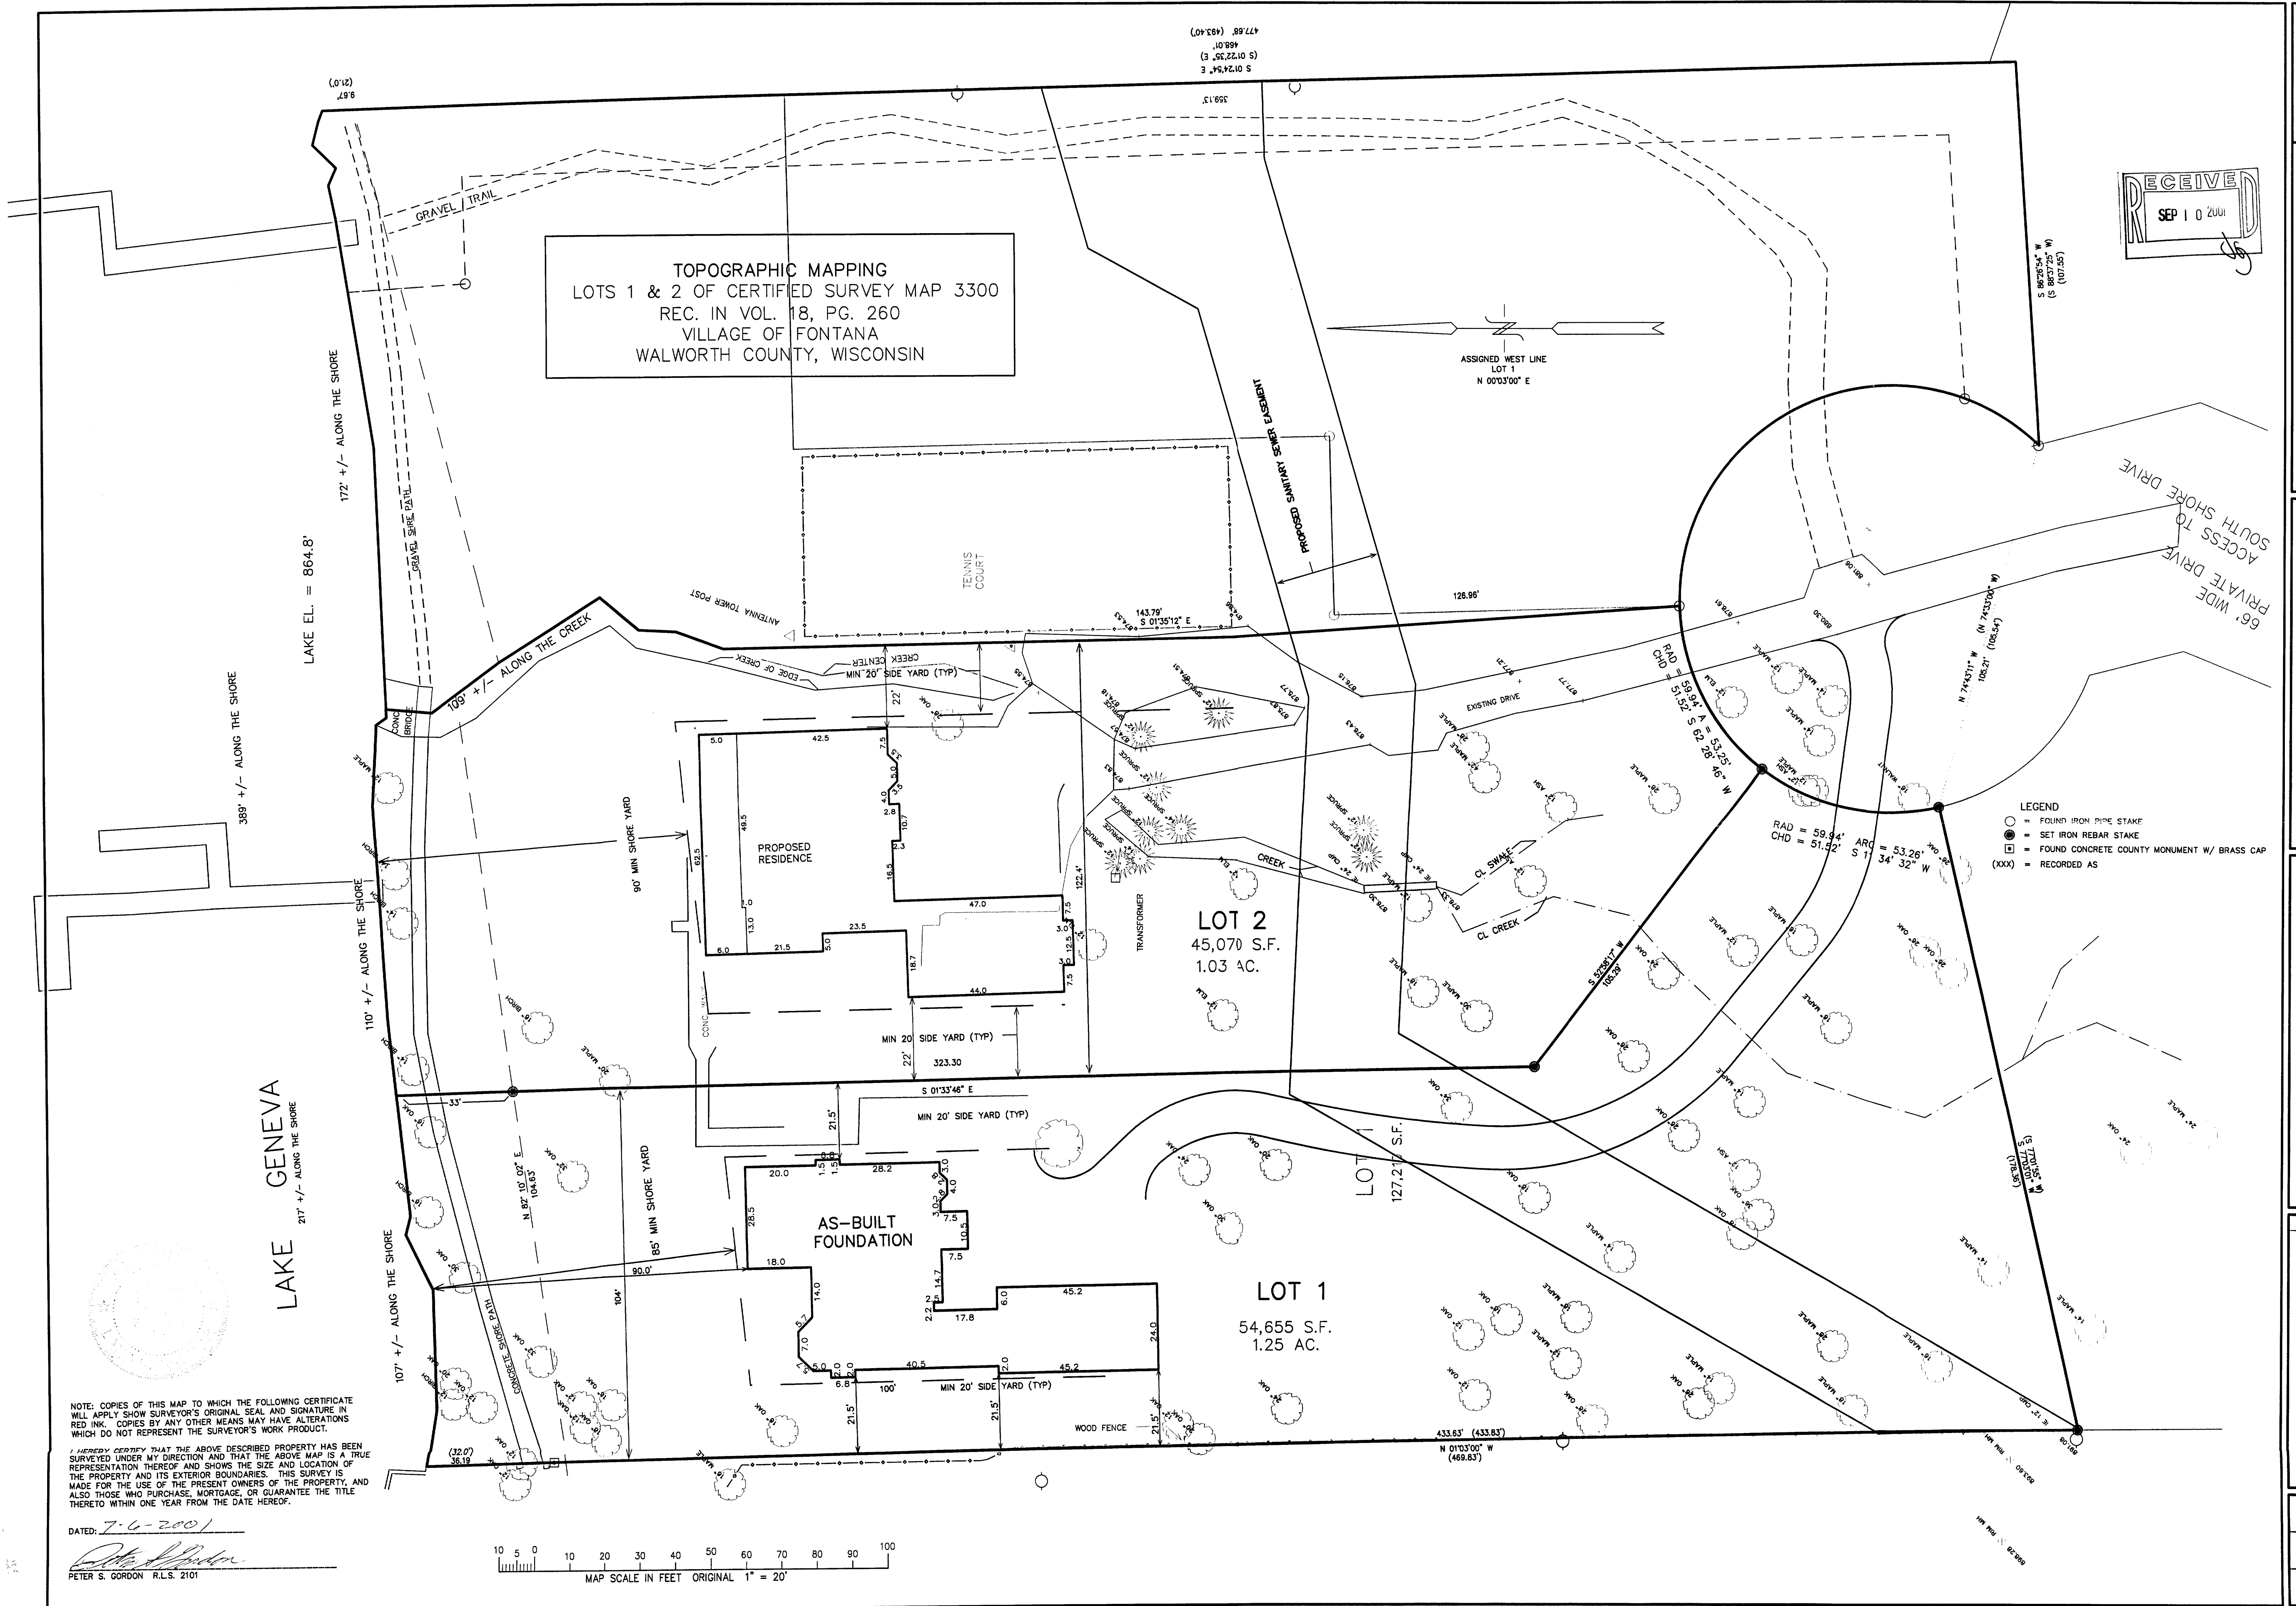

SA 3300-1
SA 3300-2