
HAROLD H. KOLB

REGISTERED PROFESSIONAL LAND SURVEYOR LAKE GENEVA, WISCONSIN

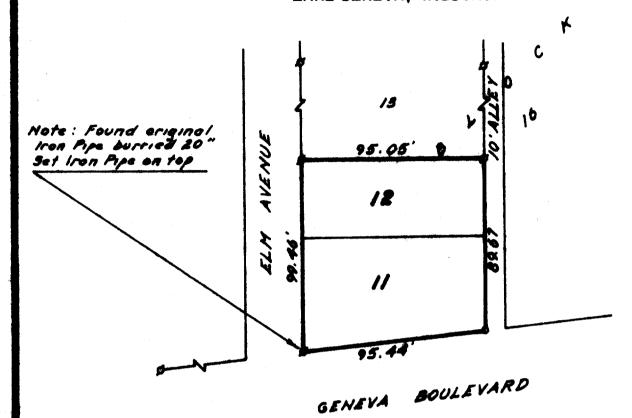

PLAT OF SURVEY OF

SCALE /"-50'
LEGEND

Ø - IRON PIPE FOUND

O - IRON PIPE PLACED

- CONCRETE MONUMENT

X - SPIKE

Lots II and 12, Block 16, Glenwood Springs Subdivision, located in Section 14, T I N, R 16 E, Village of Fontana-on-Geneva Lake, Walworth County, Wisconsin.

I, HAROLD H, KOLB, DO HEREBY CERTIFY THAT I HAVE SURVEYED THE PROPERTY HEREON DESCRIBED ACCORDING TO THE OFFICIAL RECORDS, AND THAT THE PLAT HEREON IS A CORRECT REPRESENTATION OF THE LOT LINES.

HAROLD H. KOLB WISCONSIN REGISTERED LAND SURVEYOR, S-187 DATE ACT 1 23 1966

56-5-118 1184

5-194

FAN-42