

ABERNATHY and ASSOCIATES


Kenneth B. Abernathy Jr.

Wisconsin Registered Land Surveyor S-1594

W4056 BRAY RD.
ELKHORN, WI. 53121
PHONE: (262) 723-4260 (OFFICE)
(262) 723-7209 (FAX)
Email: abernathy@elknet.net

PLAT OF SURVEY


LOT 1 OF BLOCK 1 OF INDIAN HILLS FIRST
ADDITION, LOCATED IN SECTION 14, TOWN 1
NORTH, RANGE 16 EAST, VILLAGE OF
FONTANA, WALWORTH COUNTY, WISCONSIN.

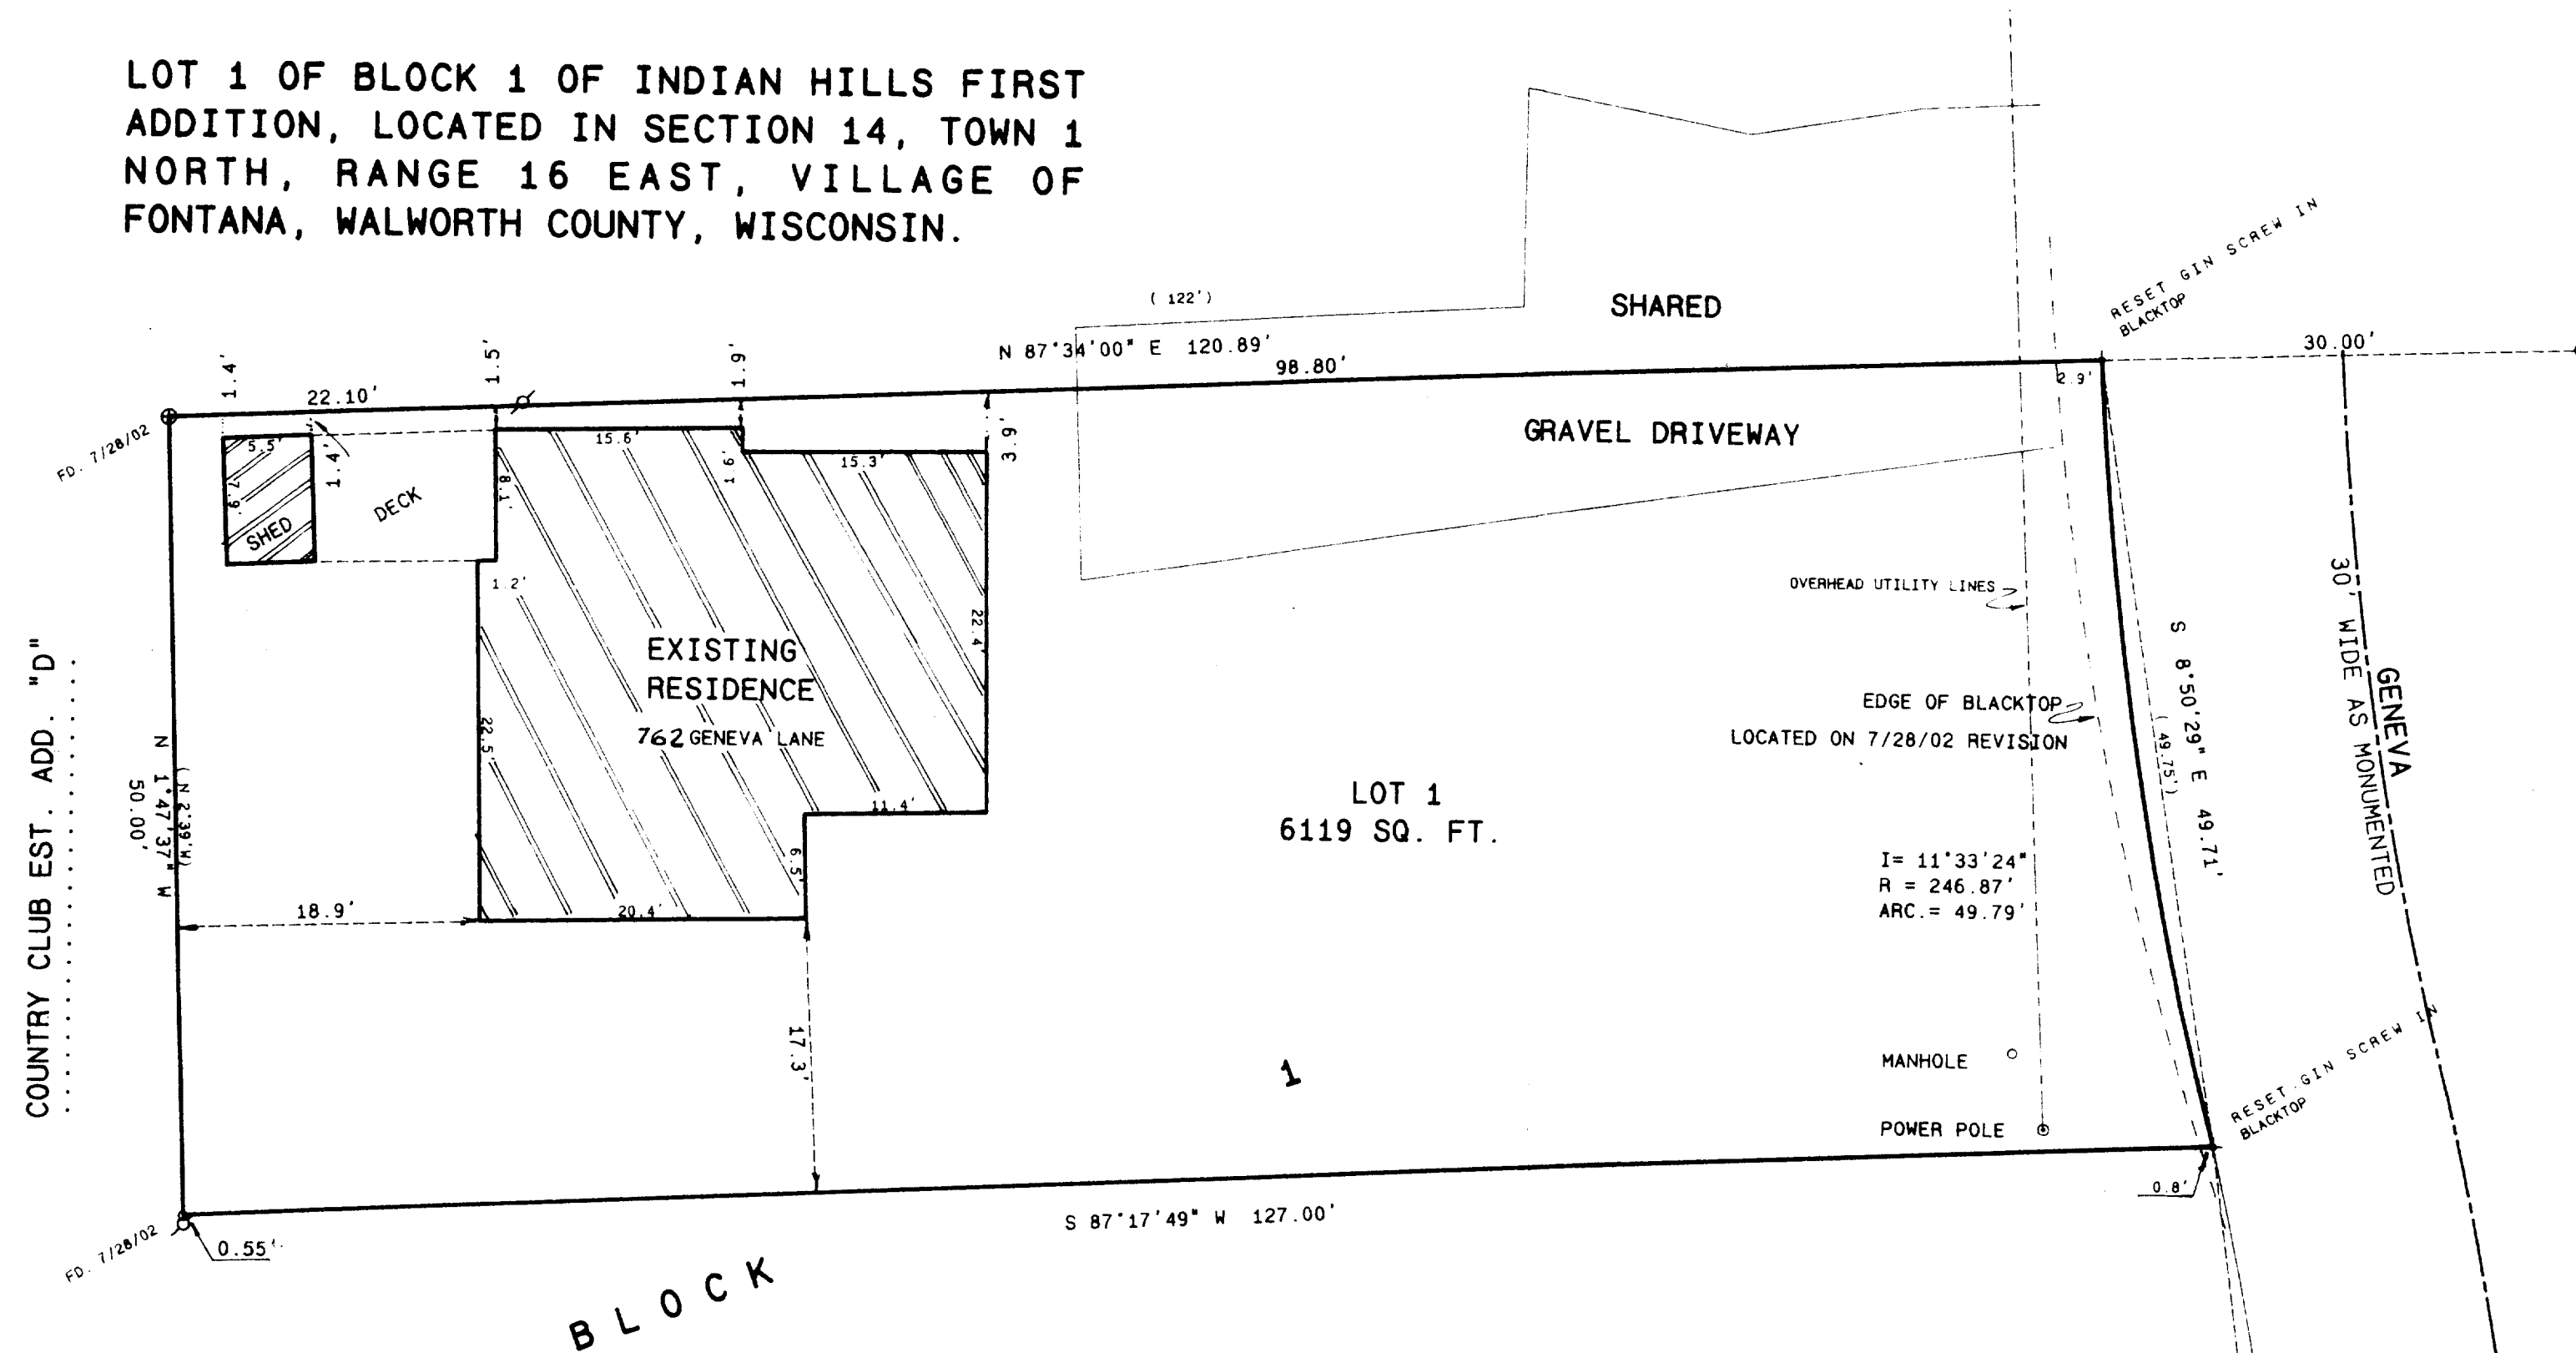

ORDERED BY: KEEFE REAL ESTATE
C/O MIKE BUTTLEMAN
P.O. BOX 460
LAKE GENEVA, WI. 53147

SELLER: STUART H. AND WILLIAM J. GALESBURG
BUYER: LUCIA McMILLIN

NOTE:
SUBJECT TO ANY EASEMENTS RECORDED OR UNRECORDED

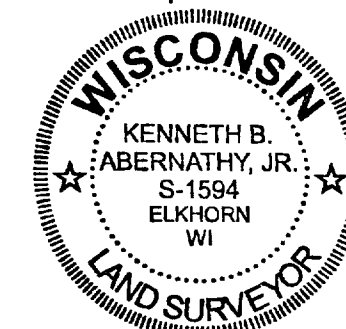

REVISED 10/4/94

REVISED AND RECERTIFIED
7/28/02

I hereby certify that the above described property has been surveyed
by me or under my direction and that the above map is a true
representation thereof and shows the size and location of the property
its exterior boundaries, the location of all visible structures and
dimensions of all principal buildings thereon, boundary fences, apparent
easements, roadways and visible encroachments, if any.
This survey is made for the use of the present owners of the property,
and also those who purchase, mortgage, or guarantee the title thereto
within one year from date hereof.

Kenneth B. Abernathy, Jr.
KENNETH B. ABERNATHY, JR.
WISCONSIN REGISTERED LAND SURVEYOR,
S-1594
Date: 9/29/94 Job No. 94916

005-1990