ABELL SURVEYING & MAPPING

1140 SEQUOTA STREET • DELAVAN, WISCONSIN 53115 262-728-6737






SCALE | " = 20 "

LEGEND

PLAT OF SURVEY OF

LOT 12, BLOCK "H", UNIT-3, COUNTRY CLUB ESTATES, LOCATED IN THE VILLAGE OF FONTANA-ON-GENEVA LAKE, WALWORTH COUNTY, WISCONSIN.



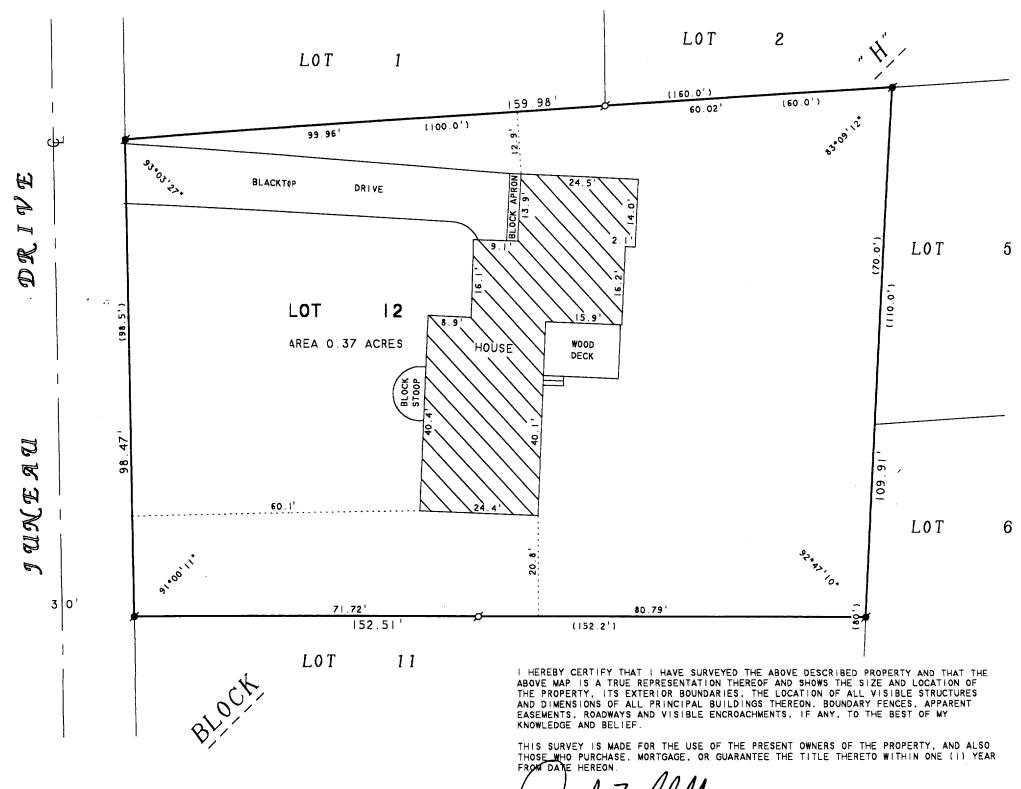

ORDERED BY: FLETCHER OPITZ

430 OAKLAND LANE ELKHORN, WI 53121 Lail 7. Chill

DAVID F. ABELL WISCONSIN REGISTERED LAND SURVEYOR, S-1596

July 1, 2002

DATE JOB NUMBER - 02095 NOTE: THIS IS NOT A CERTIFIED COPY UNLESS SEALED.