


DUNHAM SURVEYING, S.C.
SURVEYING & SUBDIVIDING
DELAVER, WISCONSIN 53115

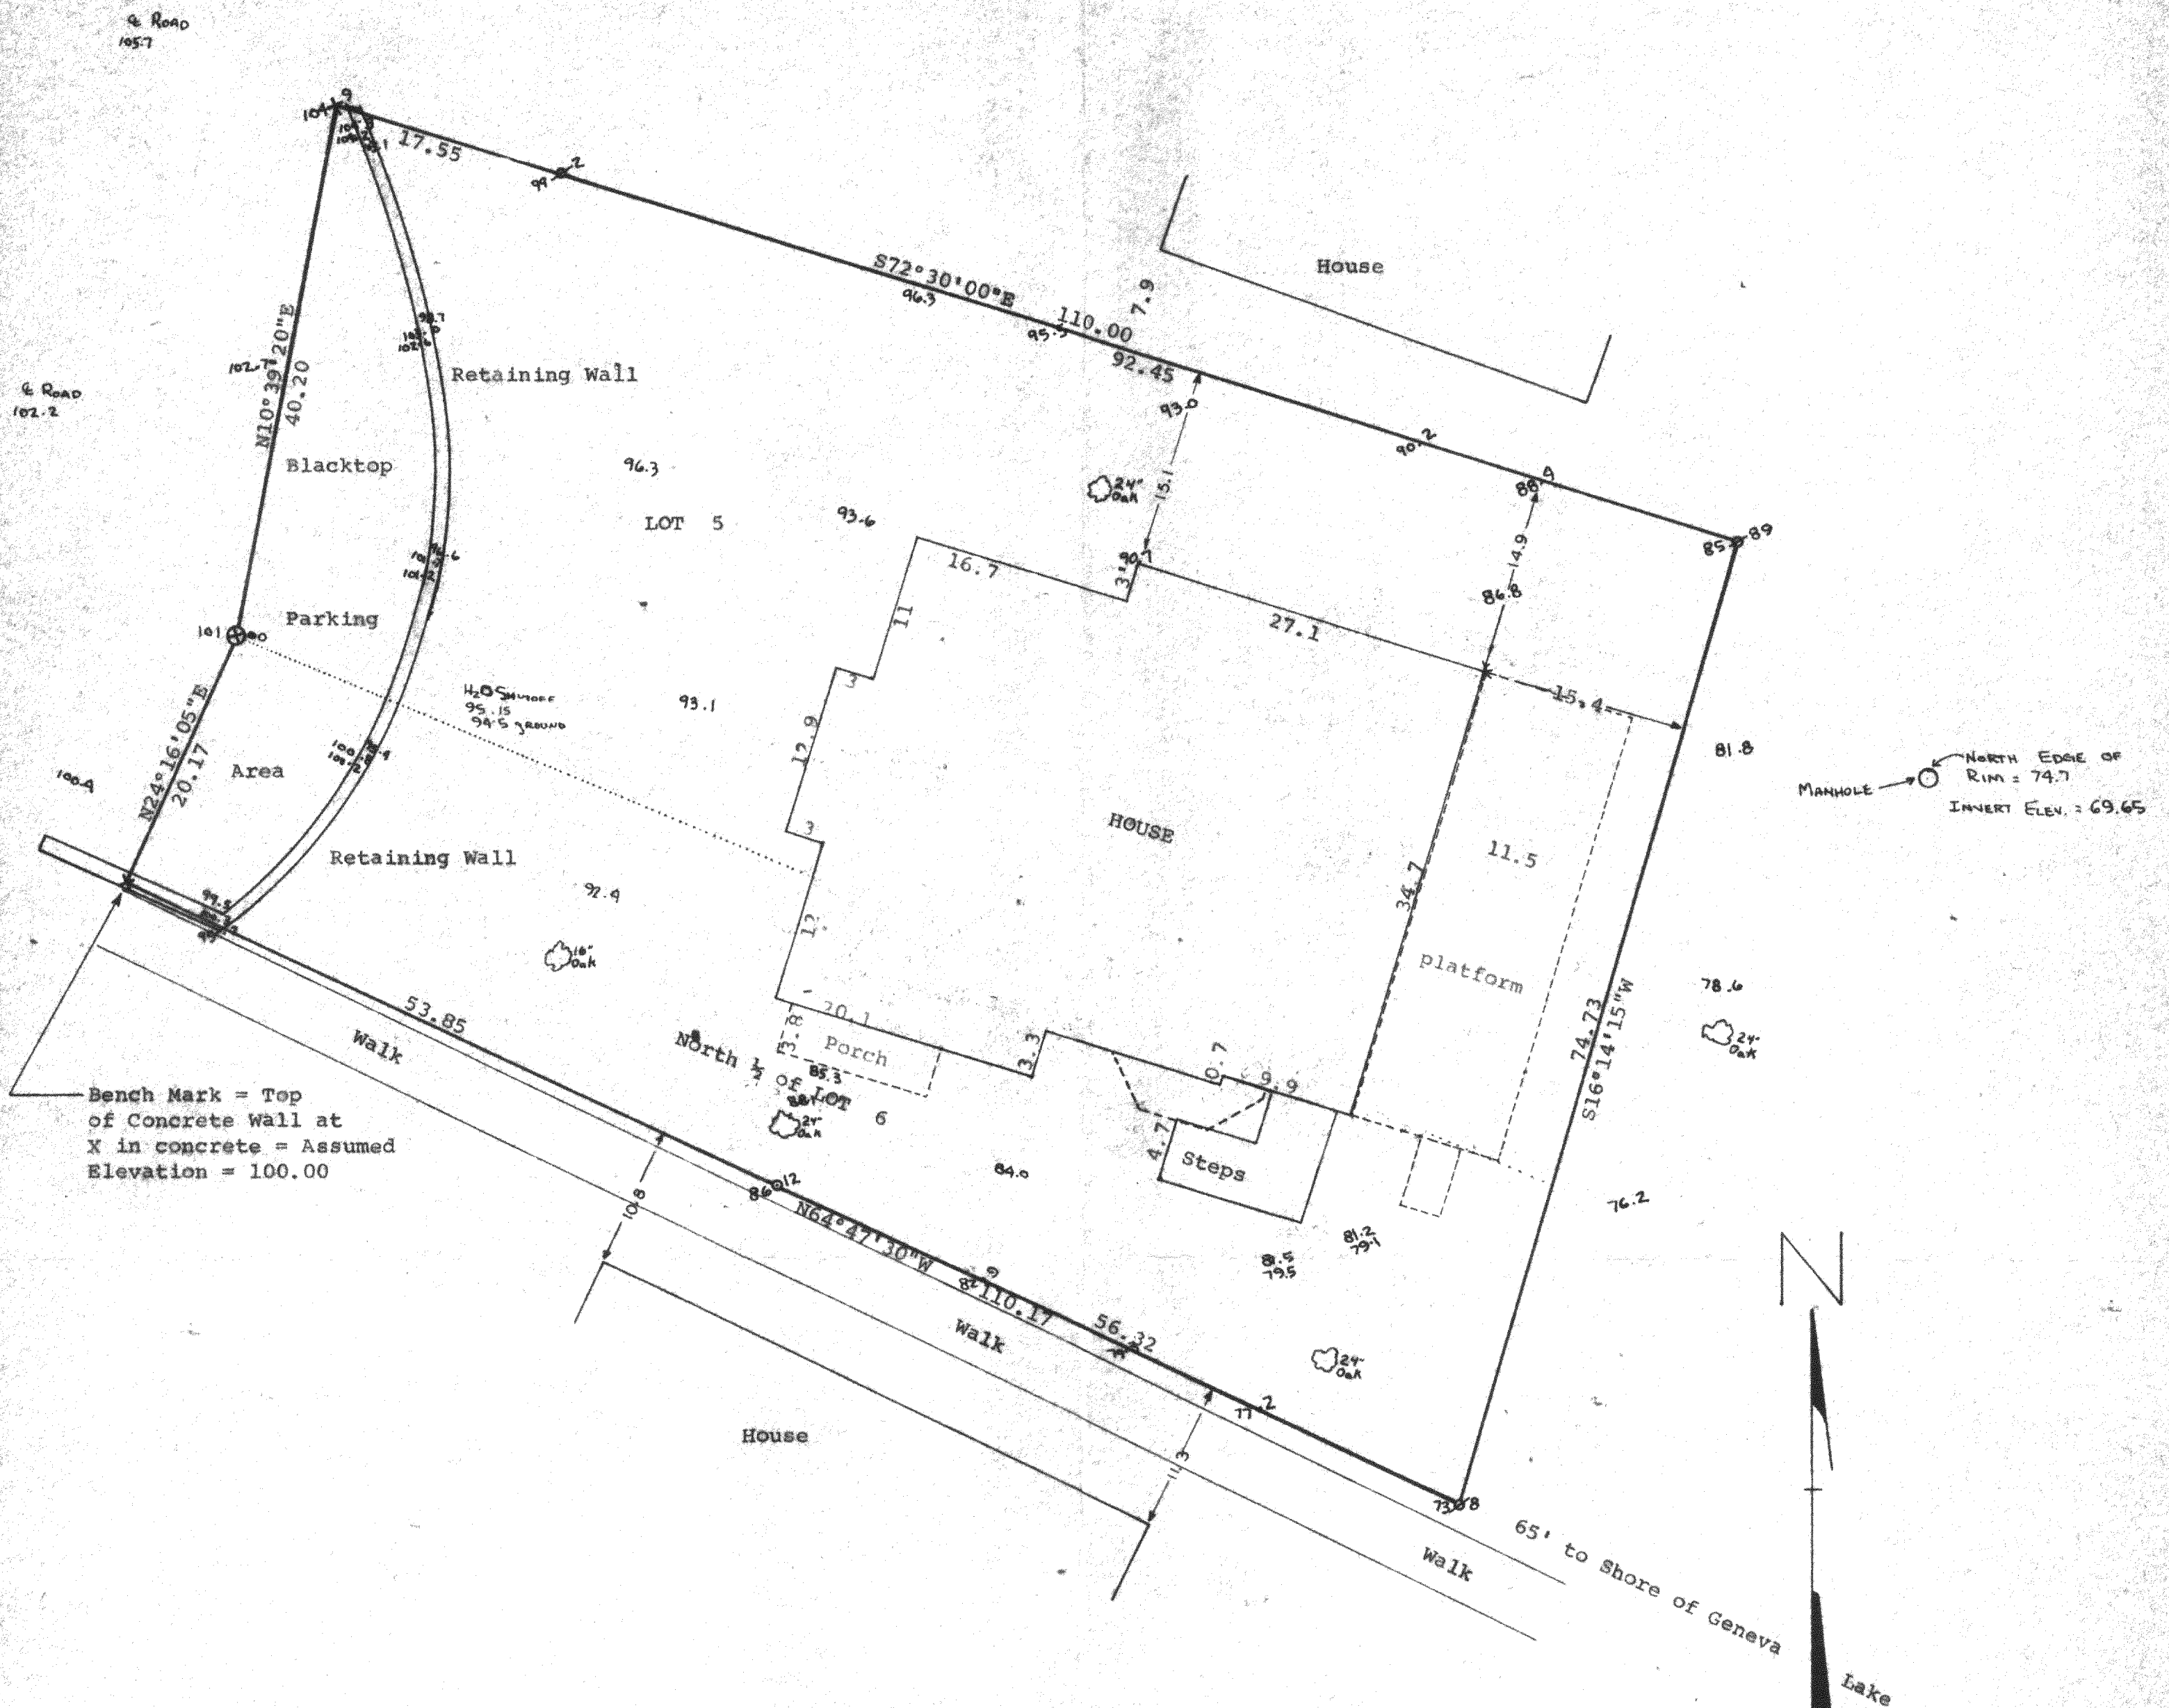

STATE OF WISCONSIN)
COUNTY OF WALWORTH) SS

I, George T. Dunham, Surveyor, certify that I have surveyed the property described as follows,

Lot 5 and the North 1/2 of Lot 6 of Buena Vista, a subdivision located in the Village of Fontana-on-Geneva Lake, Walworth County, Wisconsin,

and that the above map is a true representation thereof and shows the size and location of the property, its exterior boundaries, the location of all visible structures and dimensions of all principal buildings thereon, boundary fences, apparent easements, roadways and visible encroachments, if any. This survey is made for the use of the present owners of the property, and also those who purchase, mortgage, or guarantee the title thereto within one (1) year from date hereof.

December 14, 1981

Updated and recertified to this 17th day of October, 1996

All survey markers relocated

George T. Dunham
George T. Dunham, Surveyor

Scale - 1" = 10'

⊙ = Iron Pipe Found

○ = Iron Pipe Set

⊗ = Spike

× = Cross in Concrete

Survey ordered by: Gerald Tuite
282 Sylvan
Fontana, WI 53125

